


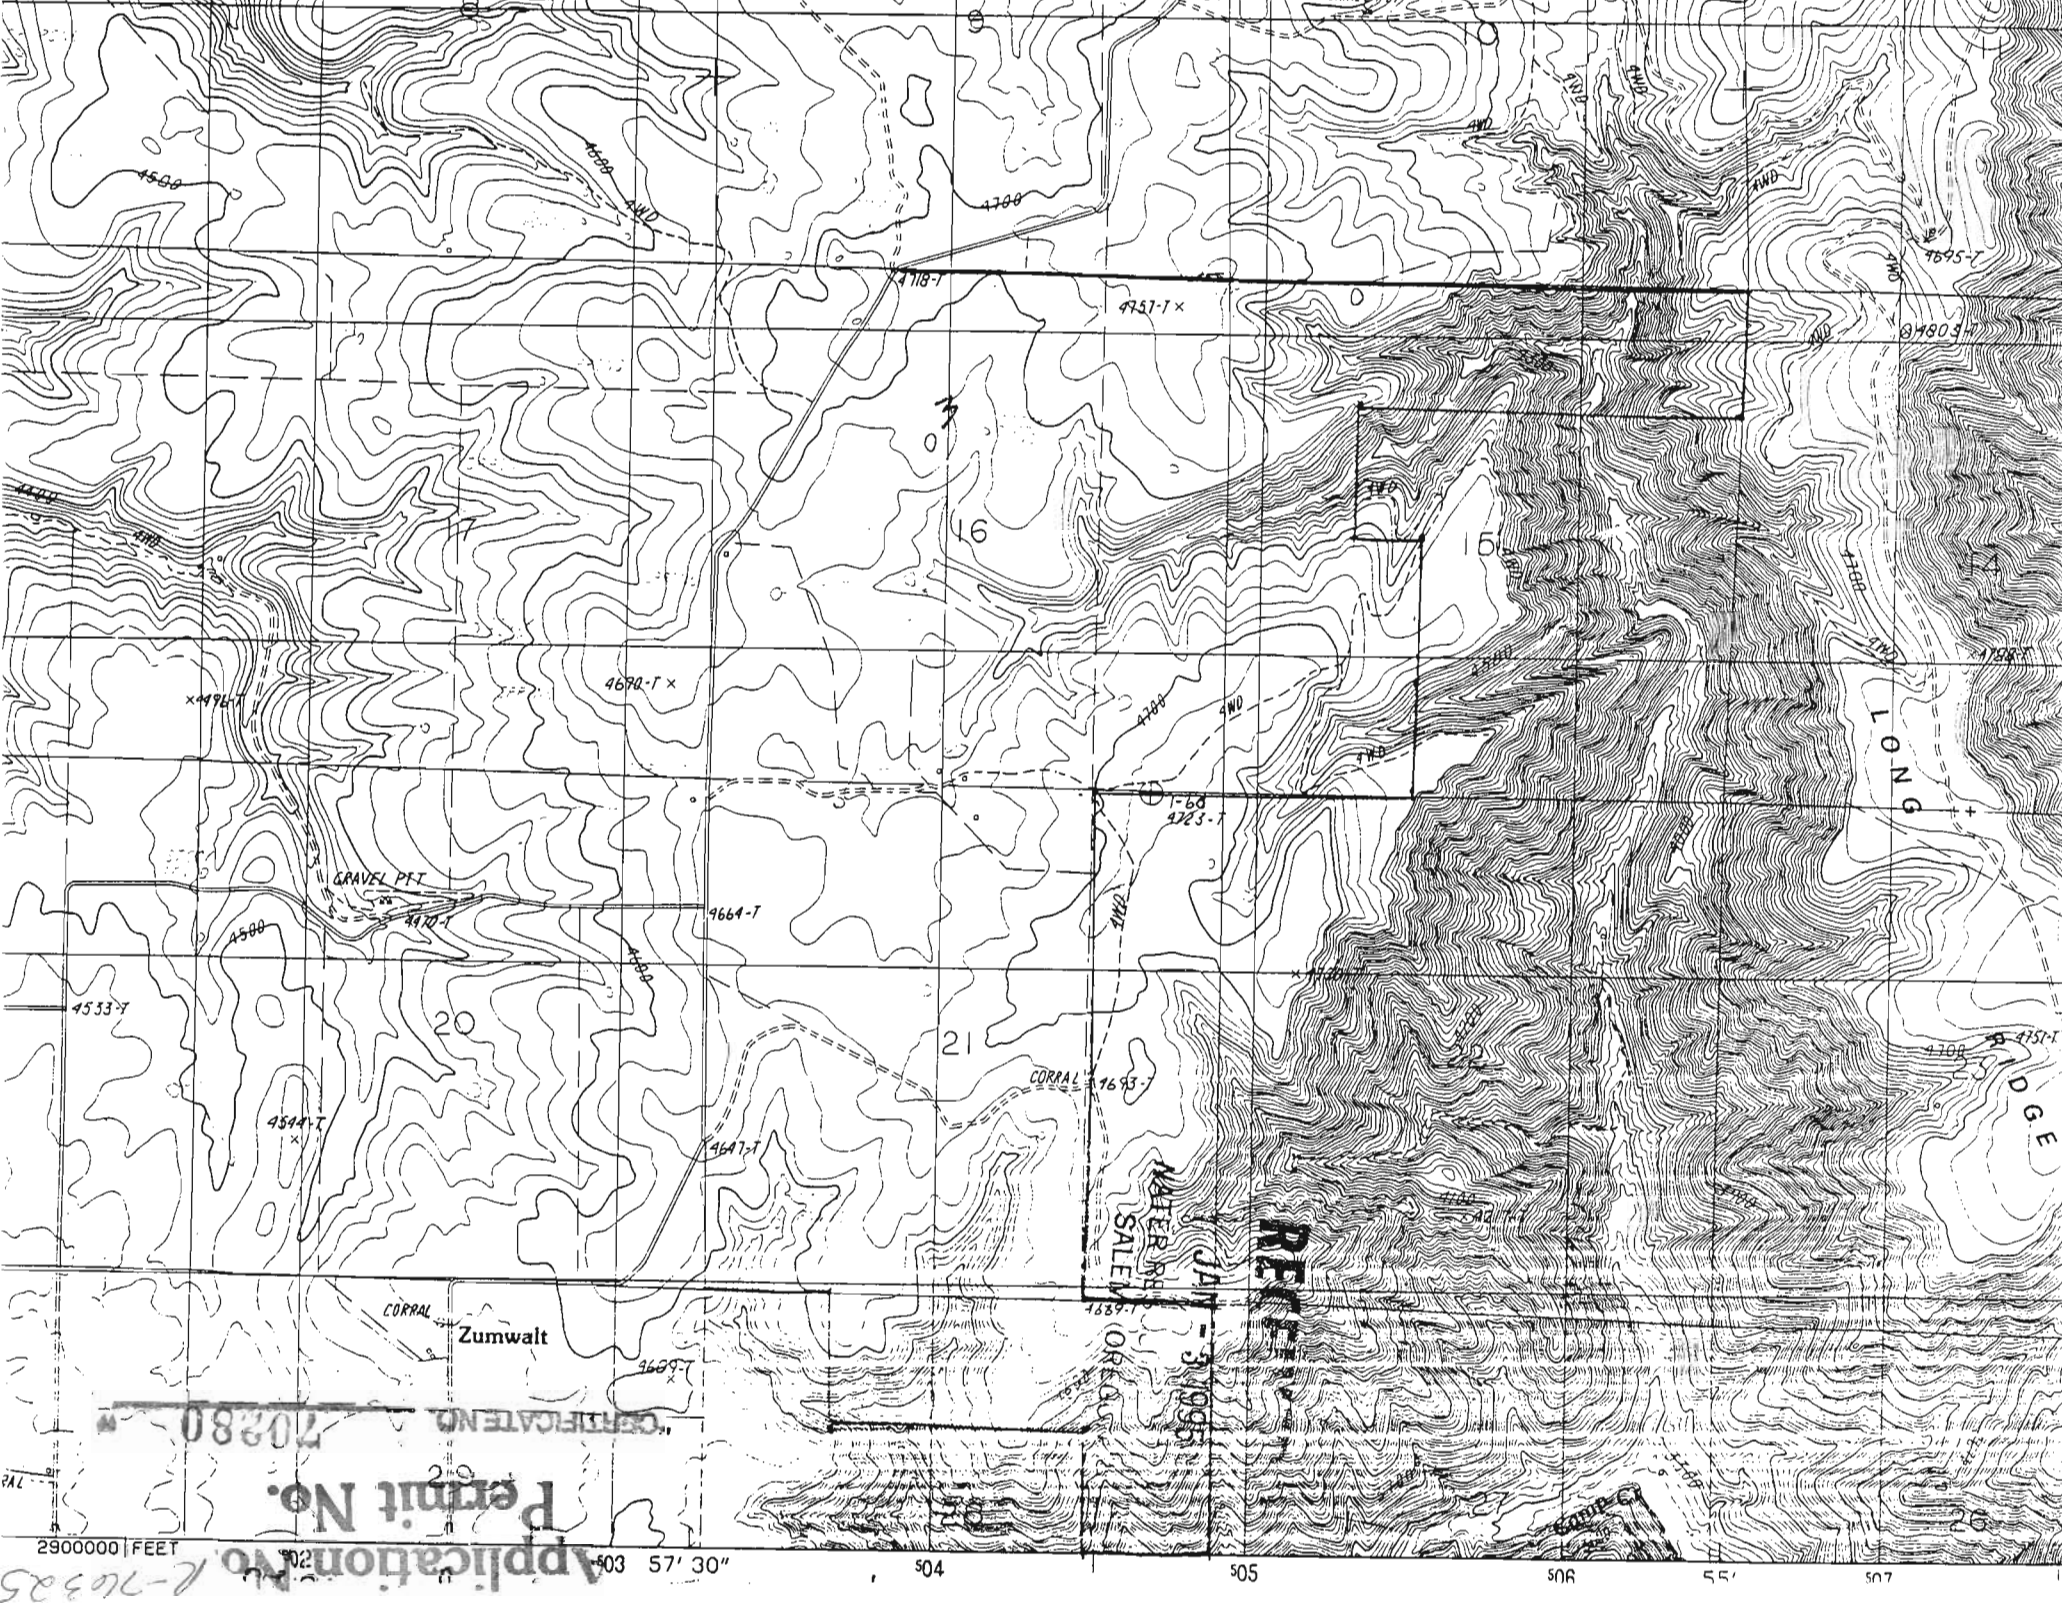

Application No. 2-76325


2900000 FEET

02 03 57' 30"

04 05 06 07 55' 57

ZUMWALT QUADRANGLE
OREGON-WALLOWA CO.
7.5 MINUTE SERIES (TOPOGRAPHIC)

100 7455

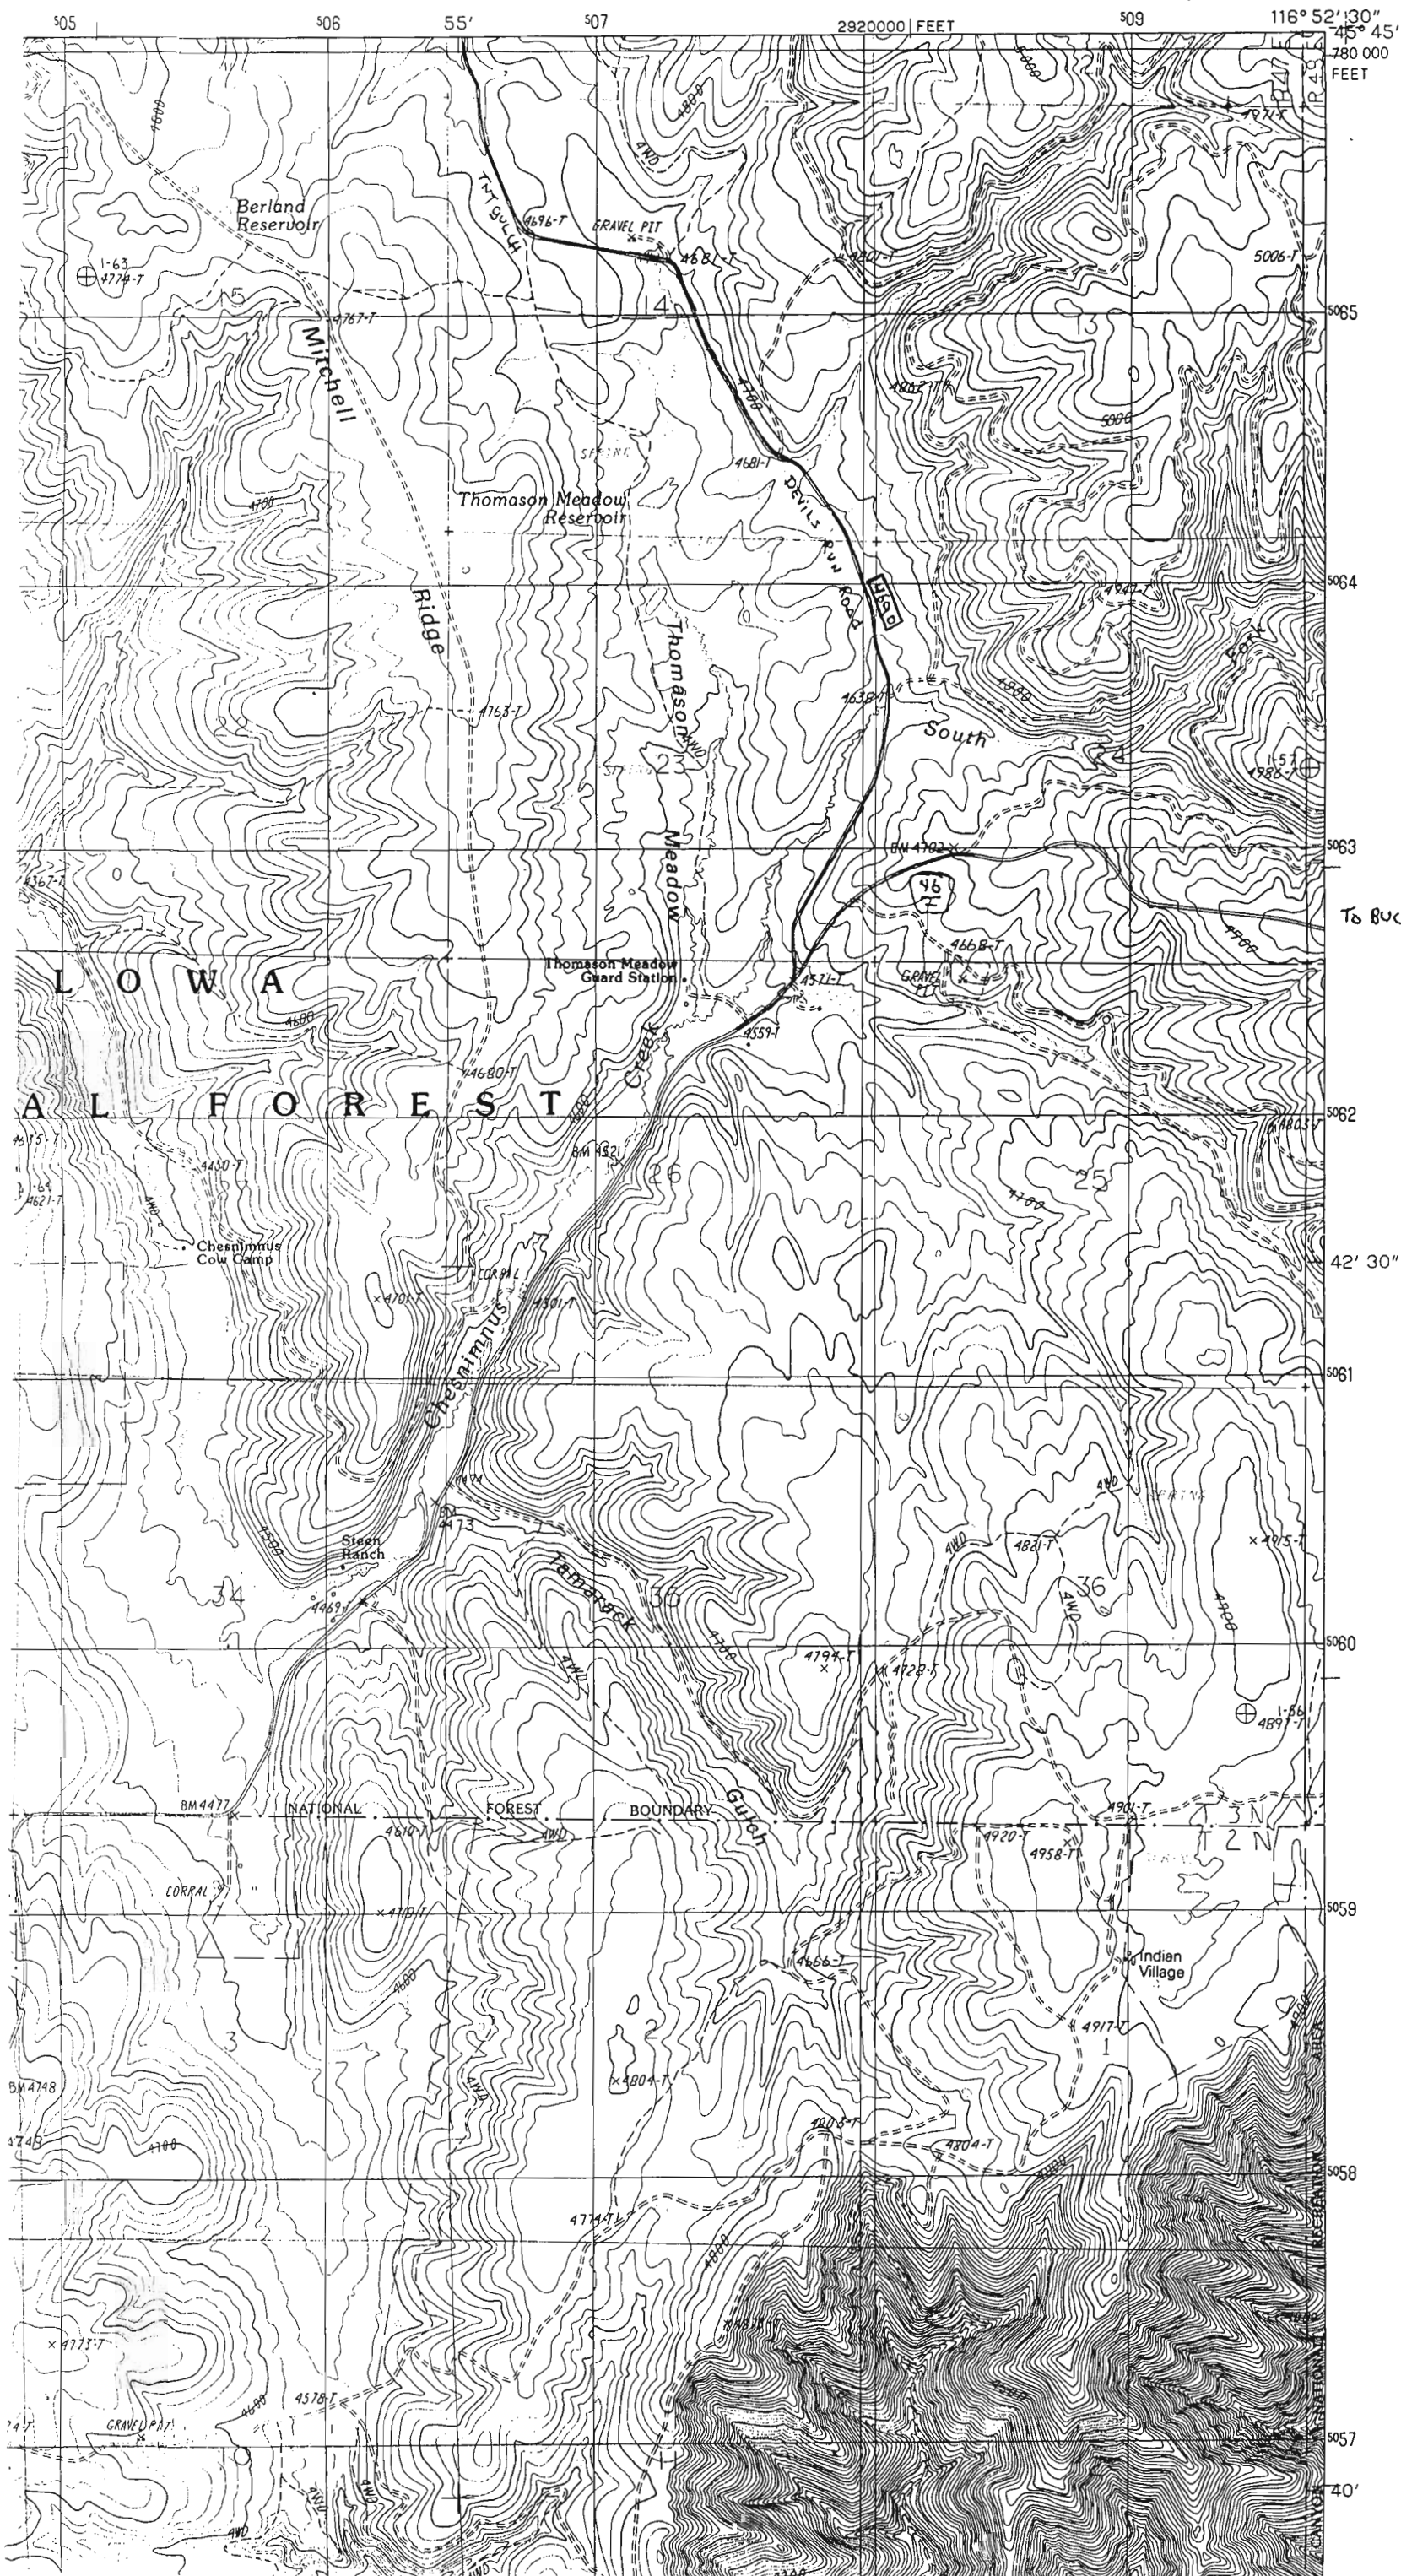


Application No. R-70325
Permit No.

CERTIFICATE NO. 70280

Application No. K-70280
Permit No. 70280
"CERTIFICATE NO."


Application No. K-70280
Permit No. 70280

Job
64

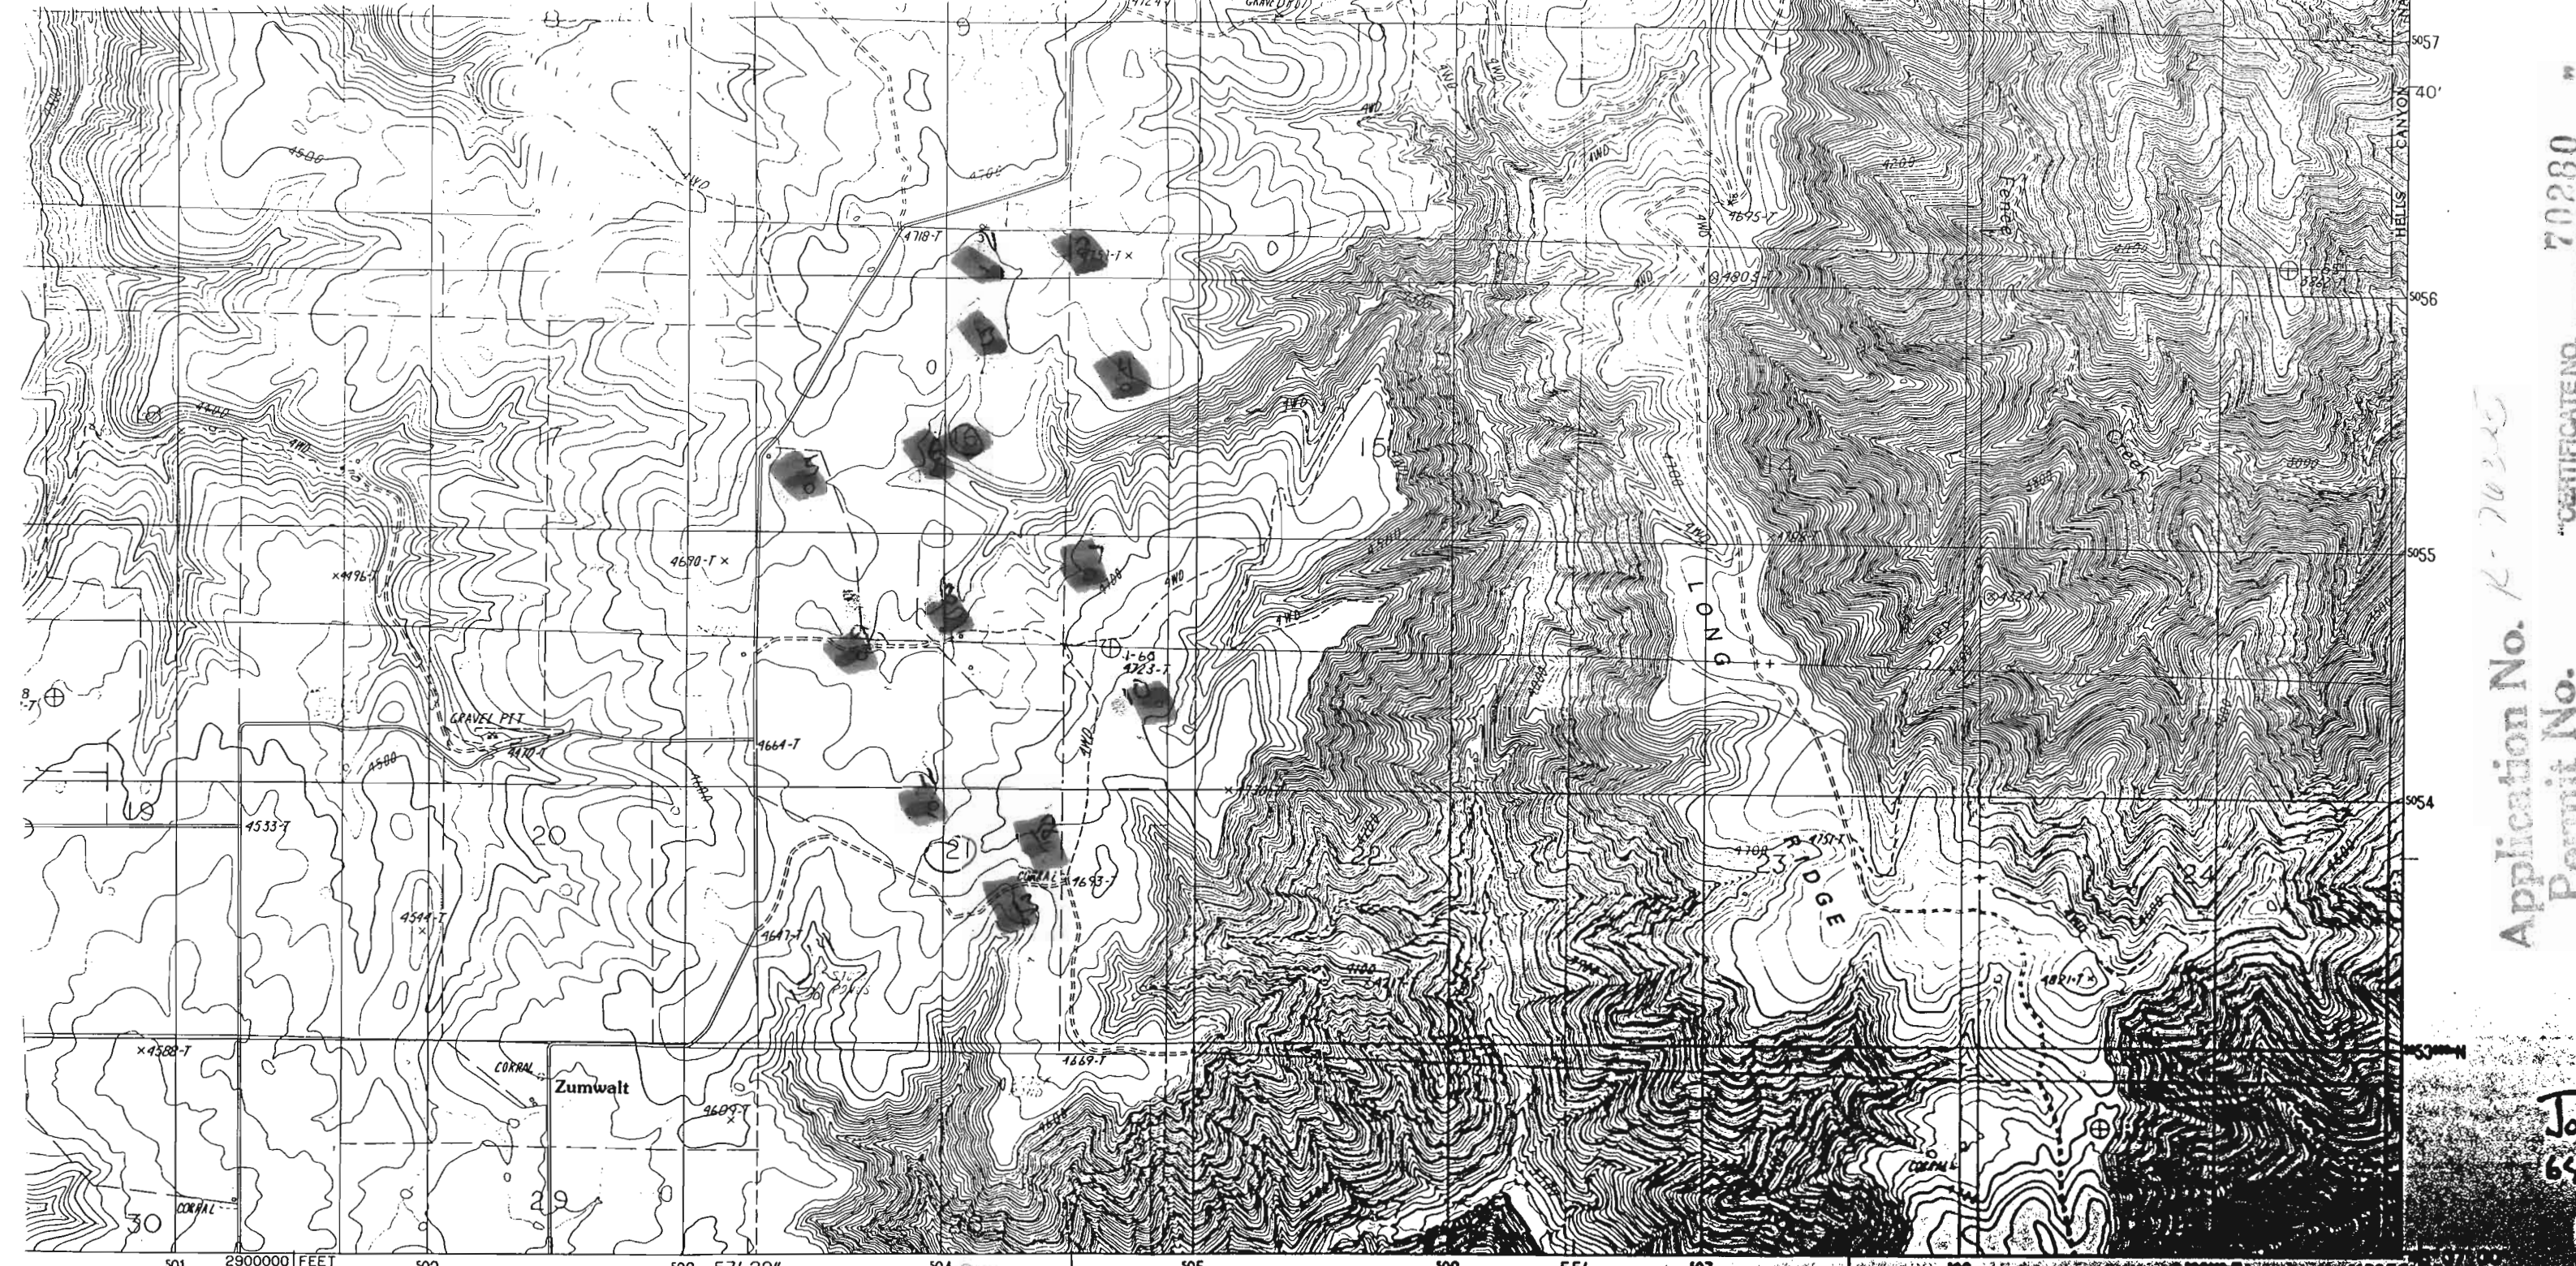

UNITED STATES GEOLOGICAL SURVEY
USGS AND NOS/NOAA
PHOTOGRAPHS TAKEN.....1984
.....1987. MAP EDITED.....1990
.....LAMBERT CONFORMAL CONIC
RSAL TRANSVERSE MERCATOR.....ZONE 11
GRID TICKS.....OREGON, NORTH ZONE
.....0°03' EAST
ECLINATION.....17°30' EAST
ATIONAL GEODETIC VERTICAL DATUM OF 1929
.....1927 NORTH AMERICAN DATUM
icted North American Datum of 1983,
lines as shown by dashed corner ticks
meters east)
inholdings within the boundaries of any
ions shown on this map
omitted because of insufficient data

PROVISIONAL MAP
Produced from original
manuscript drawings. Infor-
mation shown as of date of
field check.

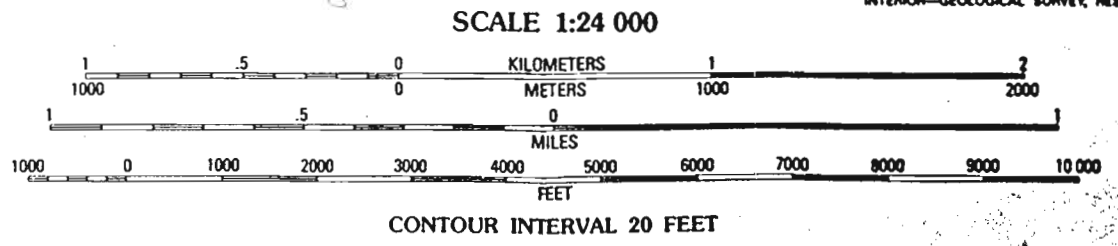

THIS MAP COMPLIES WITH NATIONAL MAP ACCURACY STANDARDS
FOR SALE BY U. S. GEOLOGICAL SURVEY
DENVER, COLORADO 80225, OR RESTON, VIRGINIA 22092

QUADRANGLE LOCATION

ROAD LEGEND

Improved Road
Unimproved Road
Trail

Interstate Route U.S. Route State Route

1	2	3
4		5
6	7	8

1 Billy Meadows
2 Poleon Point
3 Deadhorse Ridge
4 Greenwood Butte
5 Haas Hollow
6 Elk Mountain SE
7 Findley Buttes
8 Imnaha

ADJOINING 7.5' QUADRANGLE NAMES

ZUMWALT, OREGON
PROVISIONAL EDITION 1990
45116-F8-TF-024