


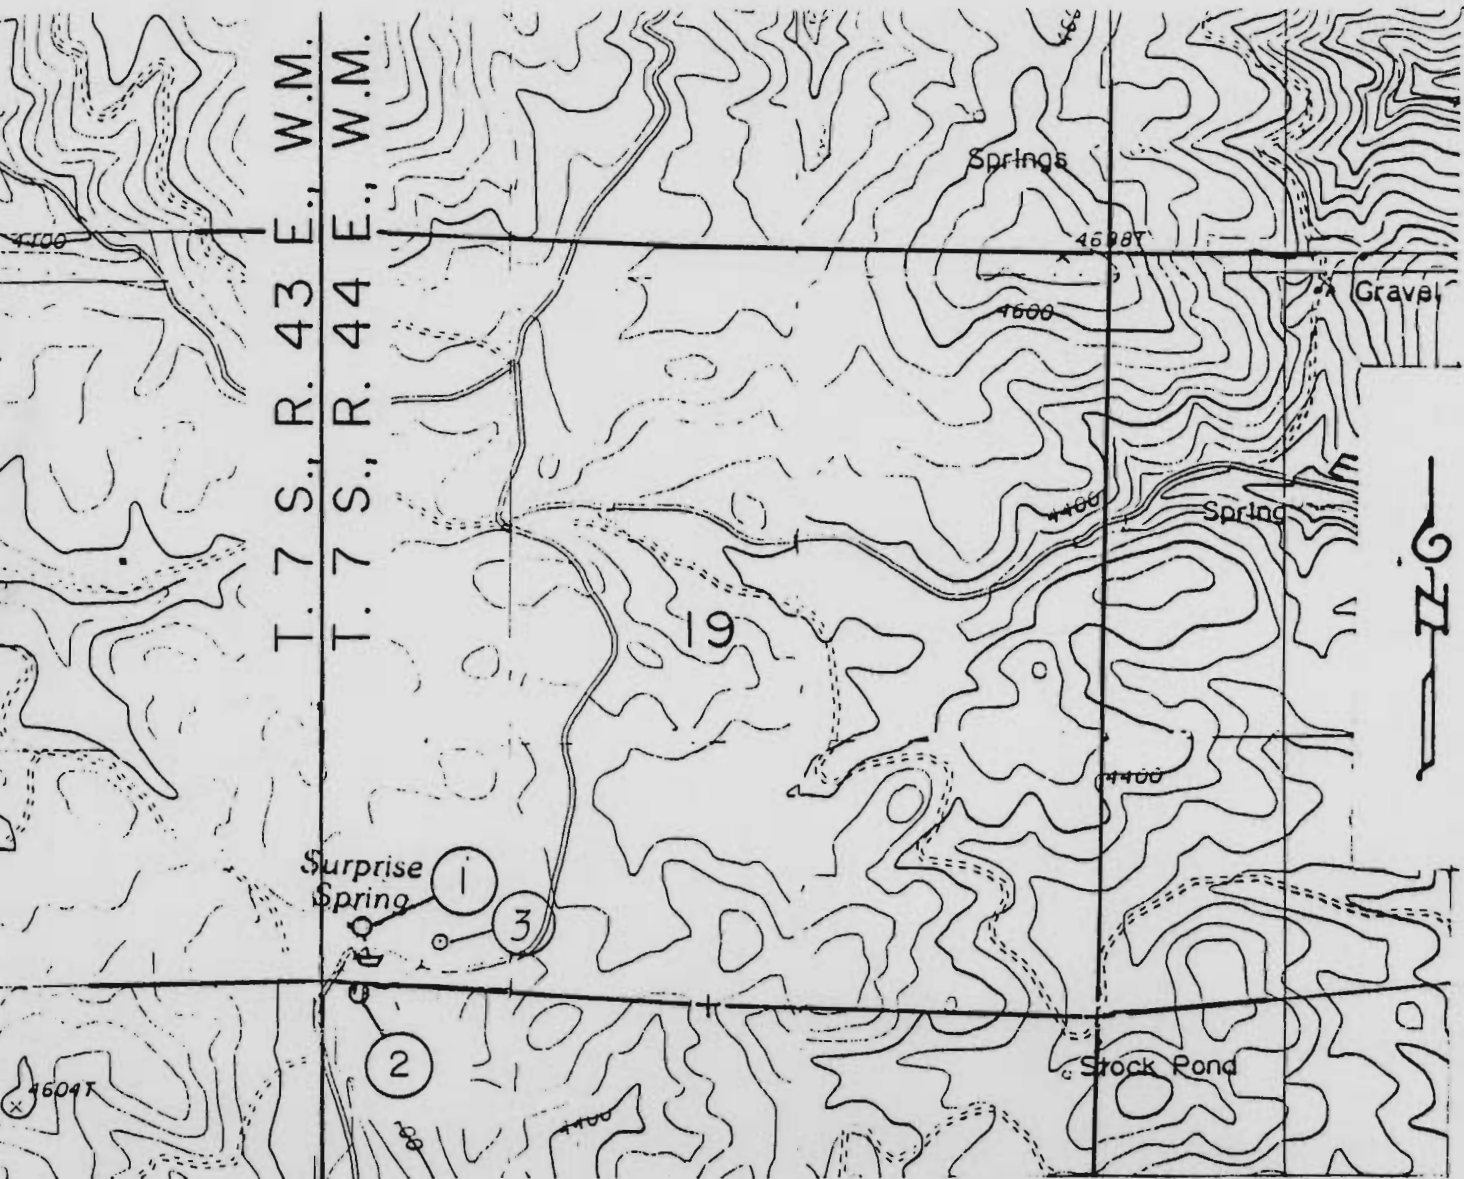

Scale 1" = 1320'

MAP TO ACCOMPANY
APPLICATION FOR PERMIT
TO APPROPRIATE WATER

RECEIVED

DEC 16 1994


WATER RESOURCES DEPT.
SALEM, OREGON

RECEIVED

JAN - 3 1995

WATER RESOURCES DEPT.
SALEM, OREGON

- ① Spring is located 400' North and 250' East of the SW Corner of Section 19.
- ② Dug pond is located 50' South and 250' East of the SW Corner of Section 19.
- ③ Dug pond 270' North and 800' East of SW corner of Section 19.

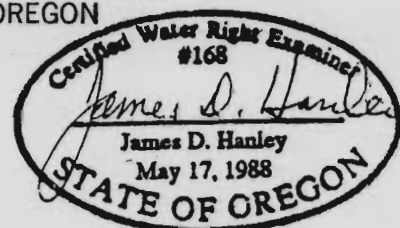

Applicant: Barry and Delores Williams

CERTIFICATE NO.

70288

Application No. R-763

Permit No.