

DEPARTMENT OF THE INTERIOR
GEOLOGICAL SURVEY

T 17 S R 20 E Section 9 SW SW

RECEIVED DEC 30 1994

0° 22' 30"

711000mE

712

713

20'

714

T 17 S R 20 E sec 9

Drake Butte Quad. 1990


000mN

4887

4886

4885

5'

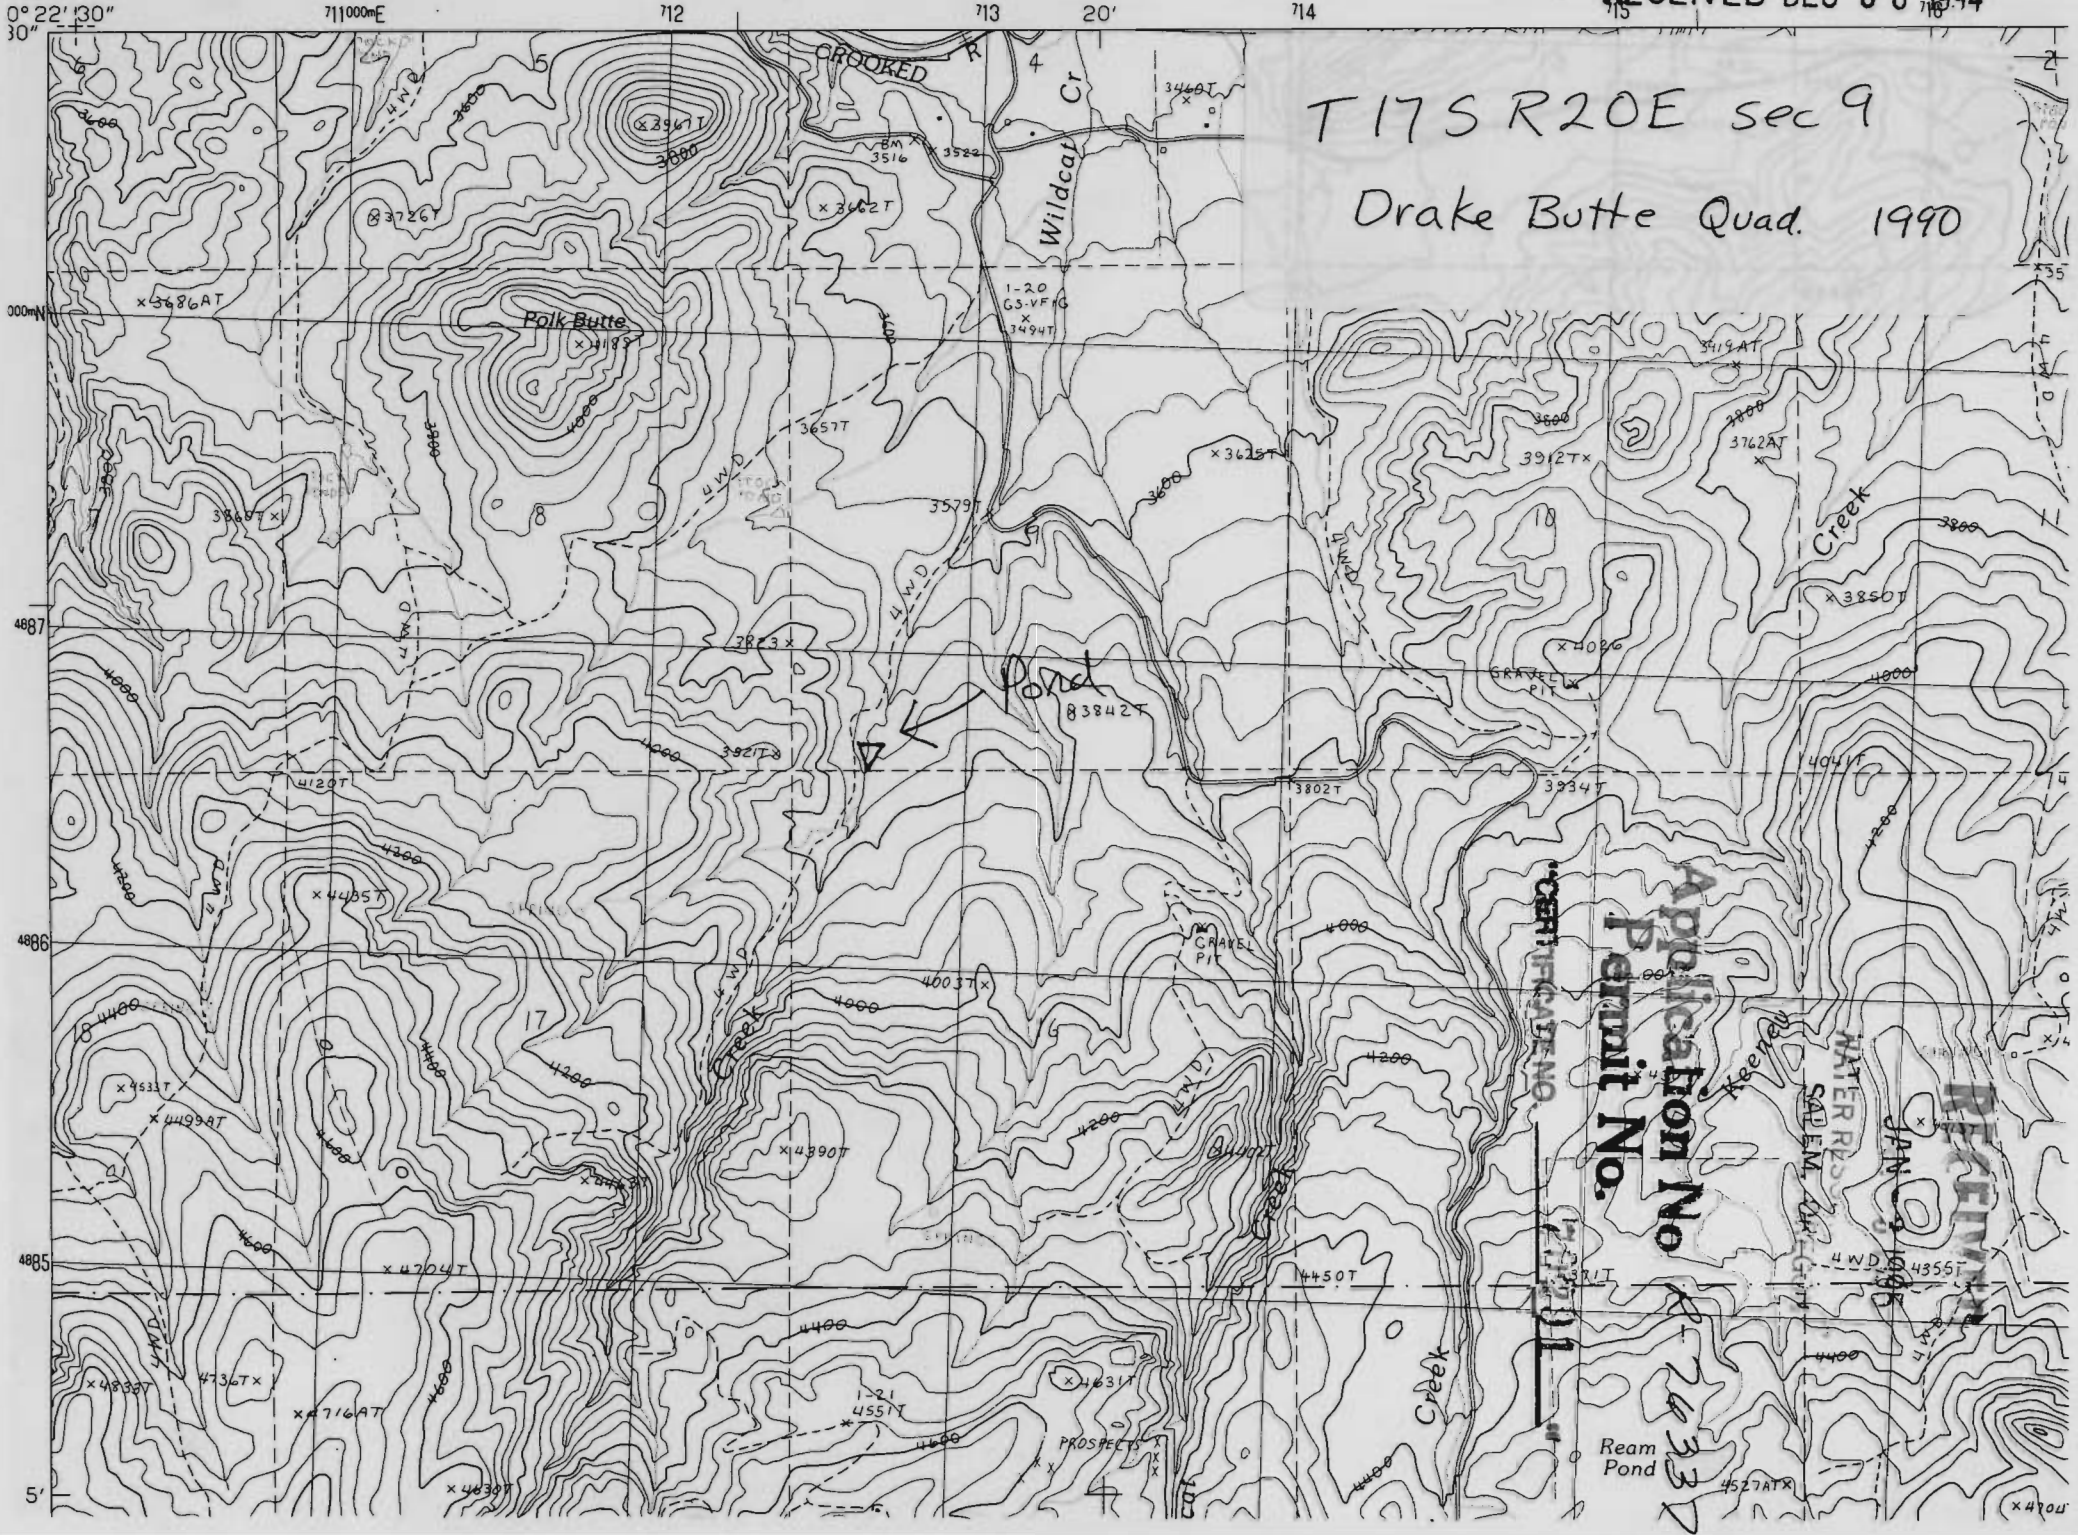

CERTIFICATE NO.

Application No.
Permit No.

17-20-1

Ream Pond

WATER RES.

JAN 10 1995

RECEIVED

4WD 4355

4WD 4355

