


Application No. R-70339
Permit No.

10

RECEIVED
JAN 16 1995
WATER RESOURCES DEPT.
SALEM, OREGON

RECEIVED
JAN 23 1995
WATER RESOURCES DEPT.
EASTERN REGION

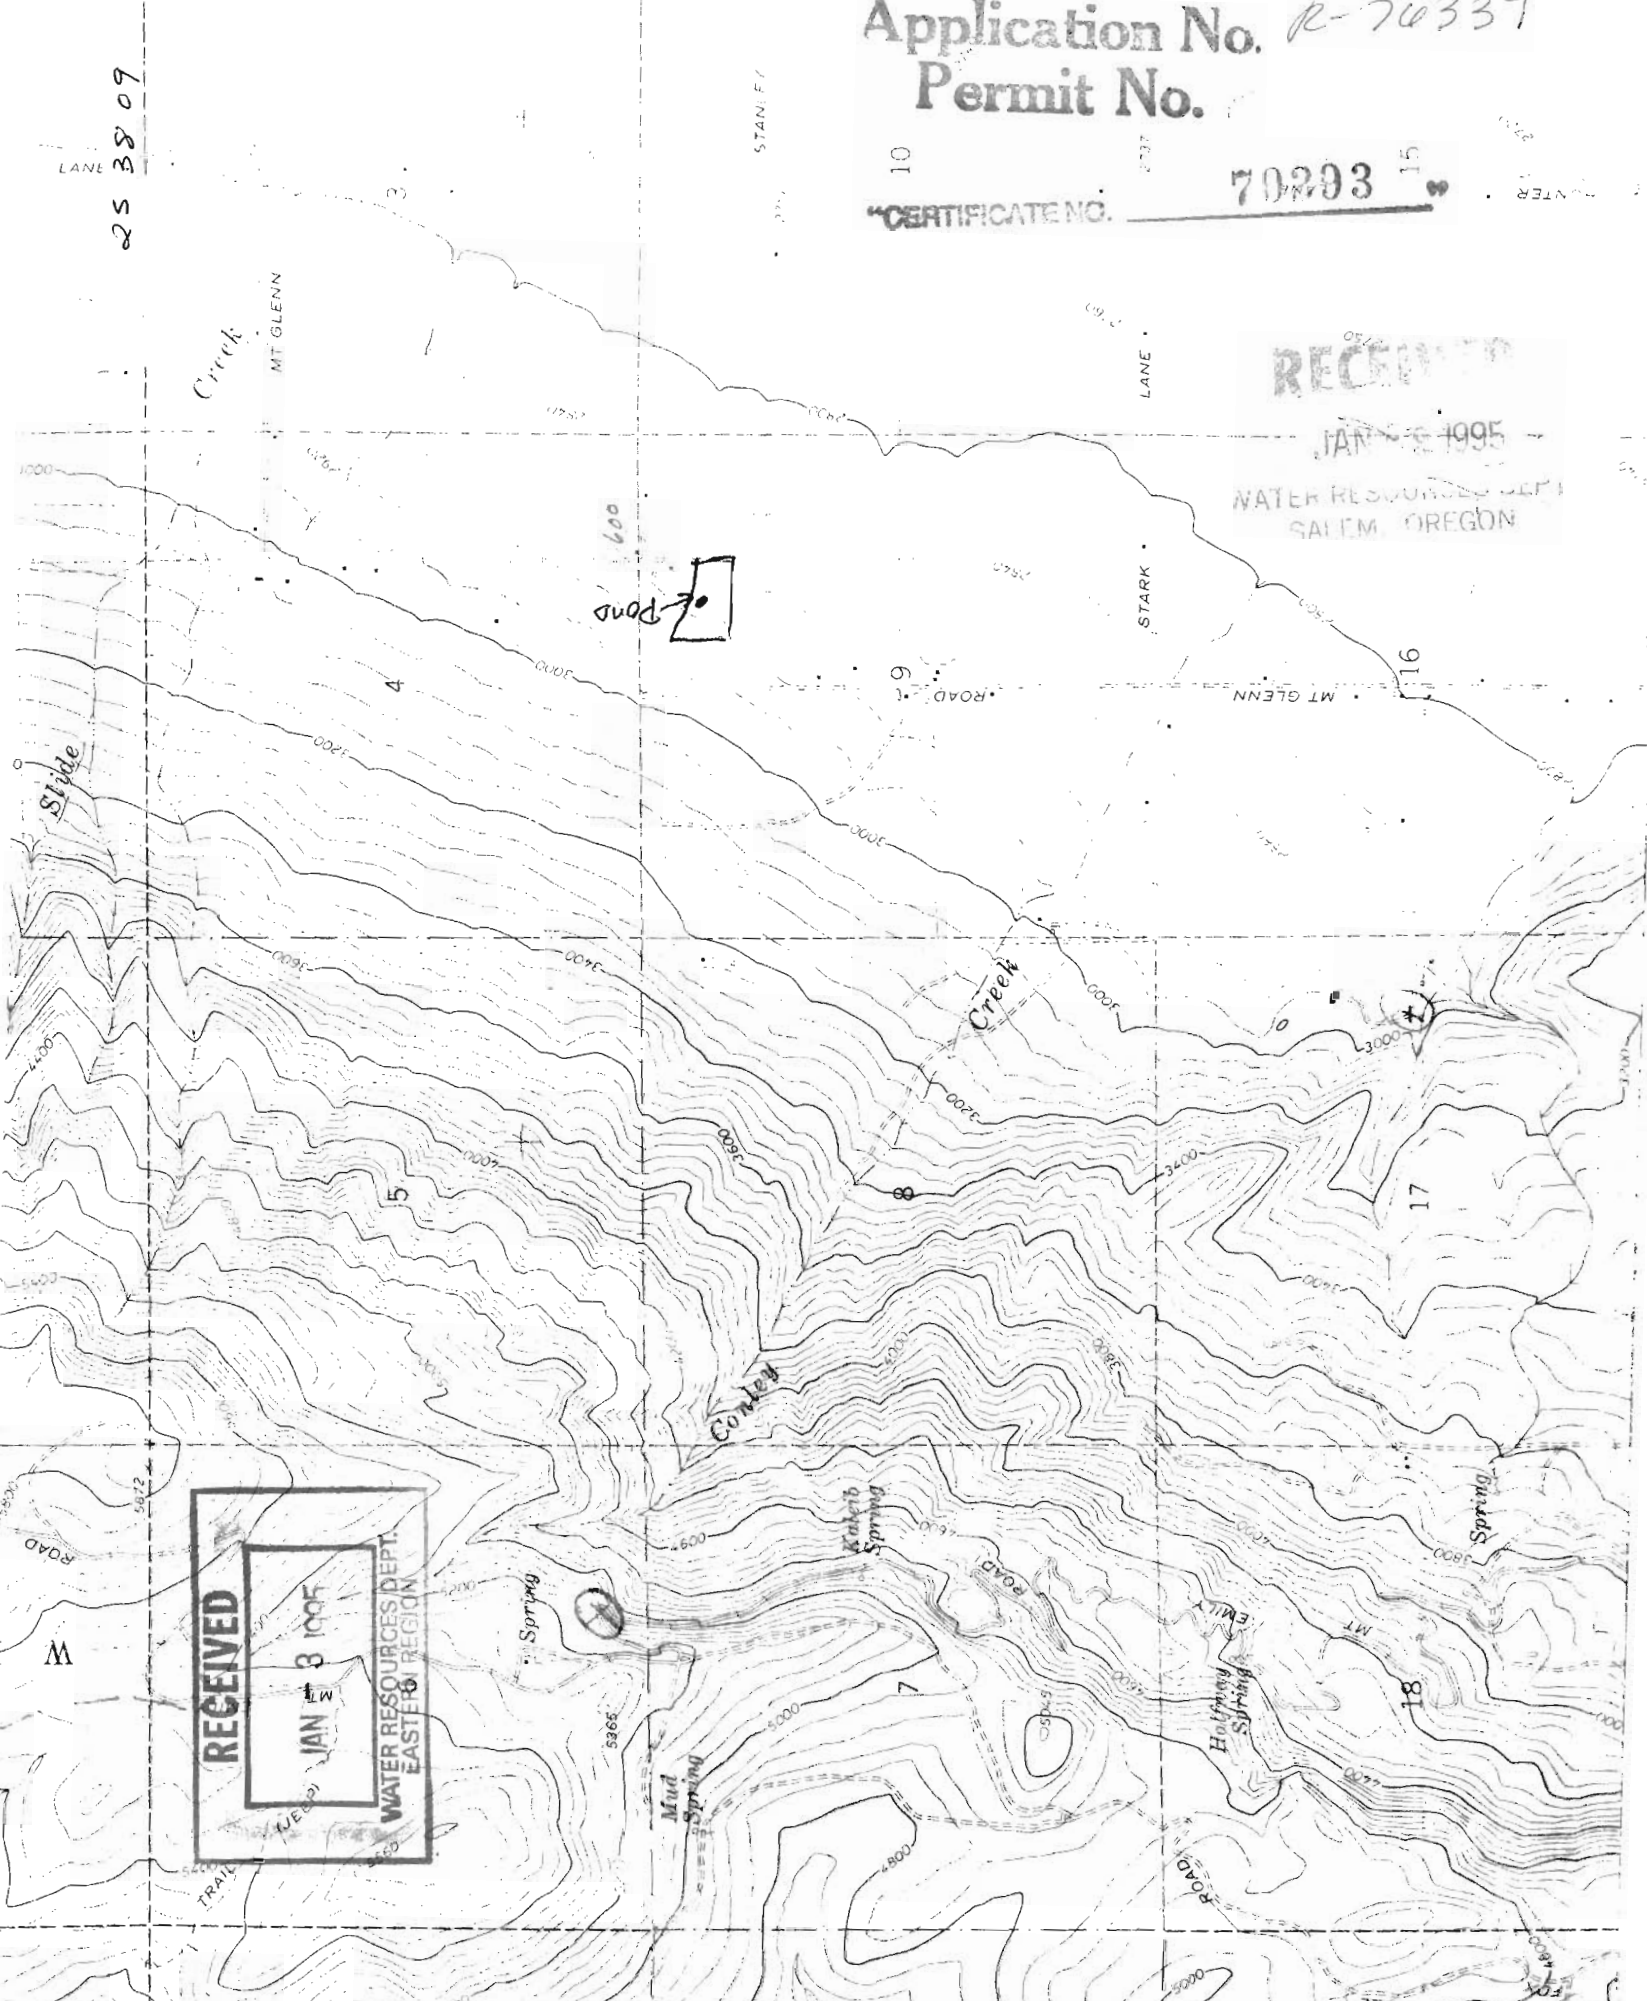

25 38 09

STARK

LANE

STARK

MT GLENN

16

17

18

Stride
Creek

MT GLENN

Conley
Creek

Kakab
Spring

Mud
Spring

Holmway
Spring

Emily
Spring

HILL

FOR

Application No. R-76339
Permit No.


JAN 27 1995

WATER RESOURCES
SALEM, OREGON

RECEIVED
JAN 3 1995
WATER RESOURCES DEPT.
EASTERN REGION

