



RECEIVED
SCALE 1:48000

JAN - 3 1995

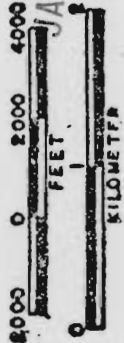

RECEIVED
APR 6 1993
BUREAU OF REVENUE STATE OF OREGON
ASSESSMENT & APPRAISAL DIV.

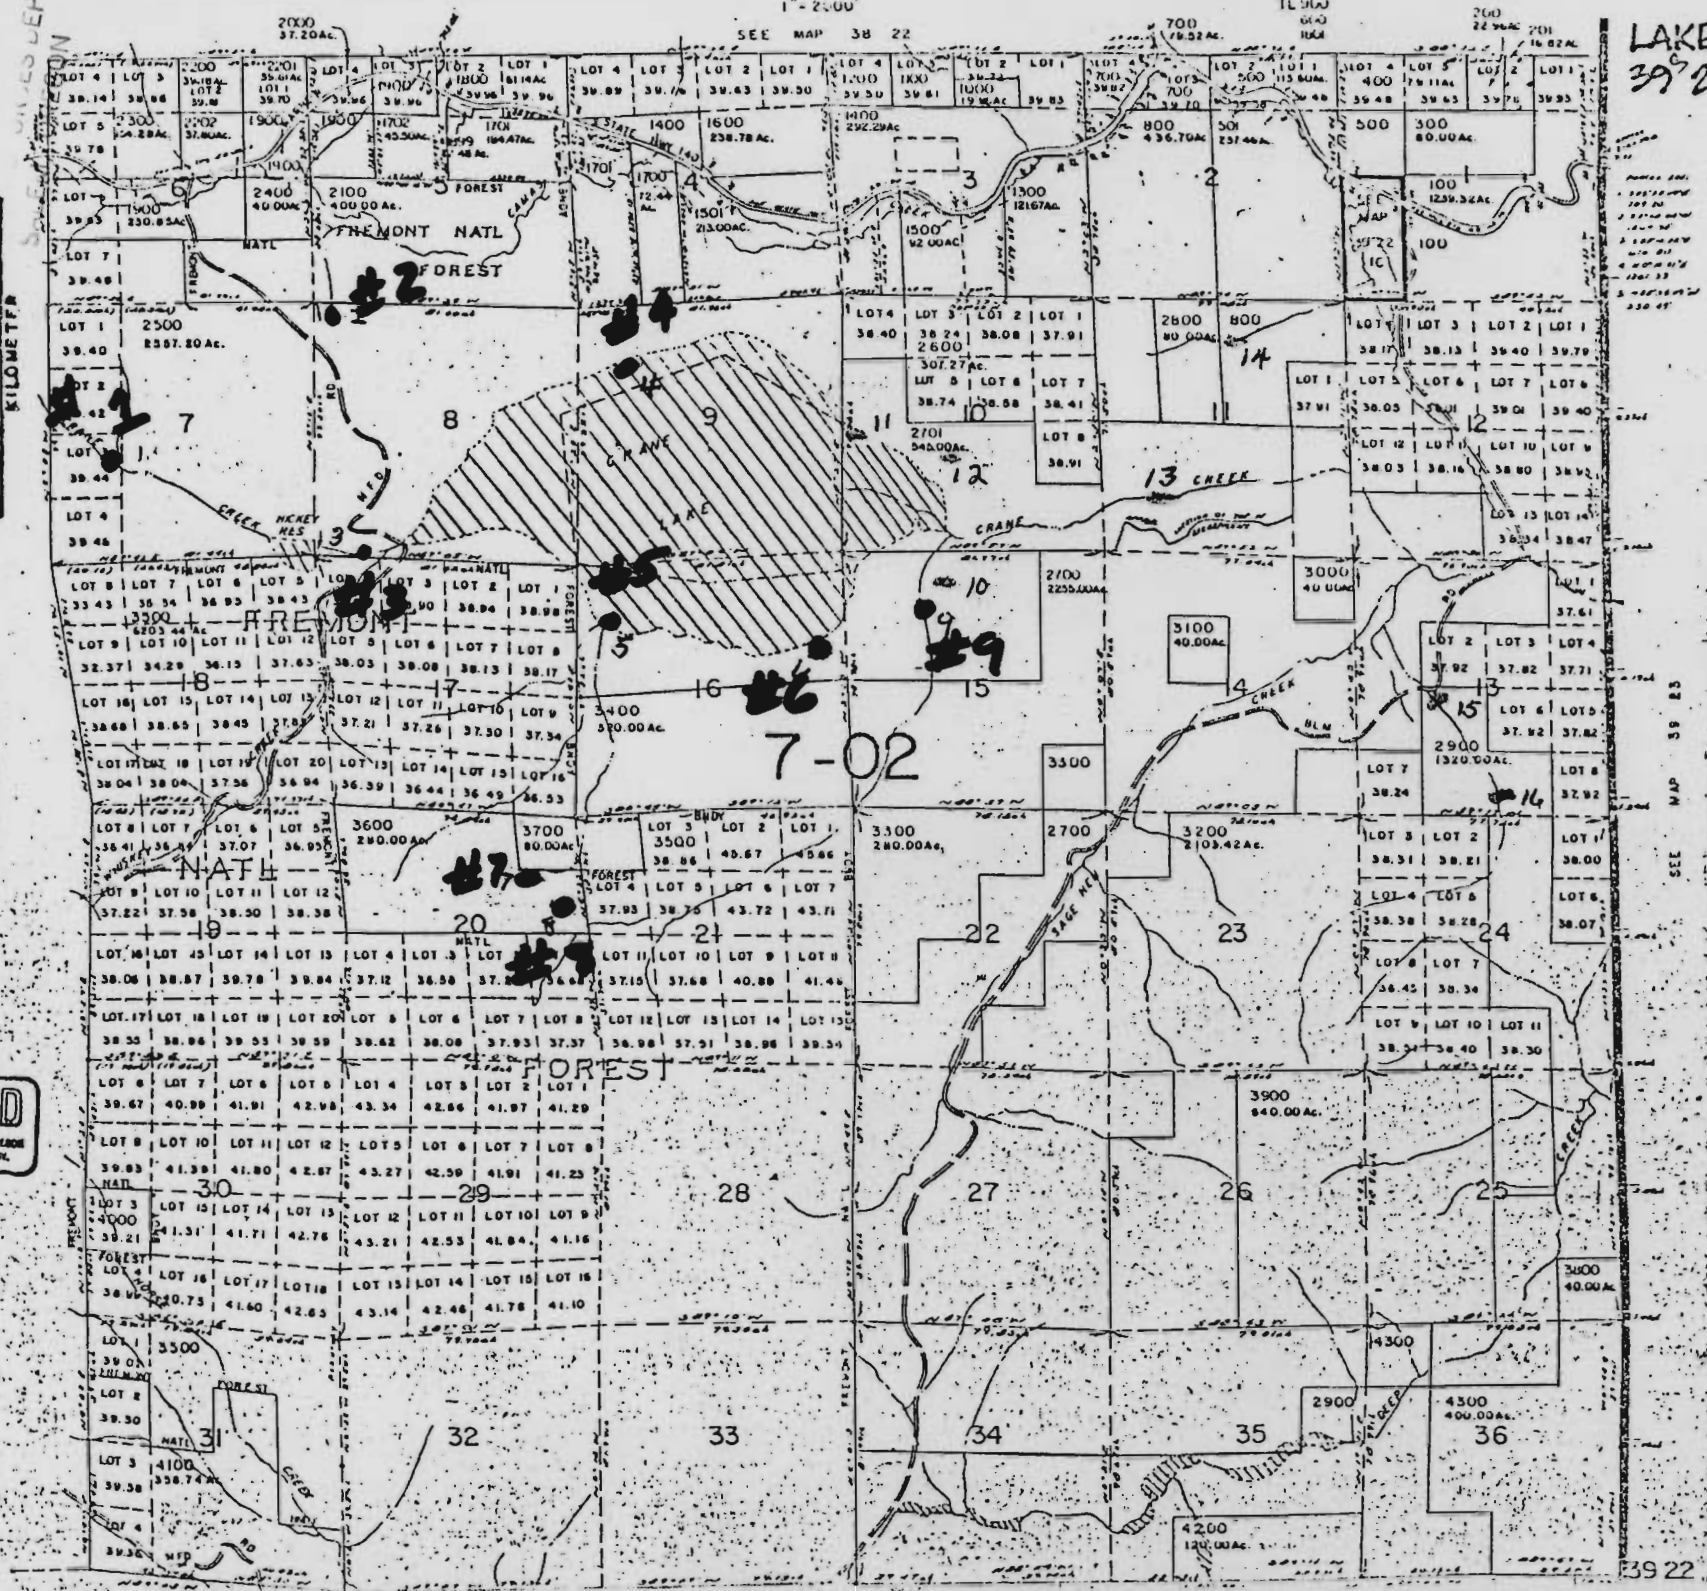

Application No. R-70344
Permit No. 70298

CERTIFICATE NO. 70298