

Appurtenance # 76346

RECEIVED


SCALE 1:48000

JAN - 3 1995

WATER MAP 39 21
SALEM, OREGON



RECEIVED
APR 06 1993
BUREAU OF LAND MANAGEMENT
WASHINGTON, D.C.

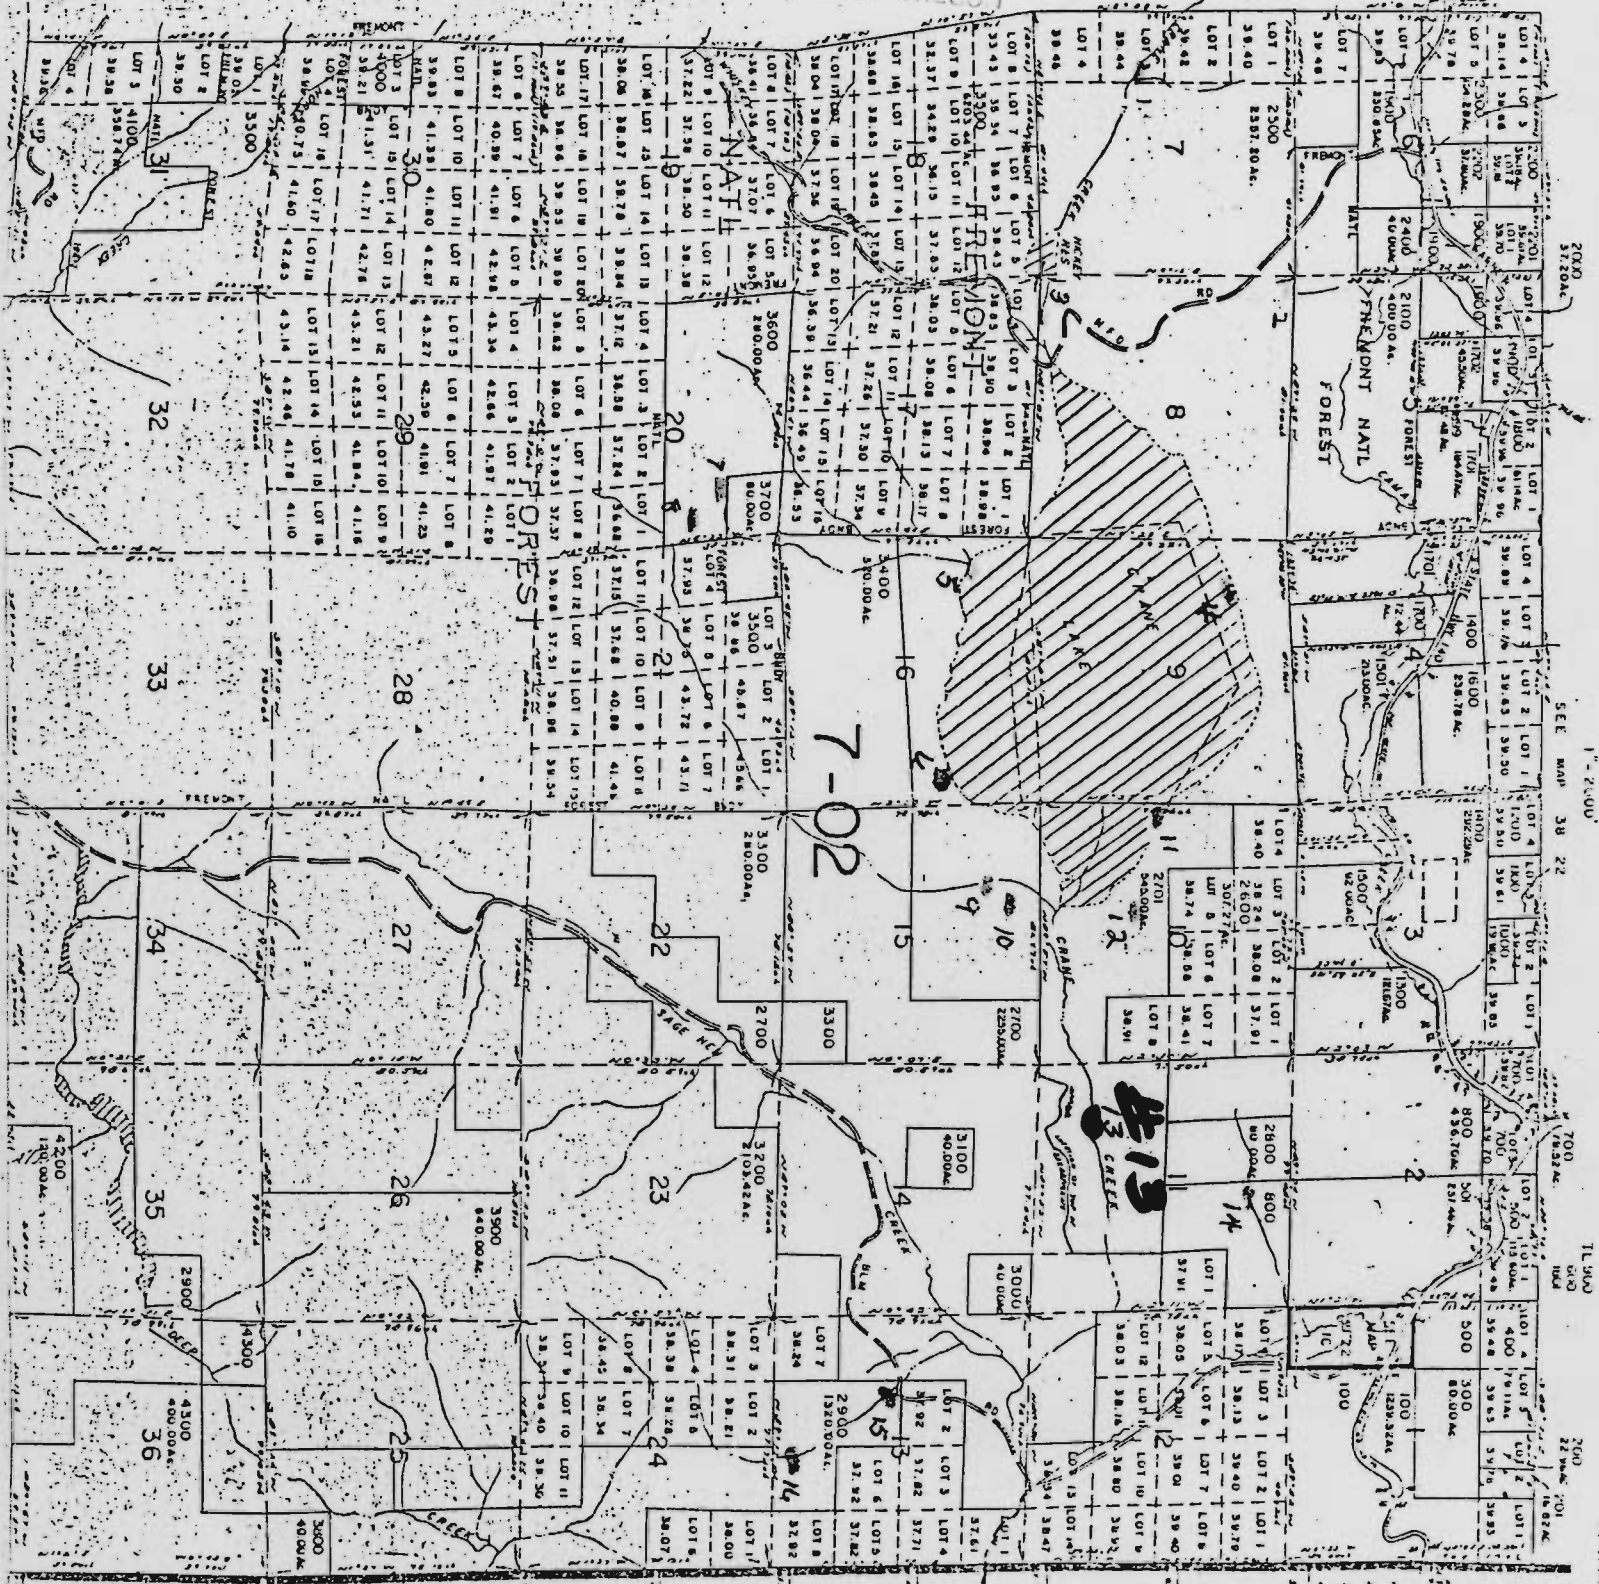

SEE MAP 39 23

LAKE
39 22

CERTIFICATE NO. 70300