


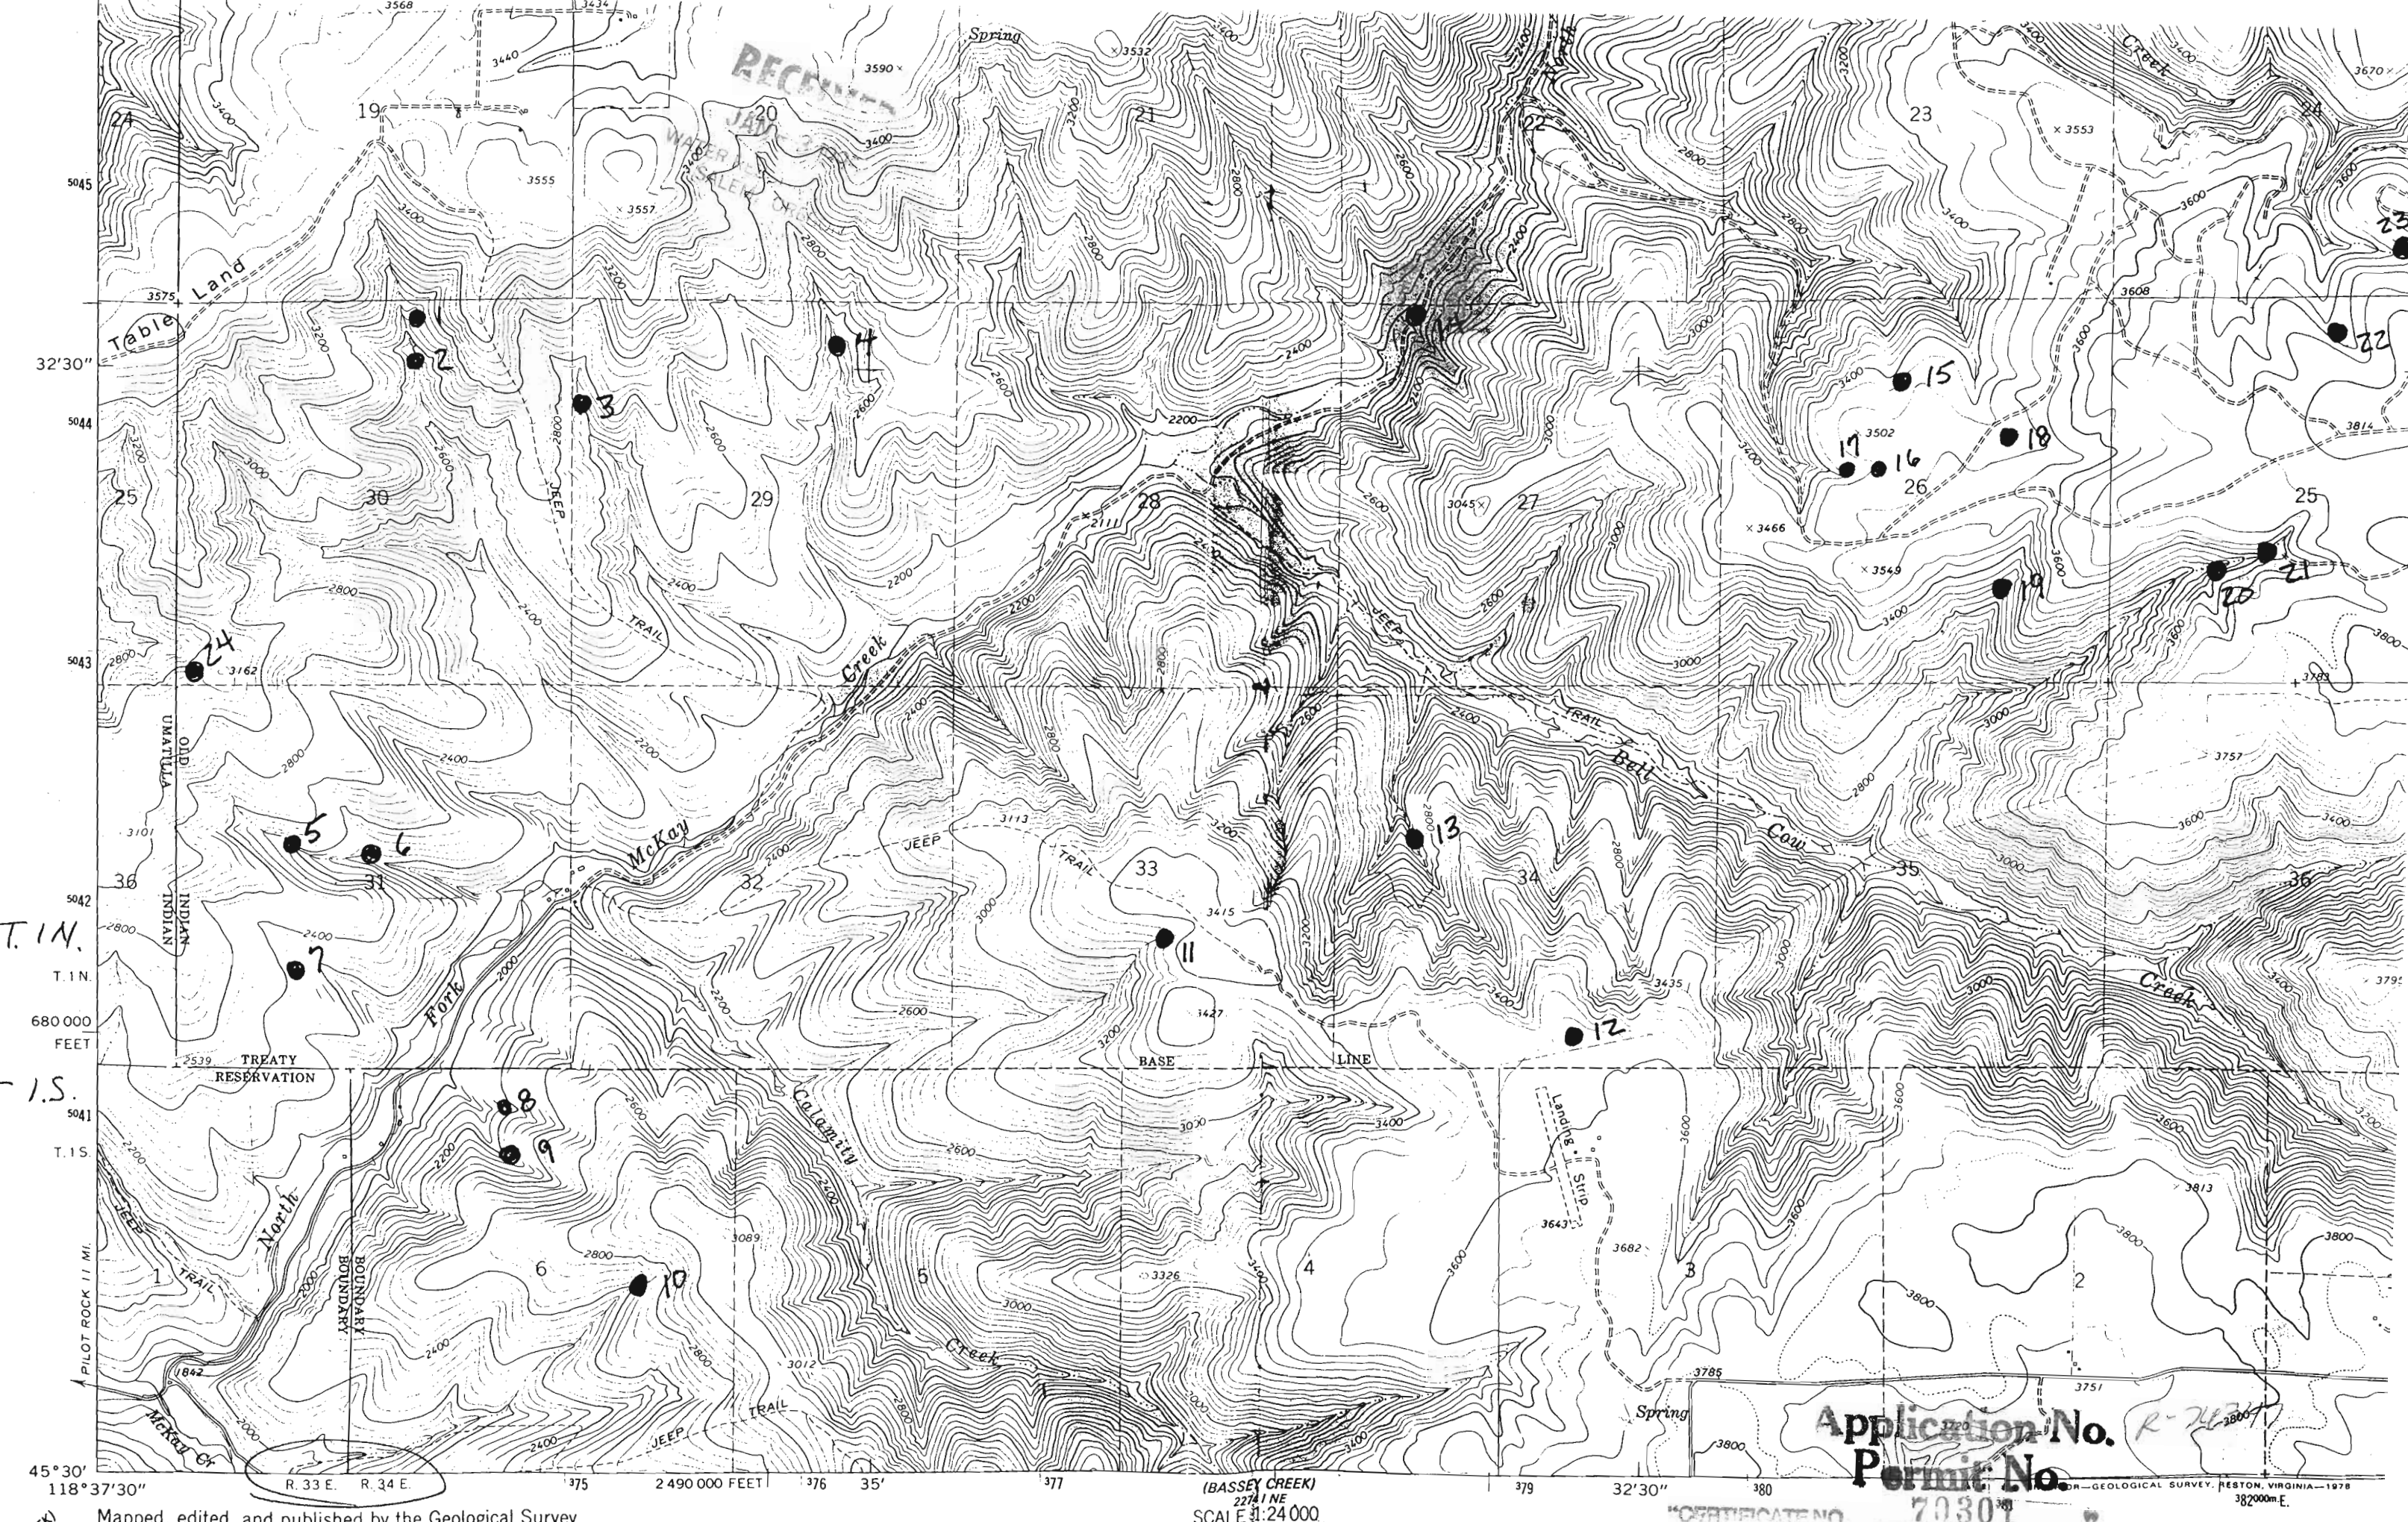

Application No. R-2403
Permit No. 70301