

SEC 36 T.8S. R.3W. WM. MARION CO., ORE.

8 3W 36
& INDEX

DEC 28 1994

LEGEND

LINES TYPES

- TAX LOT BOUNDARIES
- OLD PROPERTY LINES
- RIVERS, LAKES, ETC.
- CREEKS, POND, ETC.
- RAILROADS
- TAX CODE BOUNDARIES
- SUBDIVISION BOUNDARIES

SYMBOL TYPES


- CONTROL POINTS
- SURVEY MONUMENTS
- G.L.O. CORNERS (APPROX) (FOUND)
- SECTION
- 1/4 SEC
- 1/16 SEC
- D.L.C.

OREGON STATE PLANE COORDINATE SYSTEM GRID MARKS

NUMBERS
TAX CODE NO.
000 00 00 0

ACREAGE - ALL ACREAGES EXCLUDE ANY PORTION THAT MAY LIE WITHIN THE INDICATED PUBLIC RIGHT OF WAYS.

NOTICE: THIS MAP WAS PREPARED FOR ASSESSMENT PURPOSES ONLY I

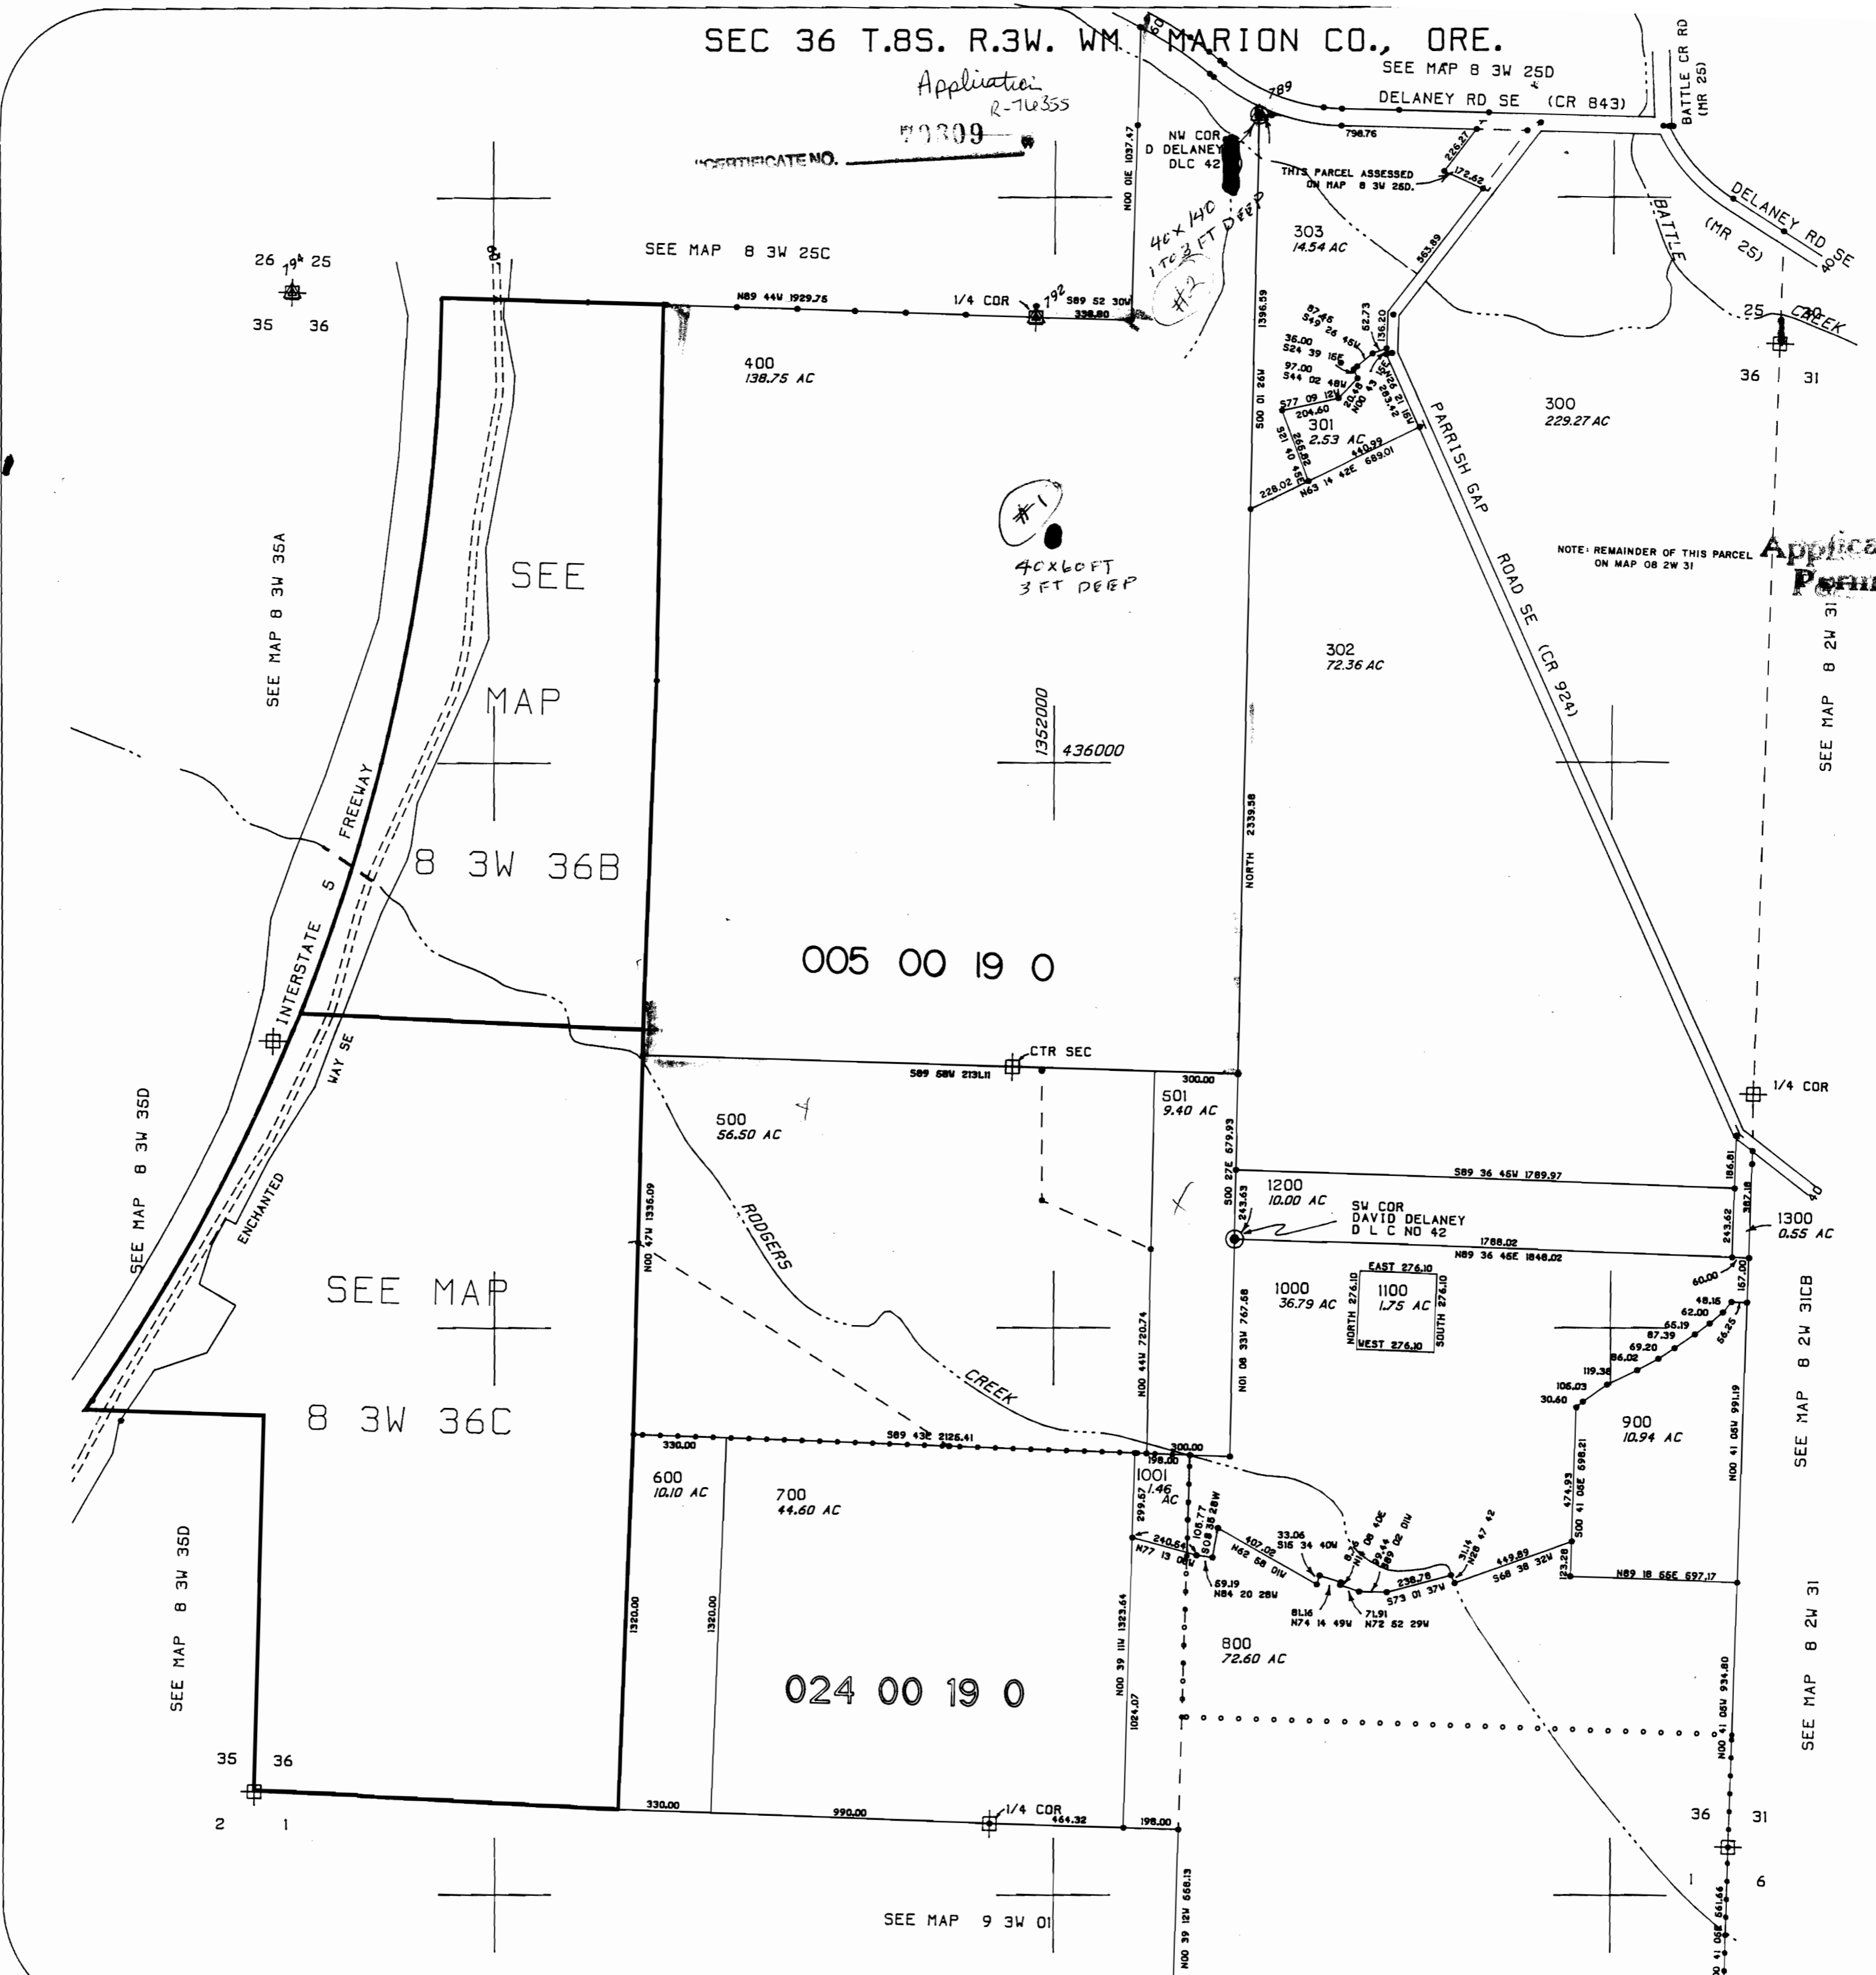

RECEIVED

DEC 29 1994

WATER RESOURCES DEPT
SALEM, OREGON

Application No. R-76355
Permit No.

1"=400'
18-MAY-82

& INDEX
8 3W 36