


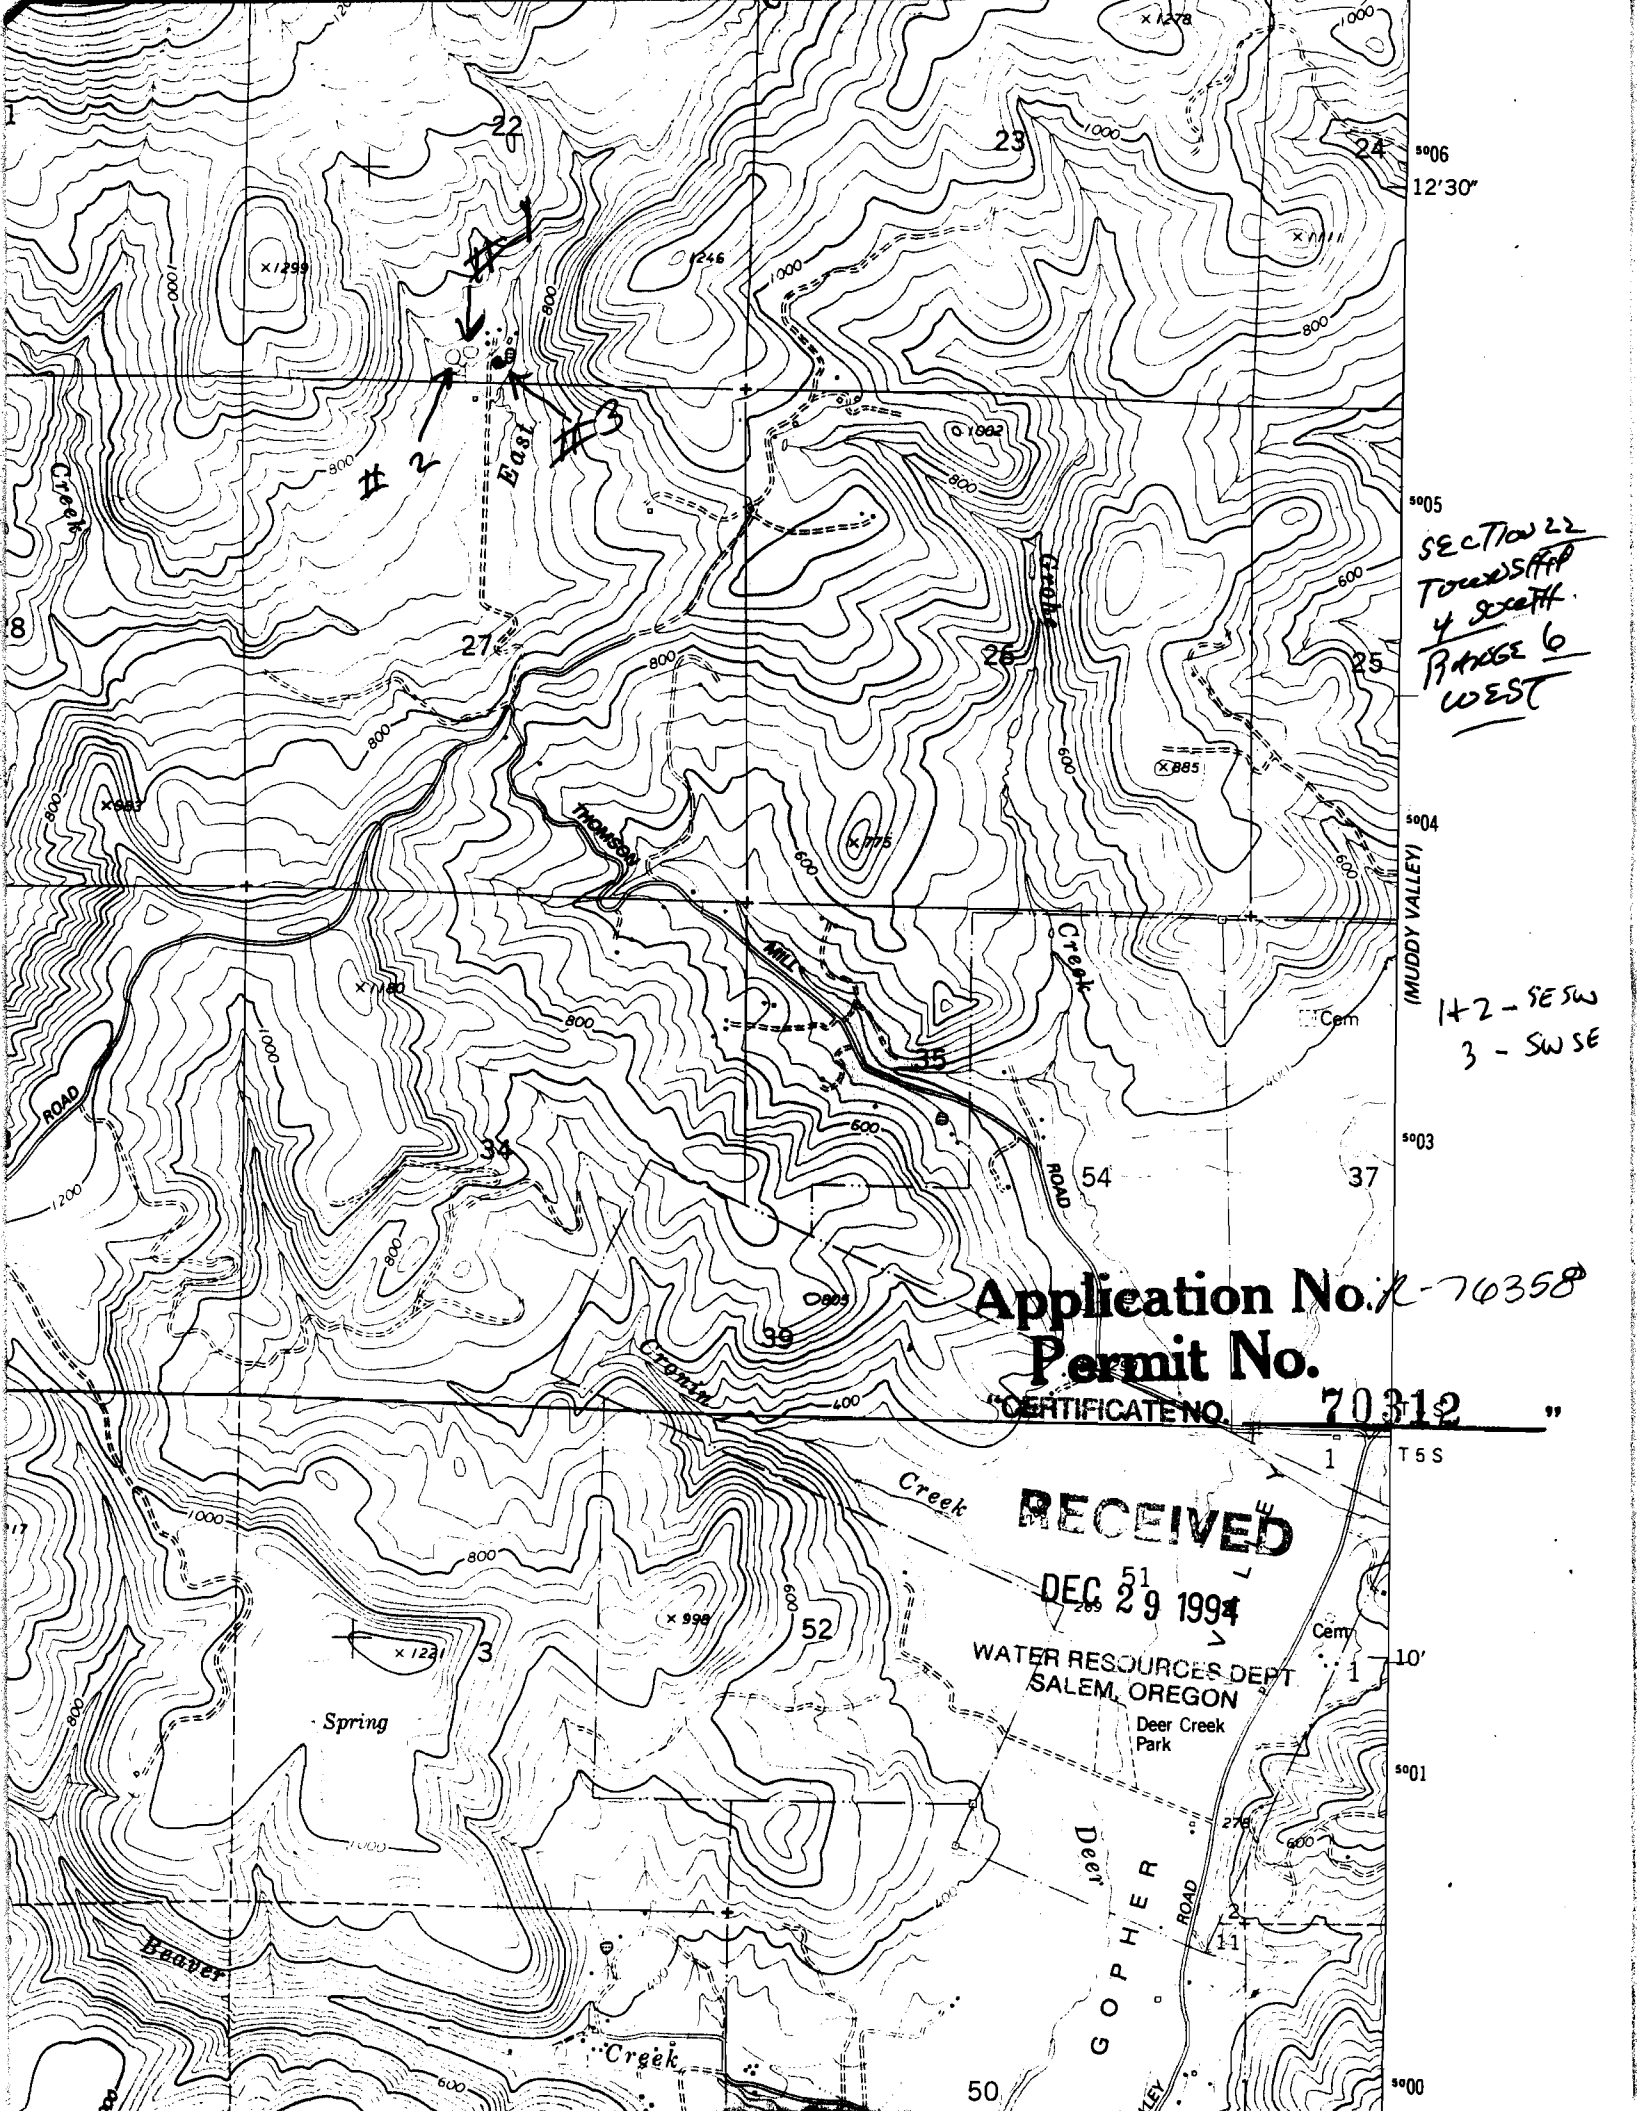

12'30"

SECTION 22  
TOWNSHIP  
4 SE 1/4  
RANGE 6  
WEST

1-2 - SE SW  
3 - SW SE

Application No. K-76358  
Permit No.  
"CERTIFICATE NO. 70312"

RECEIVED

DEC 29 1994

WATER RESOURCES DEPT  
SALEM, OREGON

Deer Creek  
Park

DEER  
GOPHER  
ROAD