

THIS MAP WAS PREPARED FOR
ASSESSMENT PURPOSE ONLY.

SECTION 7 T.25S. R.6W. W.M.
DOUGLAS COUNTY

REVISED ON
4-26-94

RECEIVED
JAN - 3 1995
VALUED FOR
SALE & CRIGG

25 6 7


1"=400'

Application No. R-74362
Permit No. 70313

CERTIFICATE NO. 70313

SEE MAP 25 6 6

S88°45'W 80.10 CH GLO

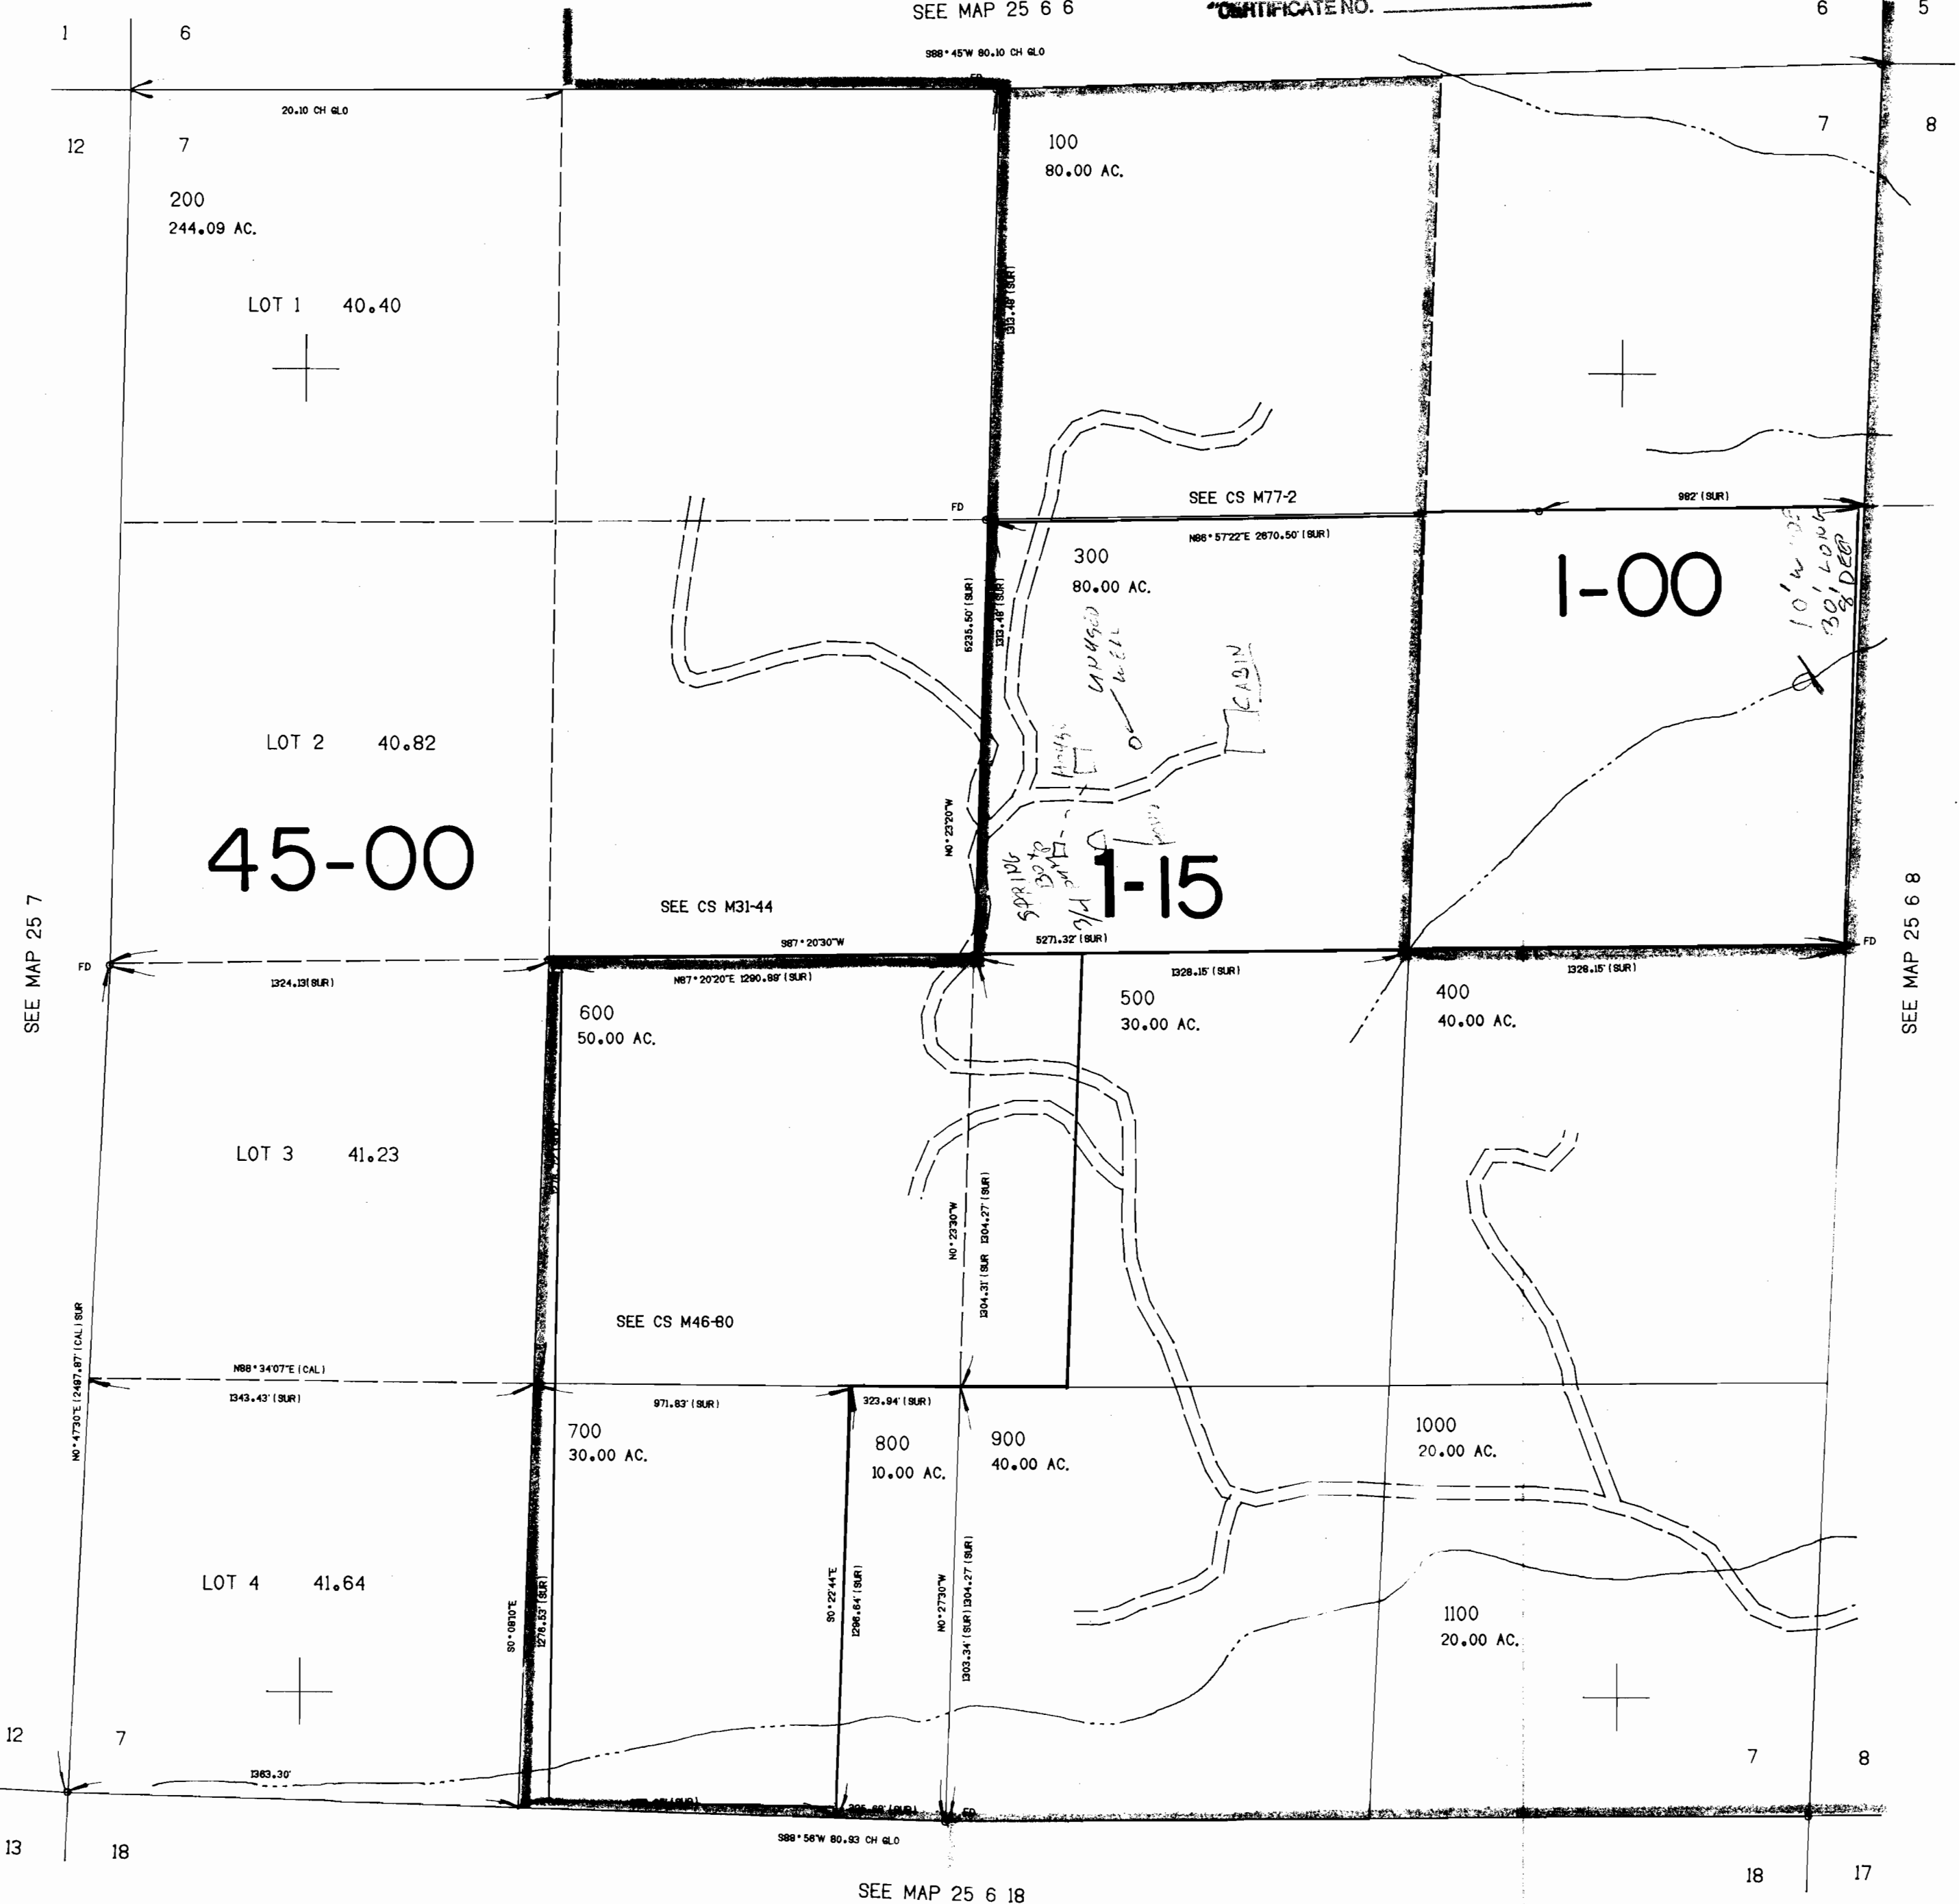

SEE MAP 25 6 18

647.000

25 6 7