

Application No. R-70363 Permit No.

Sec. 3 T.17 S. R.6 W. W.M.

LANE COUNTY

1" = 400'

#300

See Map 16 06 34

McREYNOLDS
069-19

RECEIVED

JAN - 3 1995


WATER RESOURCES
SALEM, OREGON

069-0

"CERTIFICATE NO. 70314"

33

34

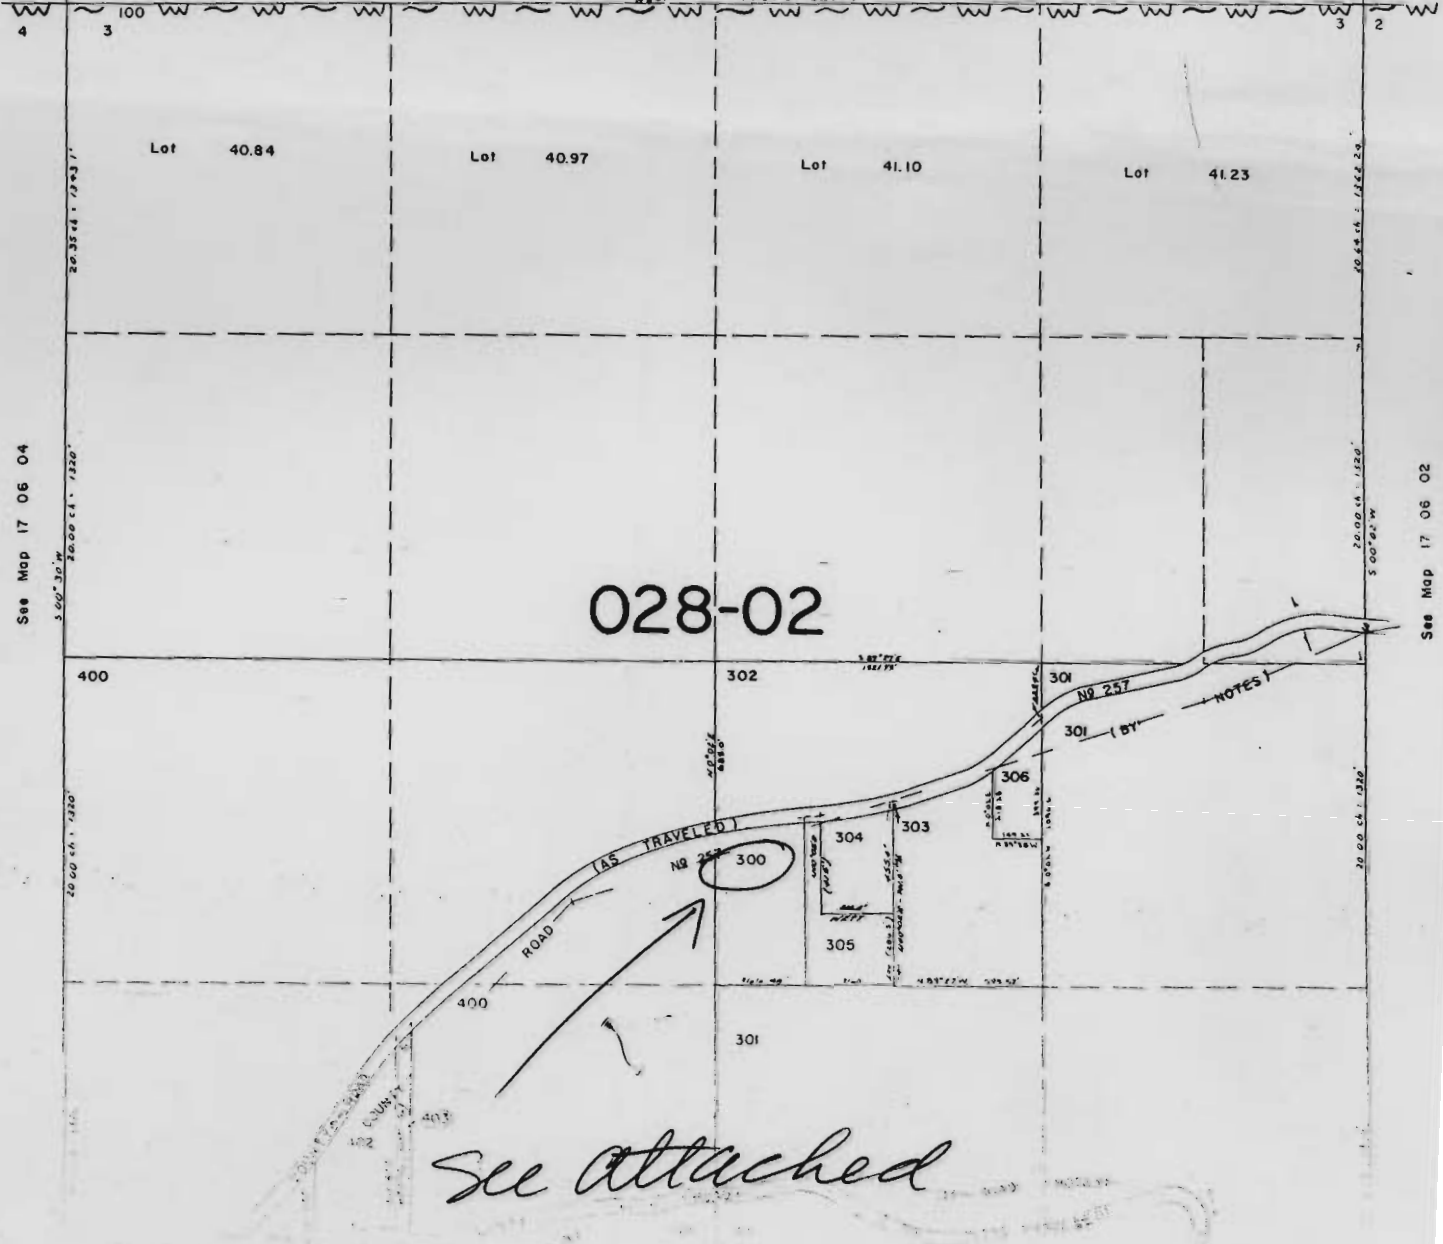

See Map 17 06 04

See Map 17 06 02