

THIS MAP WAS PREPARED FOR
ASSESSMENT PURPOSE ONLY.


"CERTIFICATE NO. 70318"

Application No. R-76367
Permit No.

RECEIVED

JAN - 3 1995

WATER RESOURCES DEPT.
10 SALEM, OREGON

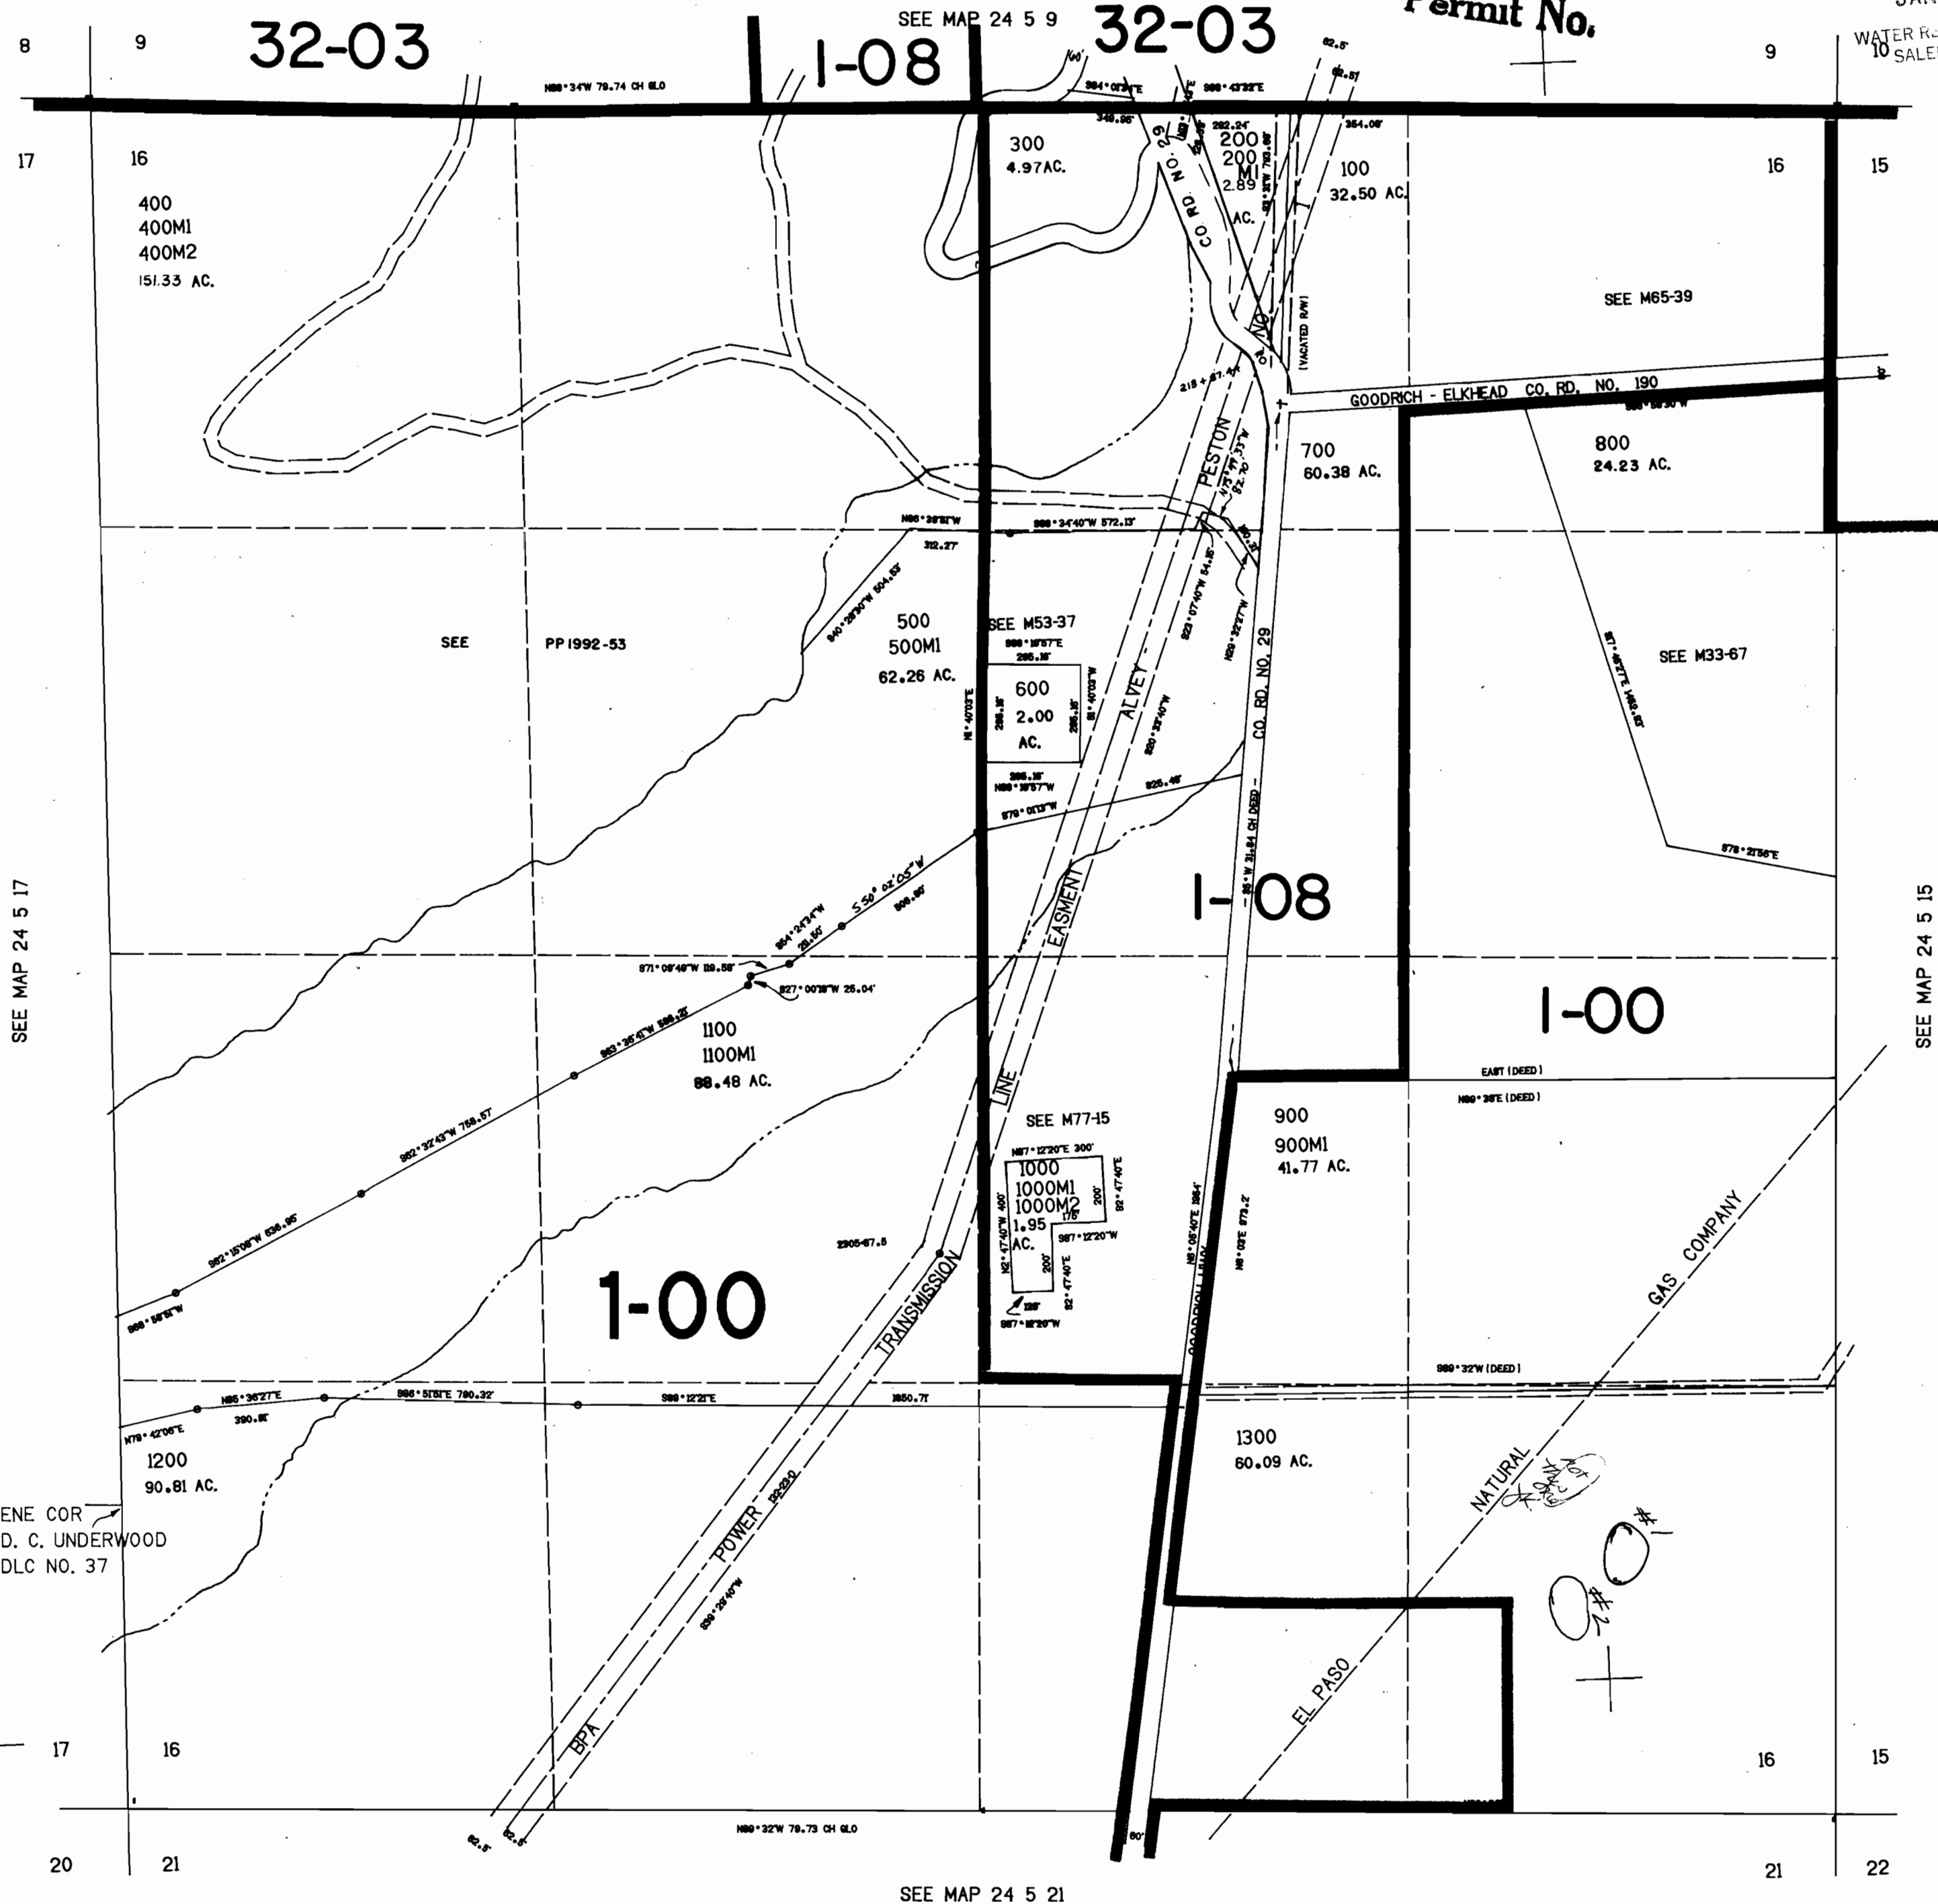

672.000

24 5 16