


R44E

T1N
T1S

690000
FEET



Permit No. 70725
CERTIFICATE NO. 70725

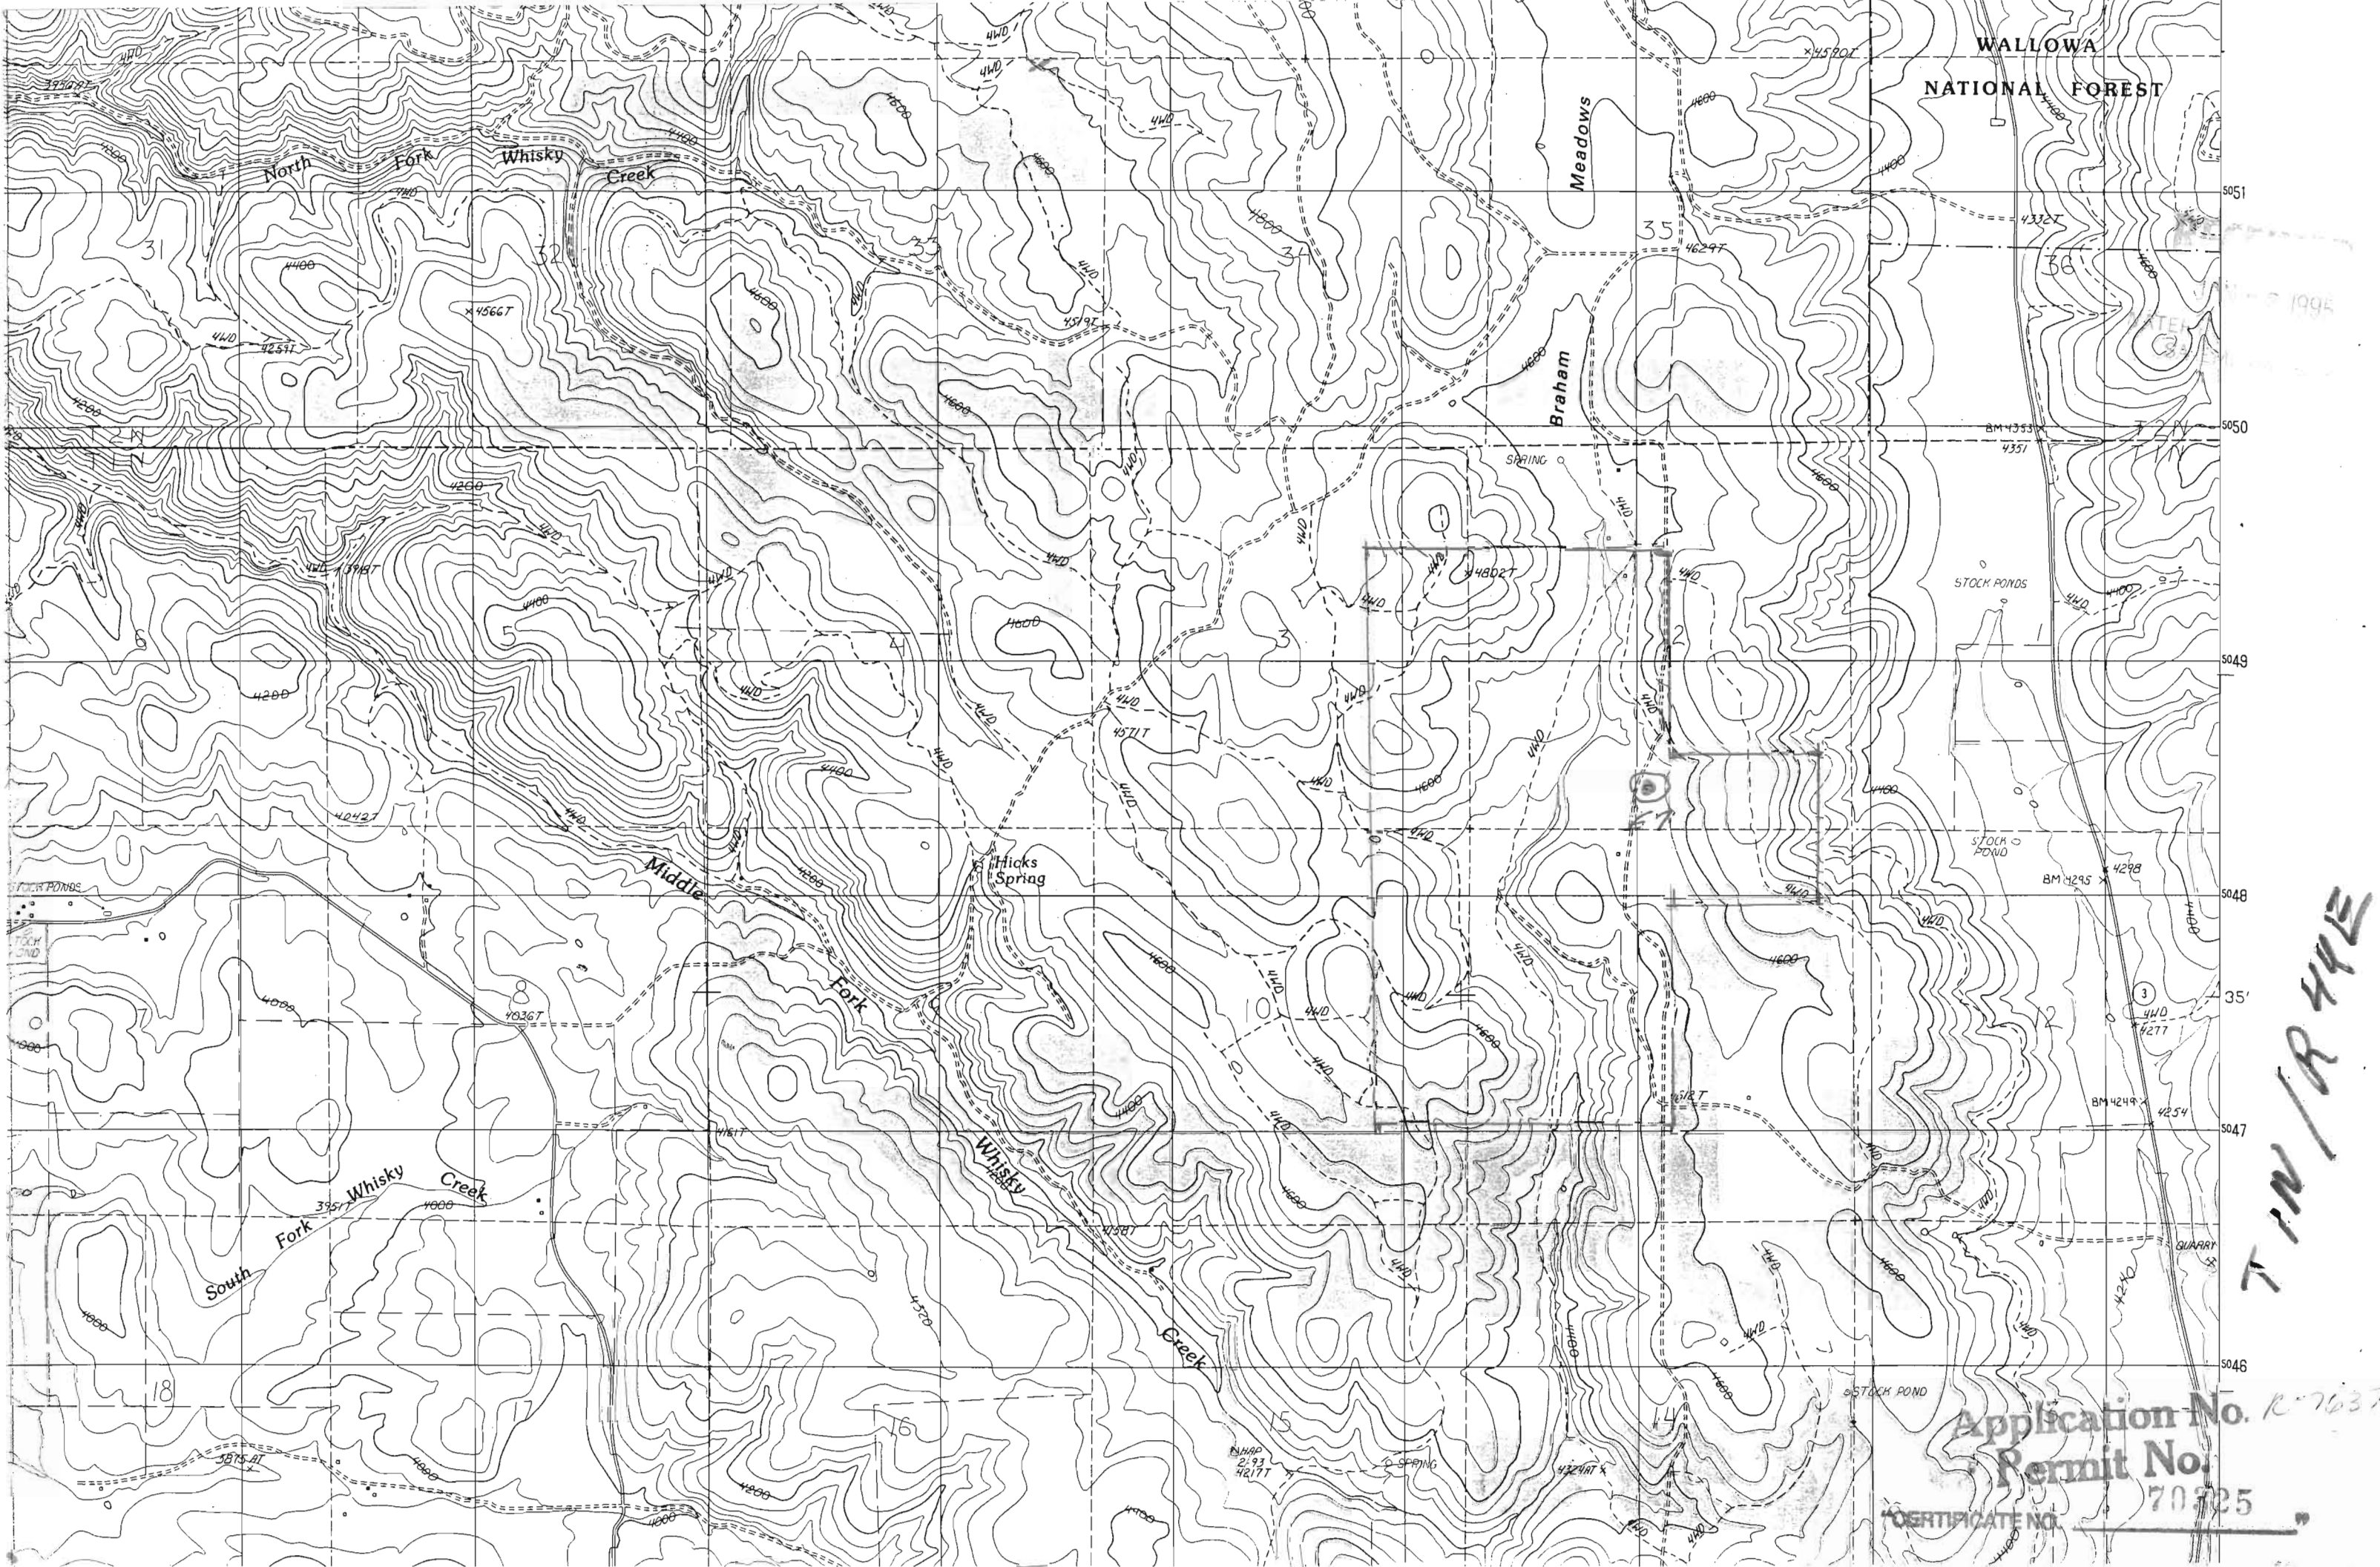

WALLOWA
NATIONAL FOREST

Application No. R-7637
Permit No. 70725
CERTIFICATE NO.