


TIN
R 39E

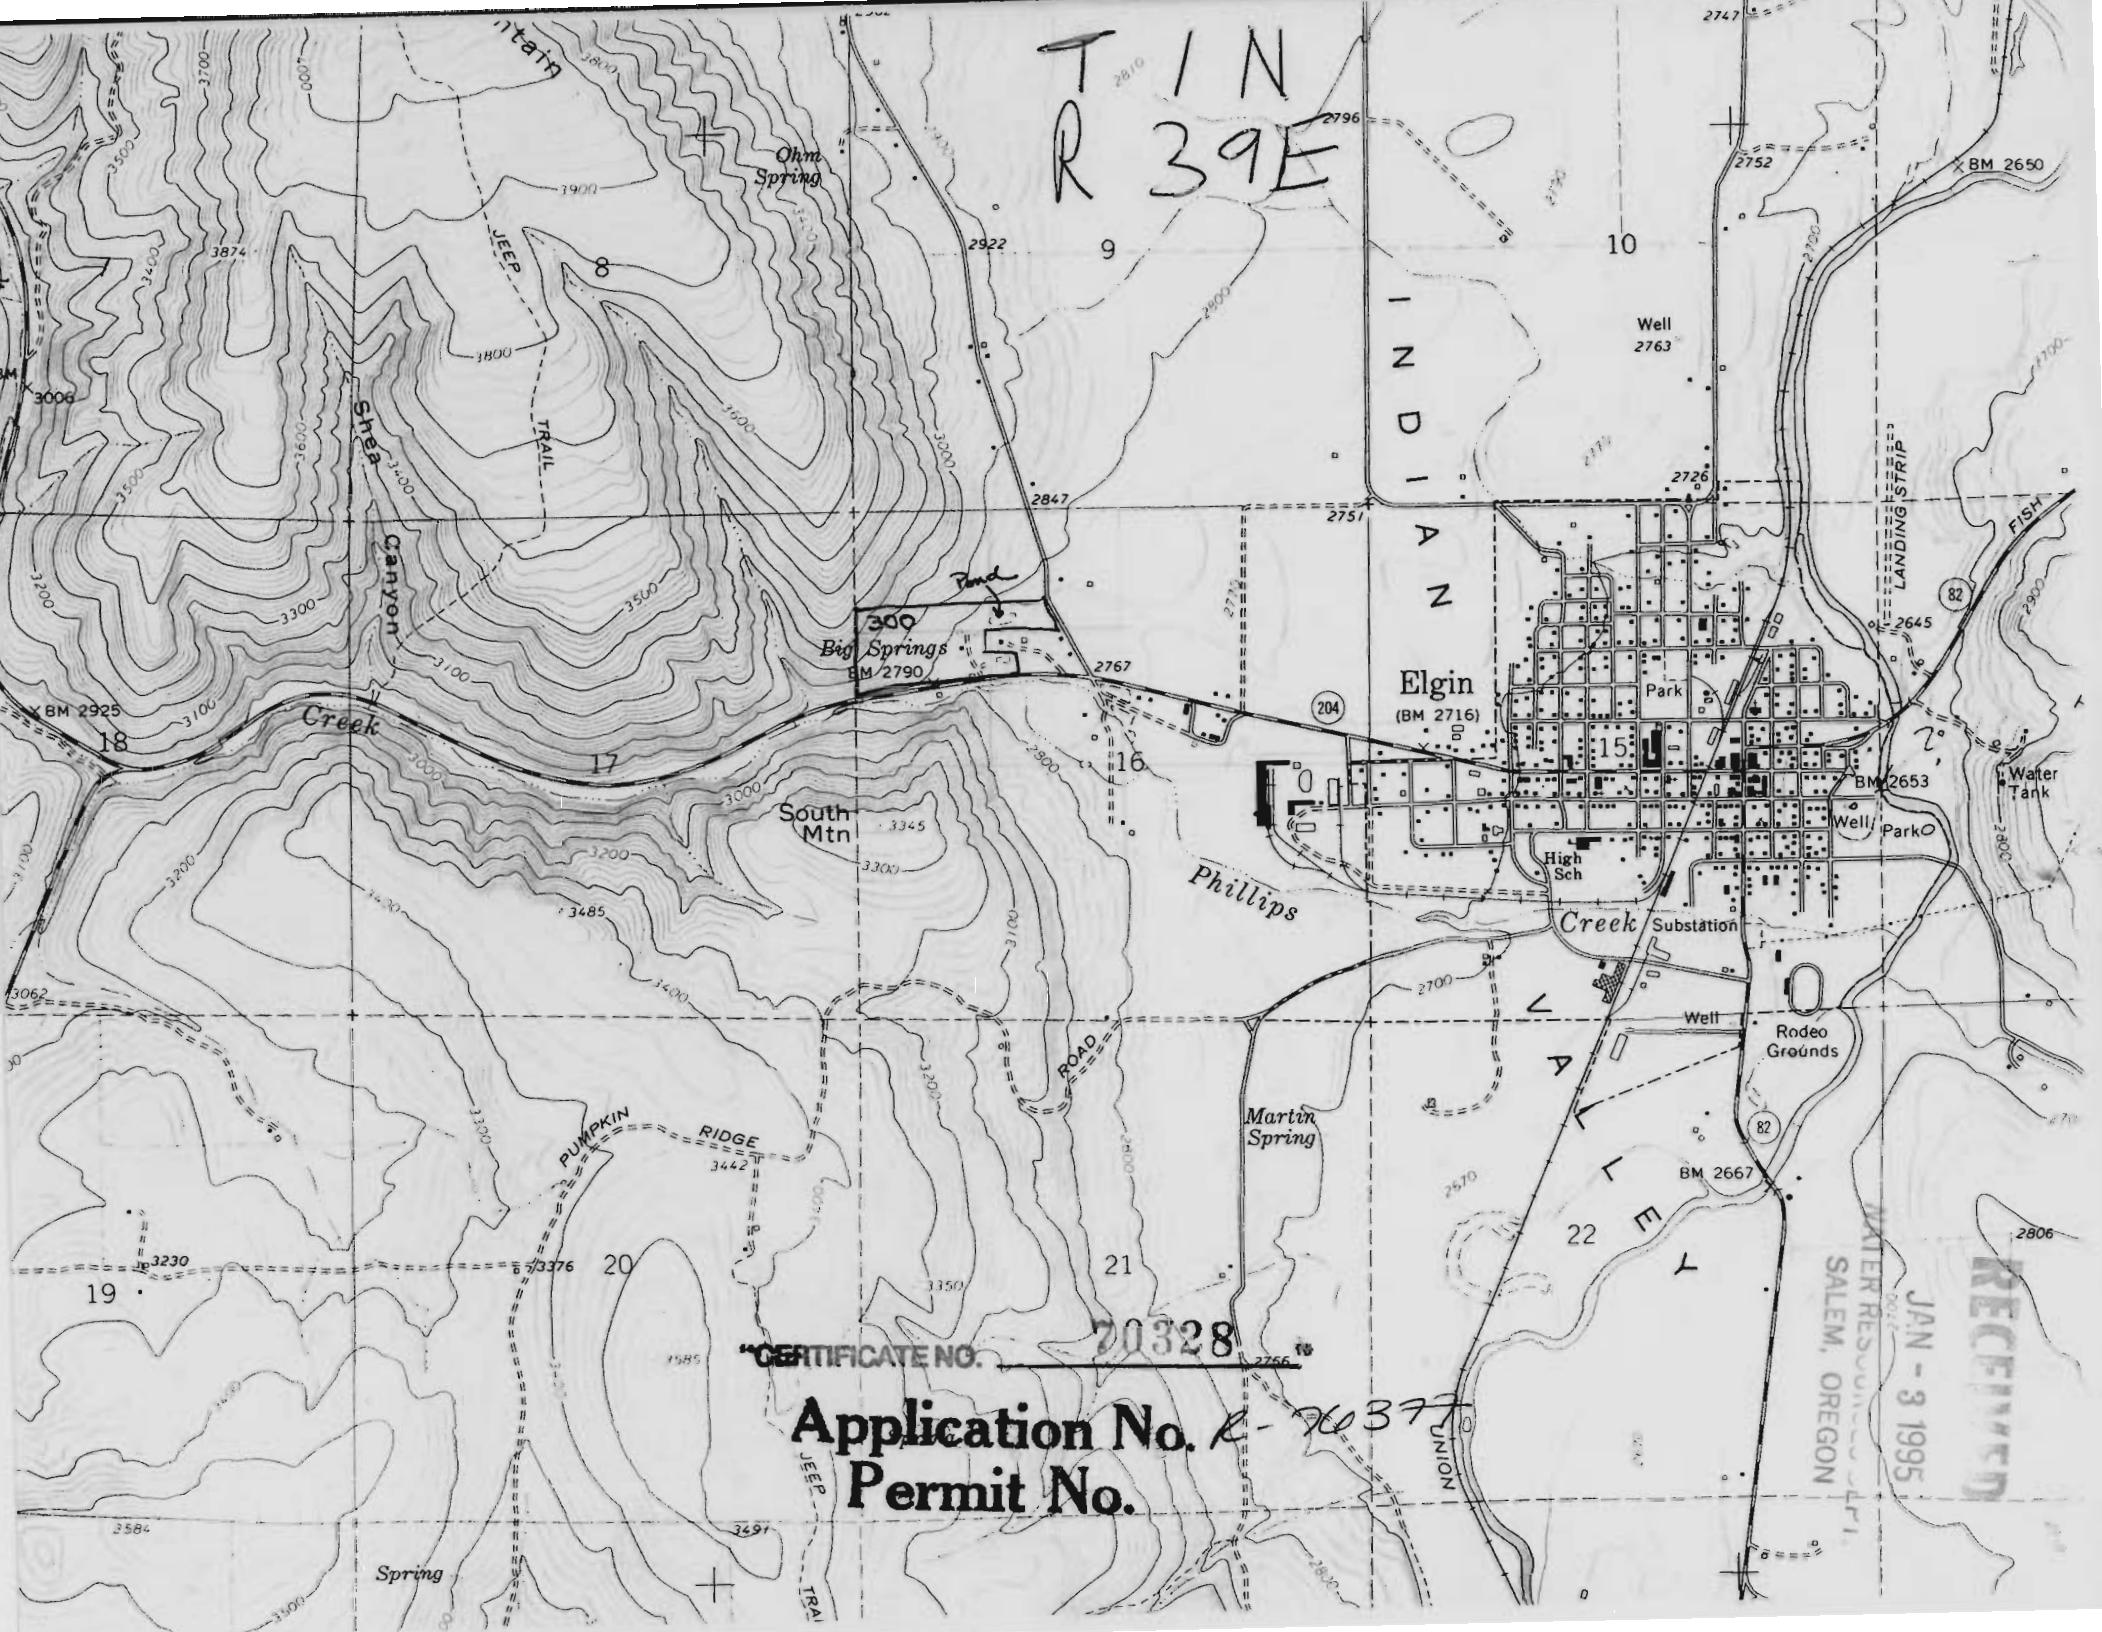


Application No. R-70377
Permit No.

RECEIVED
JAN - 3 1995
WATER RESOURCES DIVISION
SALEM, OREGON