

SECTION 24 T.23S. R.10W. W.M.
DOUGLAS COUNTY


$$I'' = 400'$$

IDENTIFICATION NO. 70329

CANCELLED PARCEL NO'S
700

THIS MAP WAS PREPARED FOR
ASSESSMENT PURPOSE ONLY.

SEE MAP 23 10 13

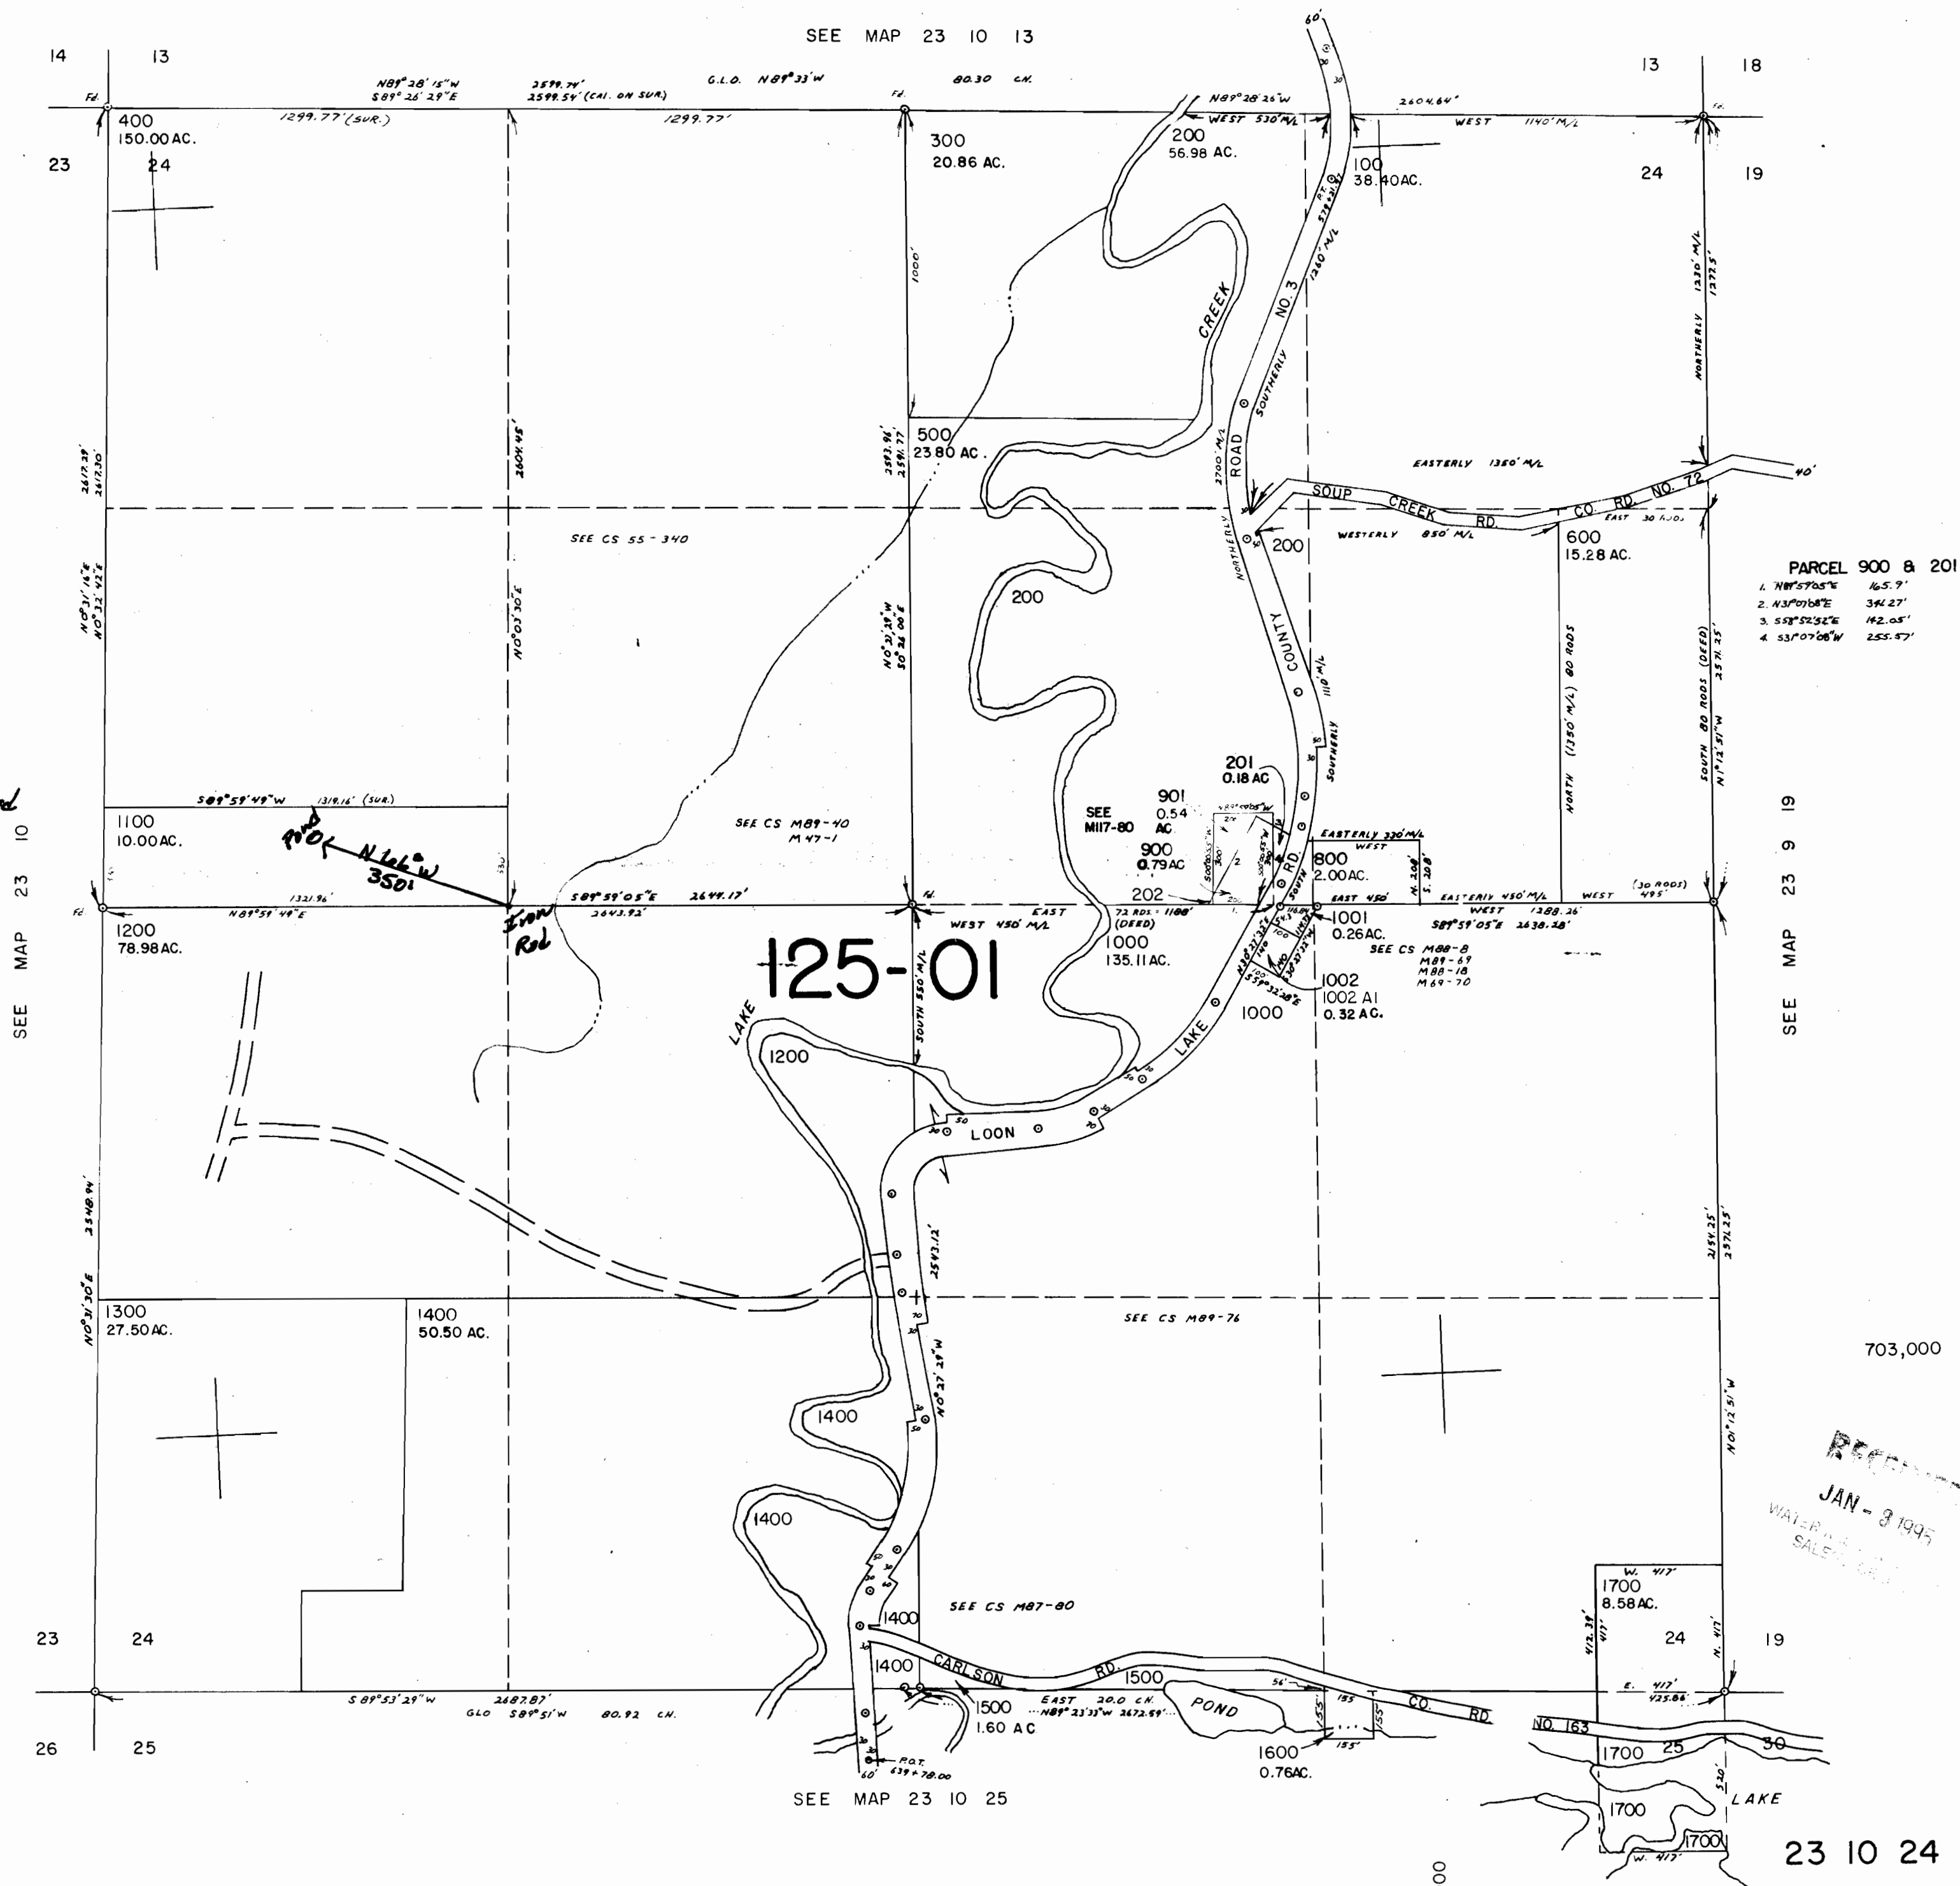

Measuring from Iron Rod
to pond $\frac{N 66^{\circ} W}{350'}$

703,000

RECEIVED
JAN - 3 1995

23 10 24