



Application No. R-74381  
Permit No.

JAMIESON QUADRANGLE  
OREGON-MALHEUR CO.  
7.5 MINUTE SERIES (TOPOGRAPHIC)

CERTIFICATE NO. 70332

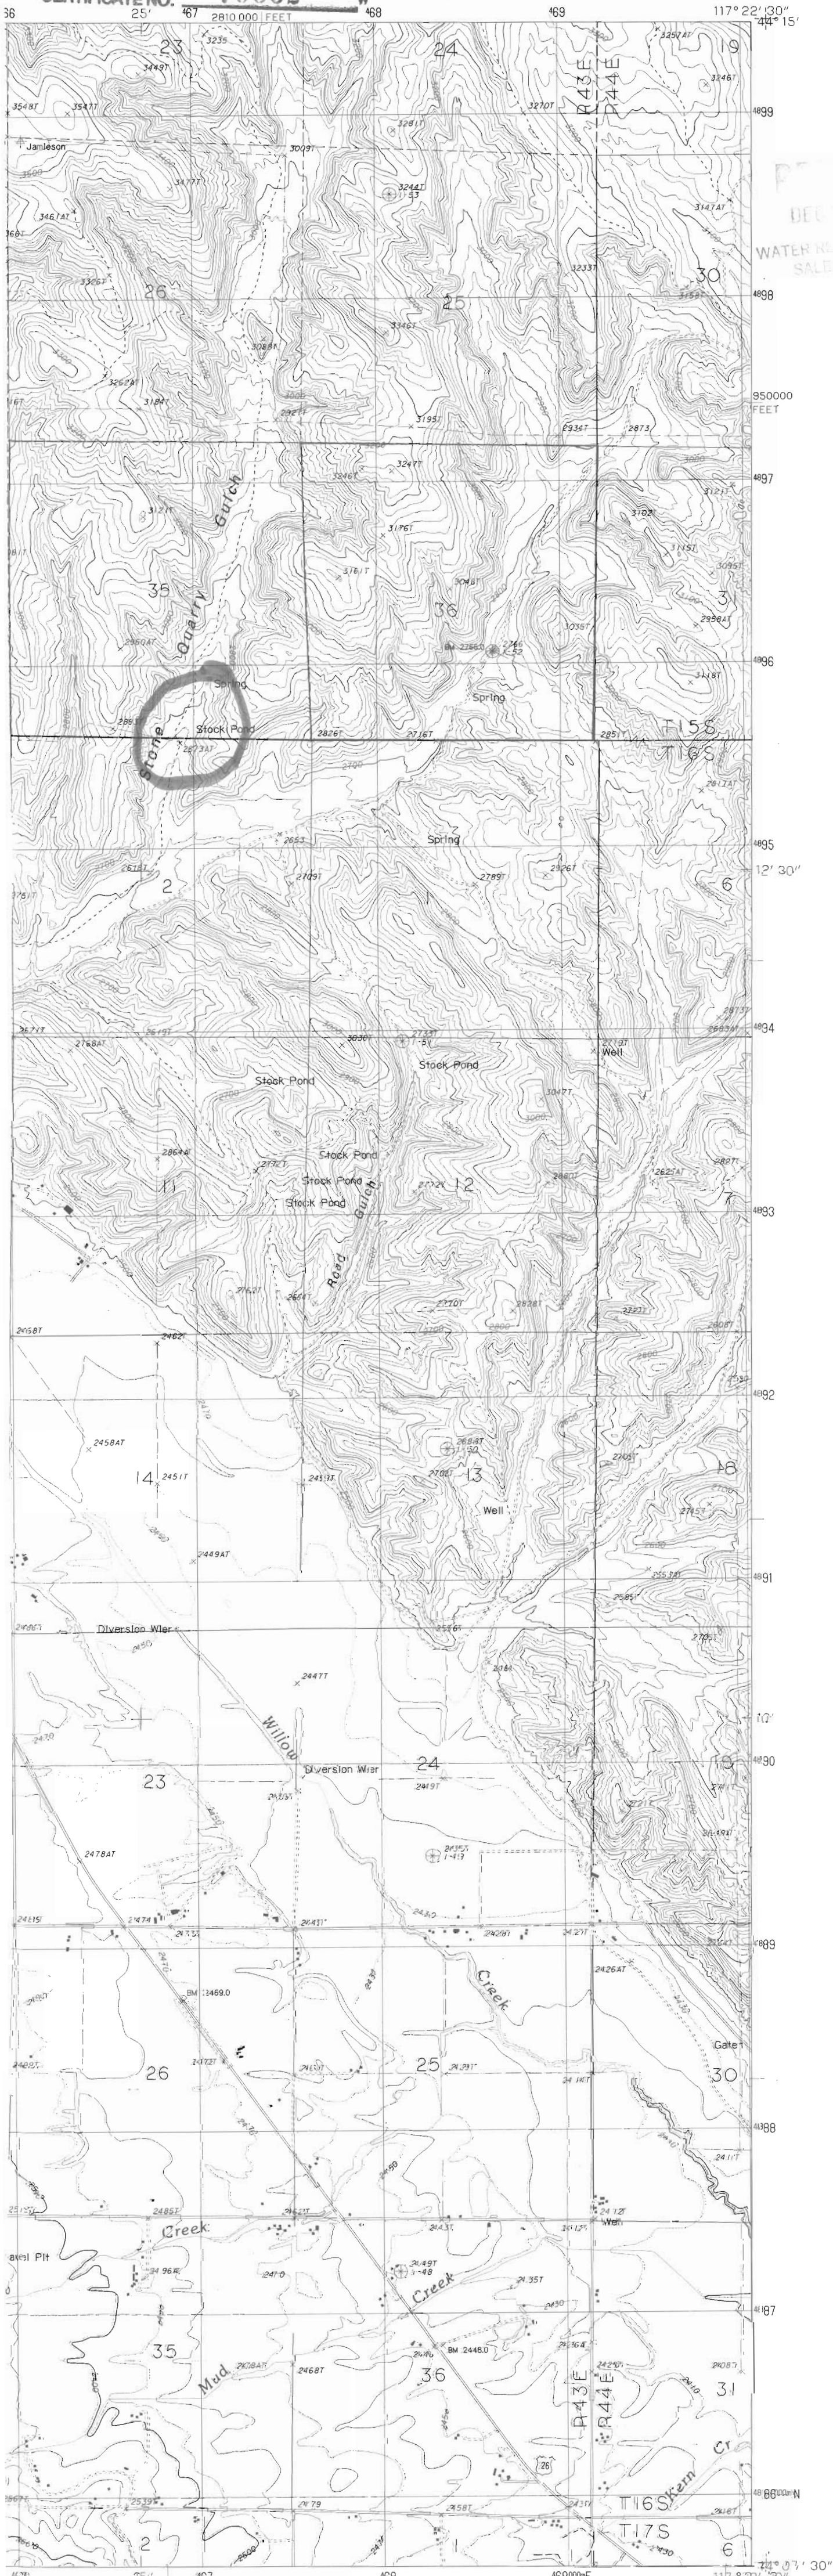

DEC 30 1994  
WATER RESOURCES DIV.  
SALEM, OREGON

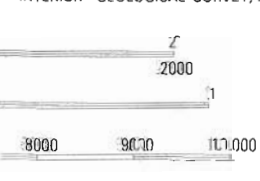

- ROAD LEGEND
- Improved Road
  - Unimproved Road
  - Trail
  - Interstate Route
  - U. S. Route
  - State Route

|    |    |    |                      |
|----|----|----|----------------------|
| 1. | 2. | 3. | 1 Becker Creek       |
|    |    |    | 2 Birch Creek Meadow |
|    |    |    | 3 Huntington         |
| 4. |    | 5. | 4 Brogan             |
|    |    |    | 5 McCarthy Ridge     |
|    |    |    | 6 Swede Flat         |
| 6. | 7. | 8. | 7 Hope Butte         |
|    |    |    | 8 Willowcreek        |

JAMIESON, OREGON  
PROVISIONAL EDITION, 1988


IDS  
ESTON, VIRGINIA 22092

ADJOINING 7.5' QUADRANGLE NAMES

44117-B4-TF-024

Application No. R 76381  
Permit No. 70332

WILLOWCREEK QUADRANGLE  
OREGON-MALHEUR CO.  
7.5 MINUTE SERIES (TOPOGRAPHIC)

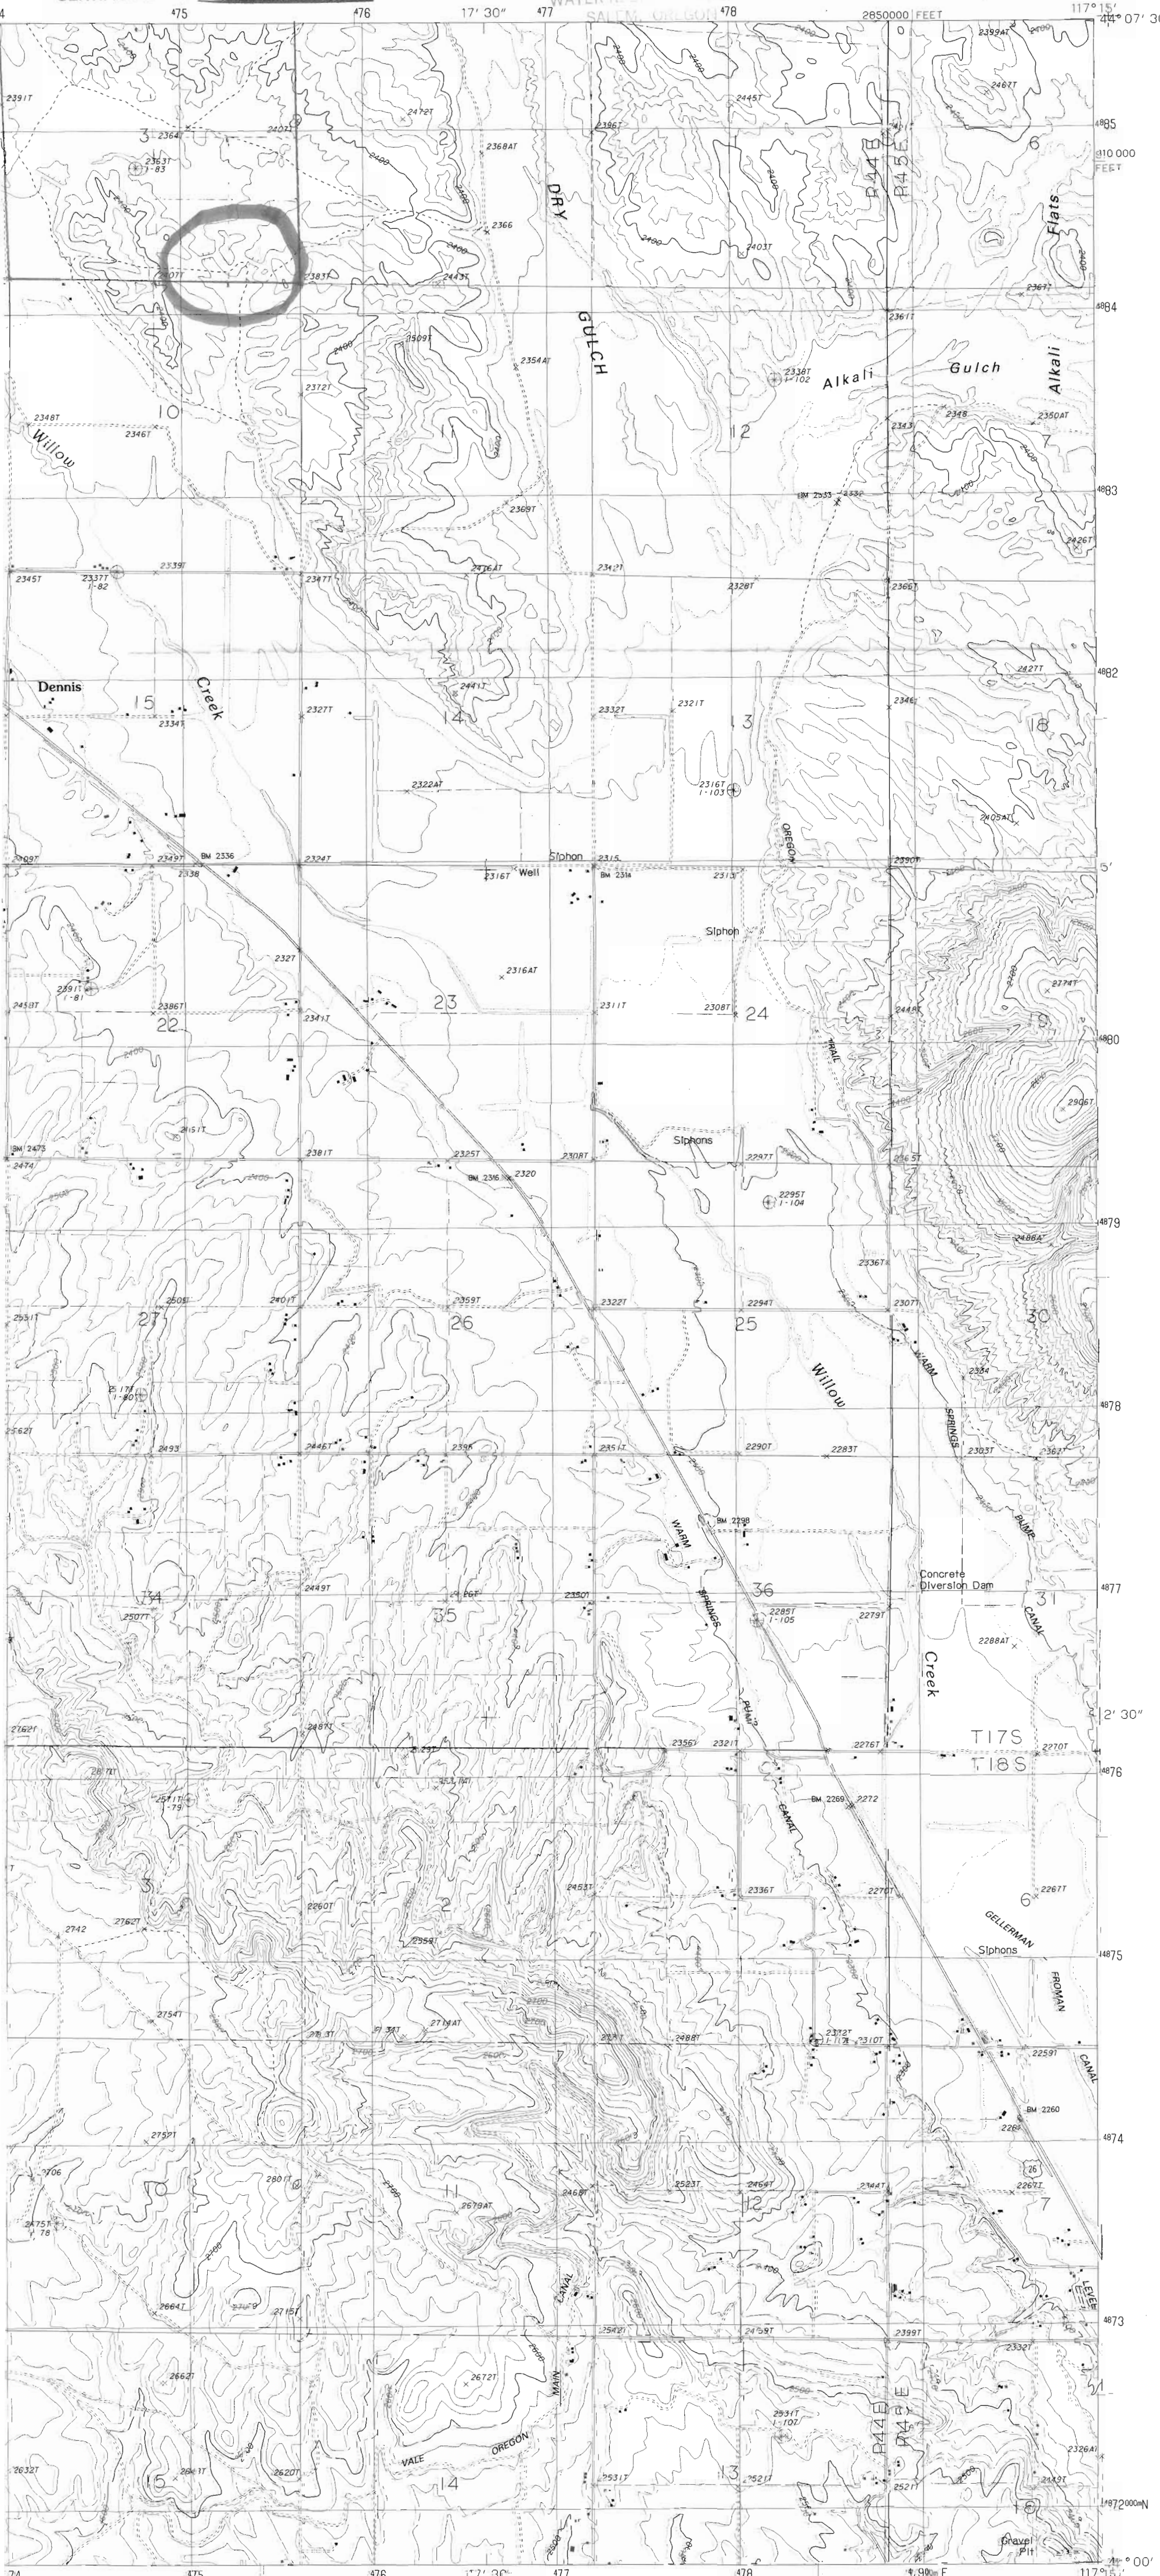

SCALE 1:24 000

0 1 2 KILOMETERS  
0 1000 METERS  
0 1 MILES  
2000 3000 4000 5000 6000 7000 8000 9000 10 000 FEET

CONTOUR INTERVAL 20 FEET  
SUPPLEMENTARY CONTOUR INTERVAL 10 FEET

To convert feet to meters multiply by .3048  
To convert meters to feet multiply by 3.2808

MAP COMPLIES WITH NATIONAL MAP ACCURACY STANDARDS  
FOR SALE BY U.S. GEOLOGICAL SURVEY  
ENVER, COLORADO 80225, OR RESTON, VIRGINIA 22092

QUADRANGLE LOCATION

ROAD LEGEND

Improved Road  
Unimproved Road  
Trail

In Interstate Route U.S. Route State Route

|   |   |   |   |
|---|---|---|---|
| 4 |   | 5 |   |
| 6 | 7 | 8 |   |

WILLOWCREEK, OREGON

PROVISIONAL EDITION 1988

44117-43-TF-024