


SECTION 35 T.30S. R.6W. W.M.
DOUGLAS COUNTY
1" = 400'

CERTIFICATE NO. 70844

This map was prepared for
assessment purpose only.

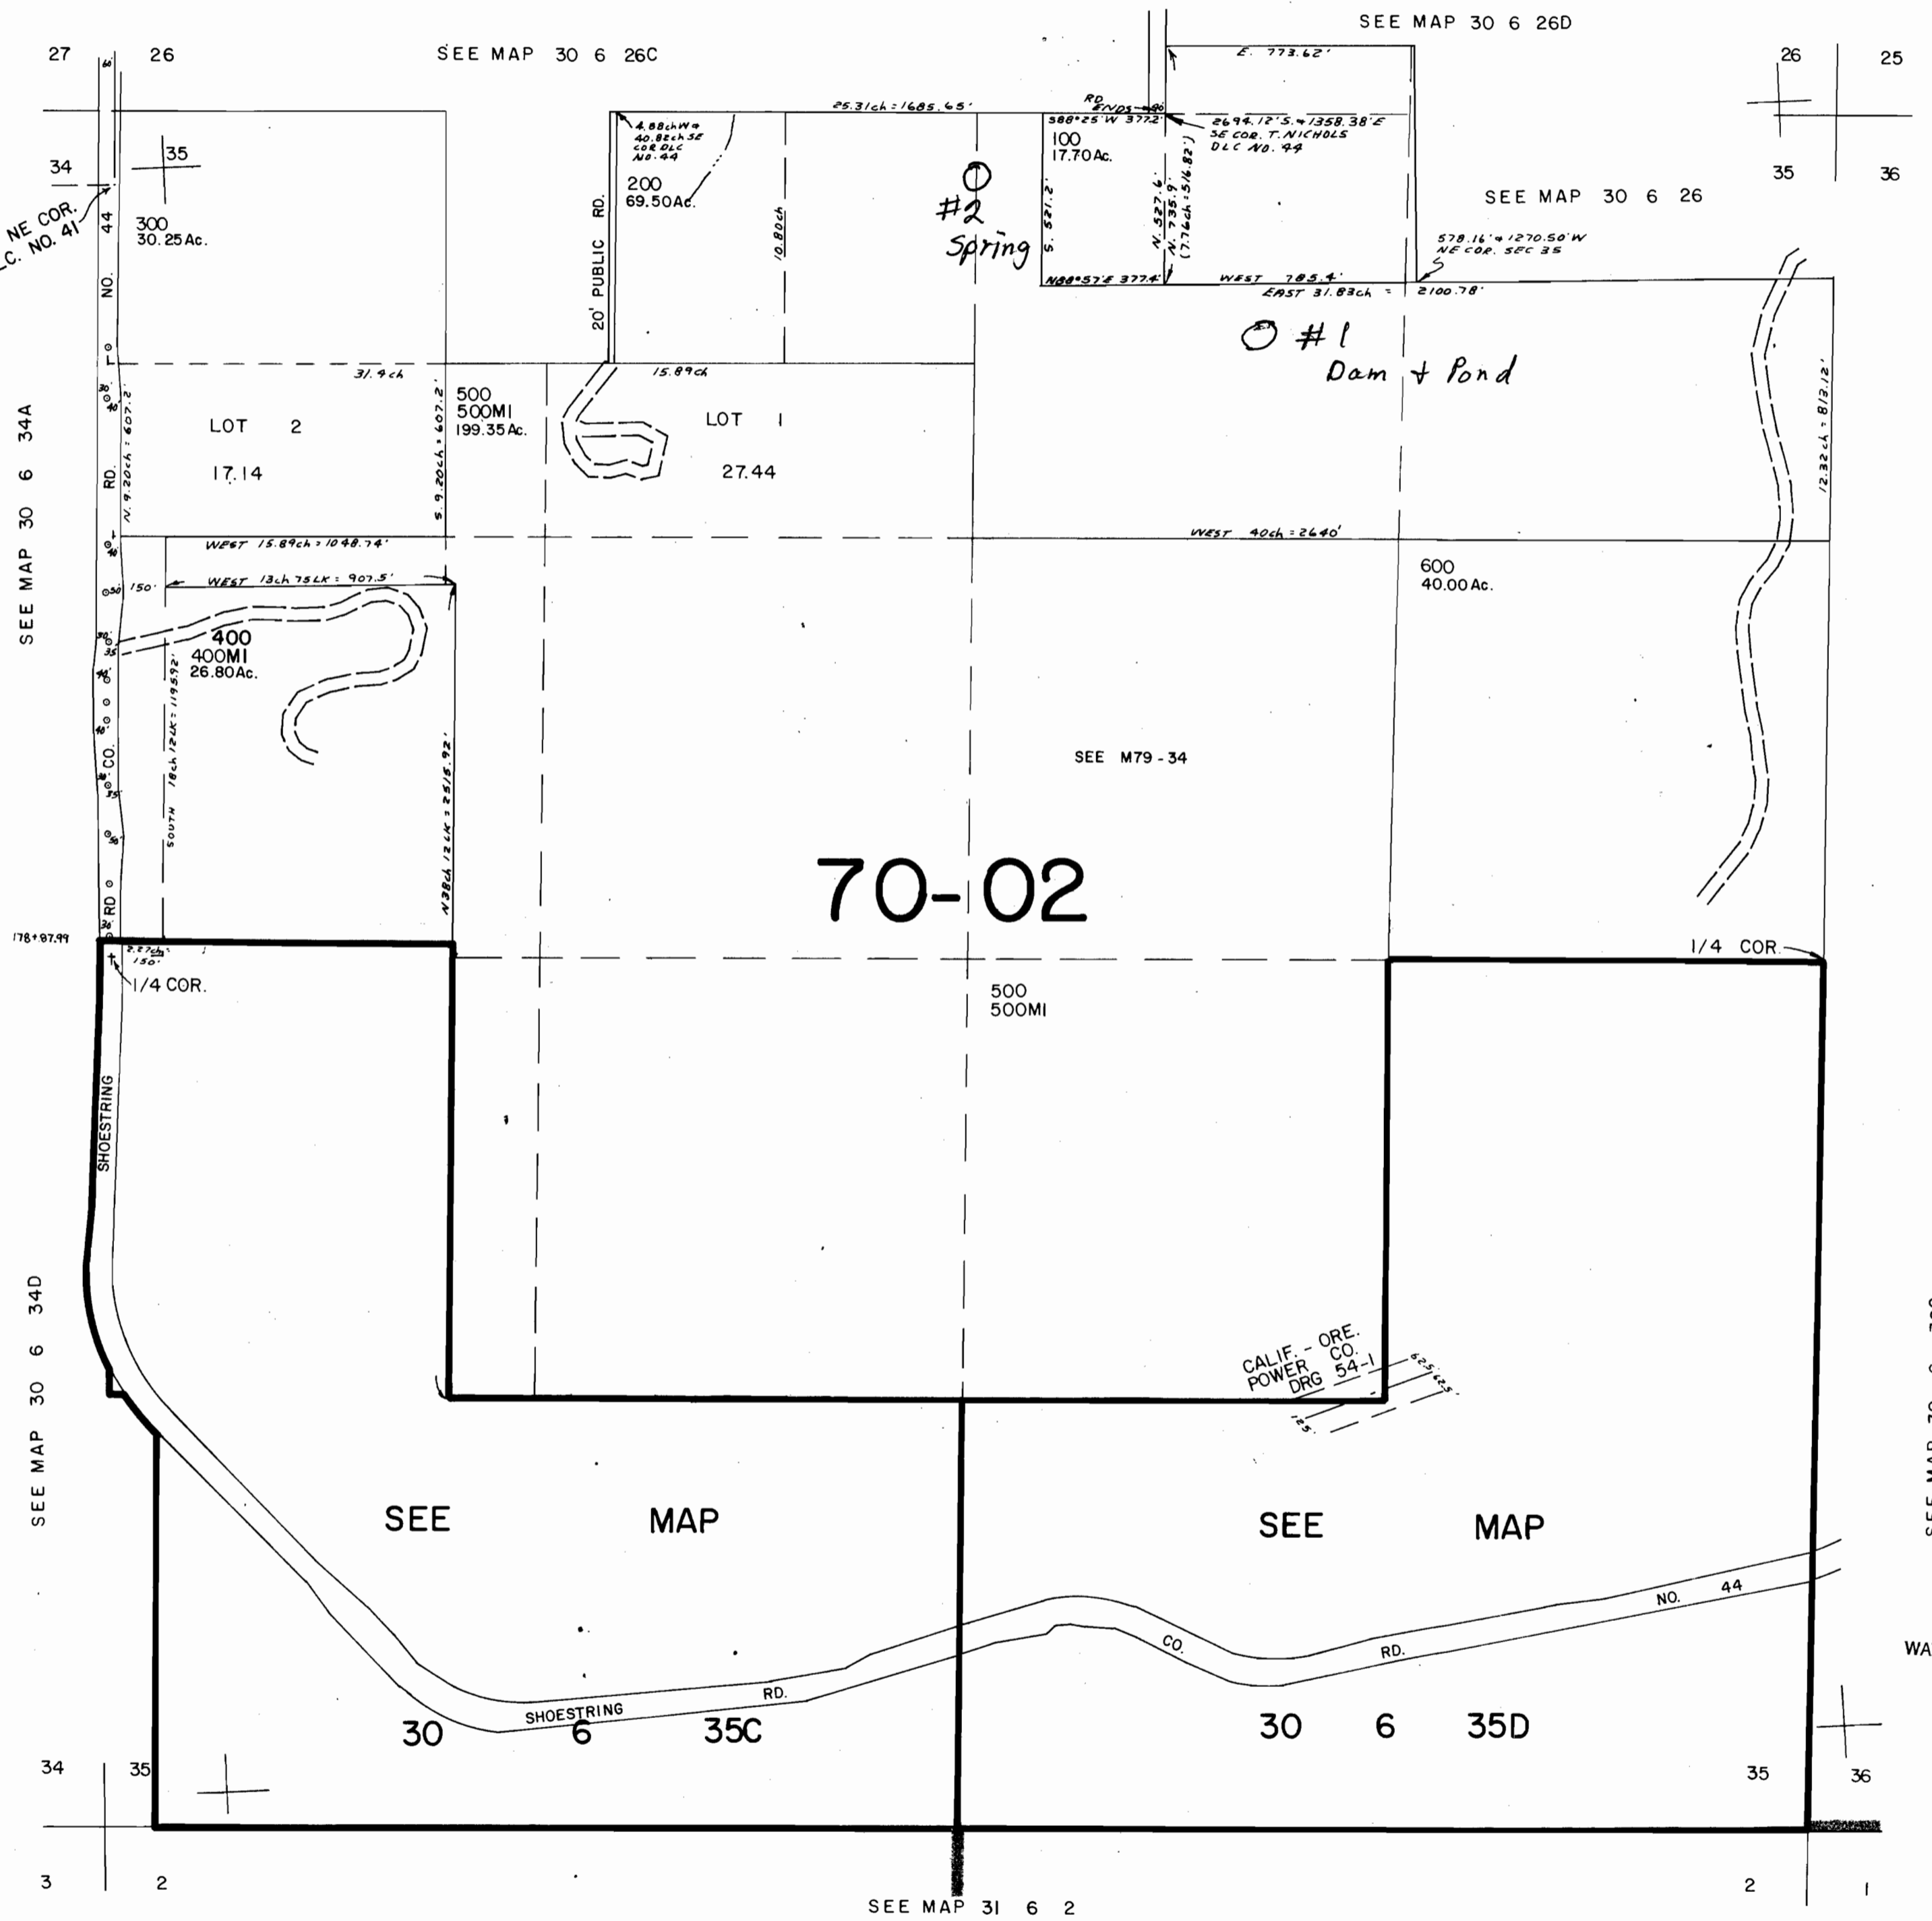

REC
JAN - 3 1995
WATER R.
SALEM, OREGON
467,500