

RECEIVED
JAN - 6 1995
WATER RESOURCES DIV.
SALEM, OREGON

T4S, R40E, Section 14 in the Willamette Meridian Union County, Oregon


Tax Assessor Designation: 45-40E Tax Lot 2700
12-31-94

Property owned by Robert C. & Donna Sheehy


This map is for the purpose of locating a water right and is not intended to provide legal dimensions for locations of property boundaries.



Application No. R-76395
Permit No.

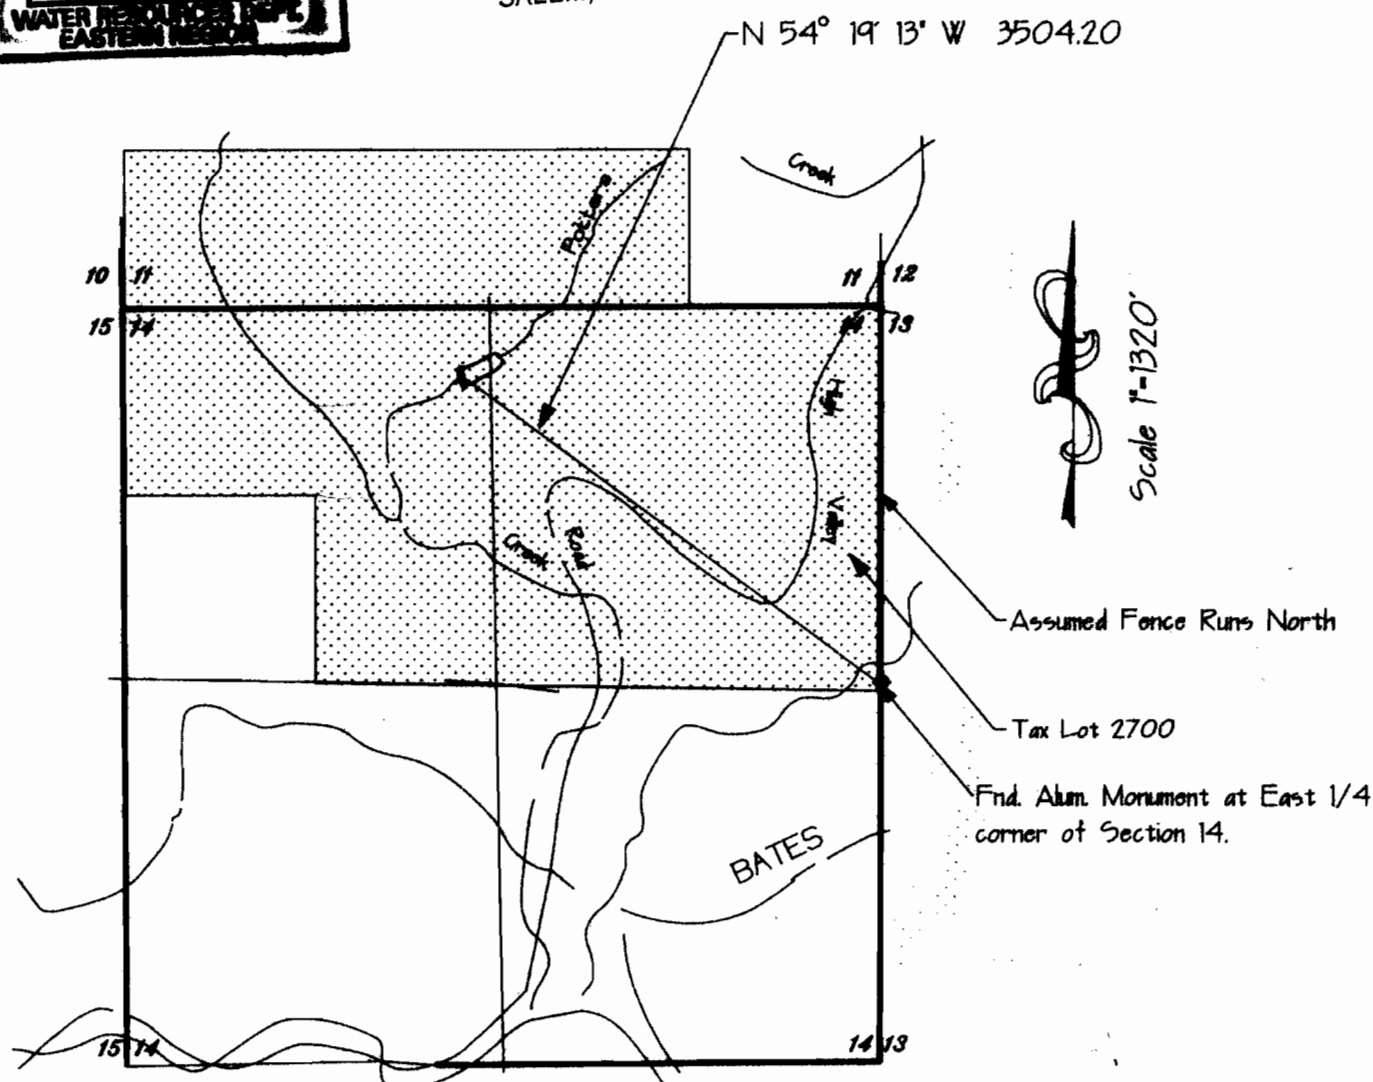


Location Map

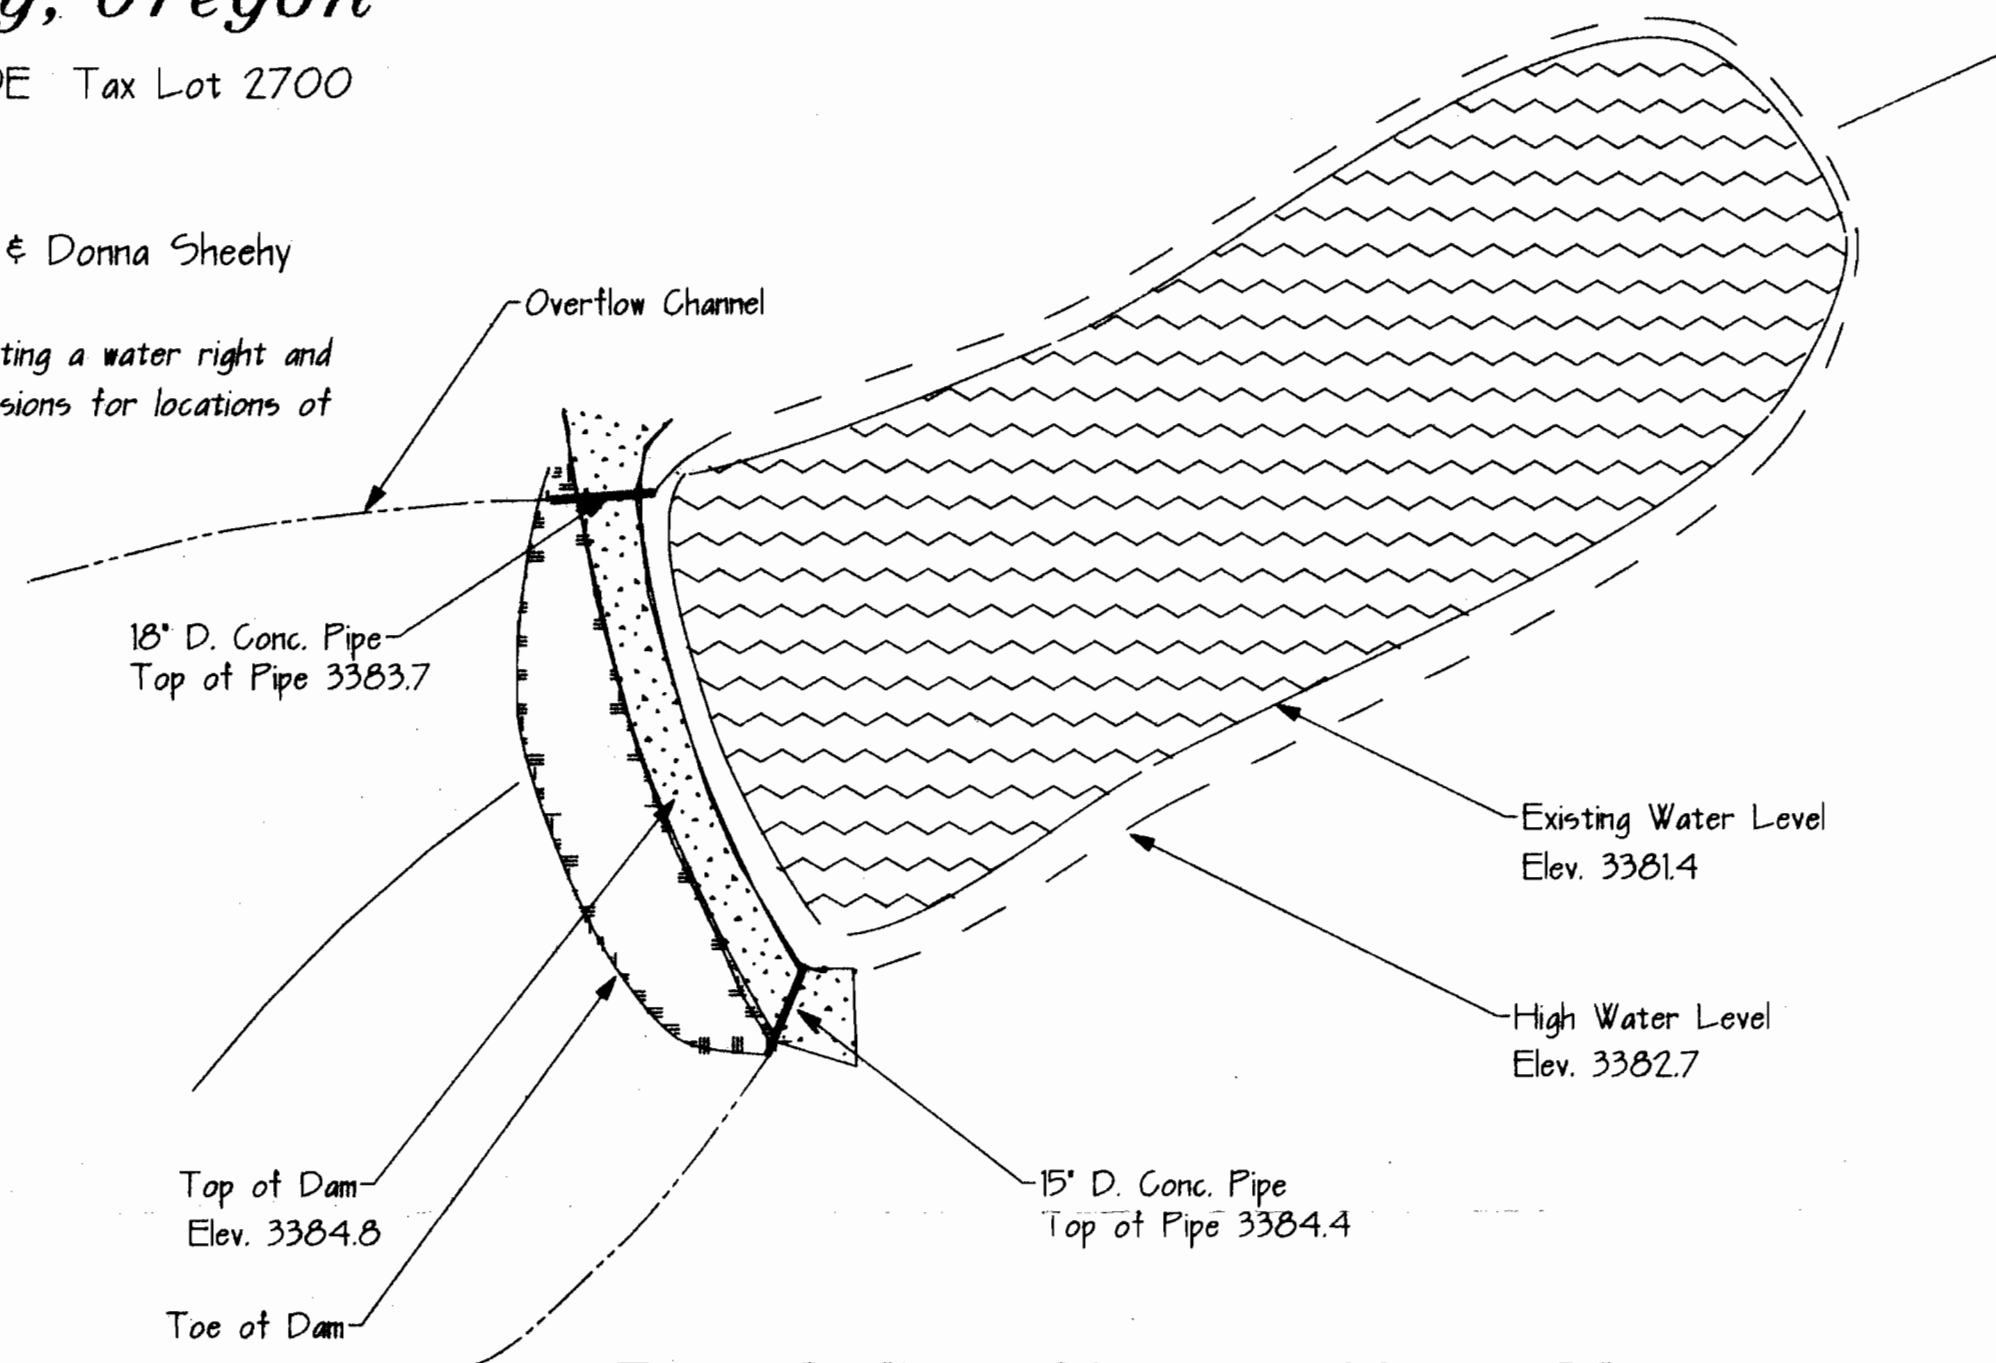

Pond Configuration Map

Dam Profile

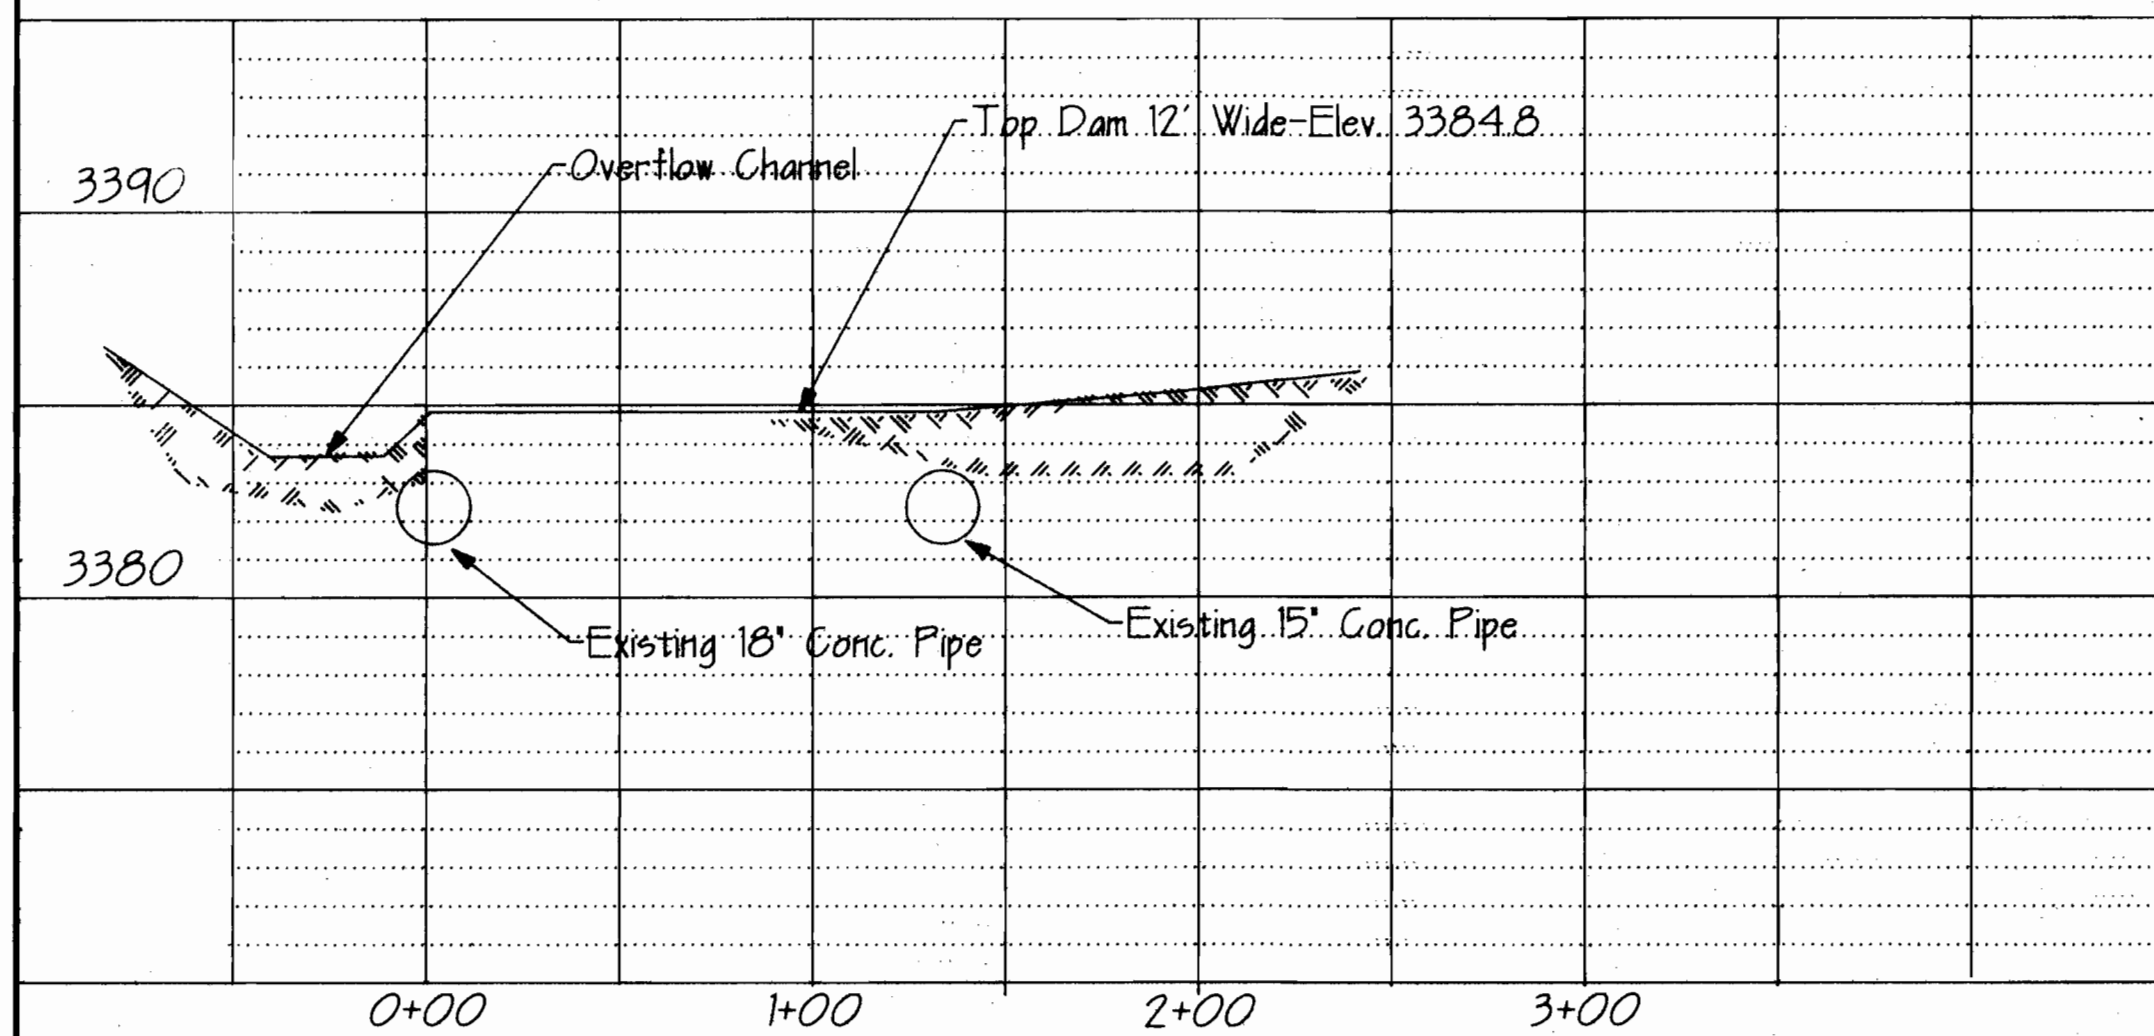

Dam Cross Section

