


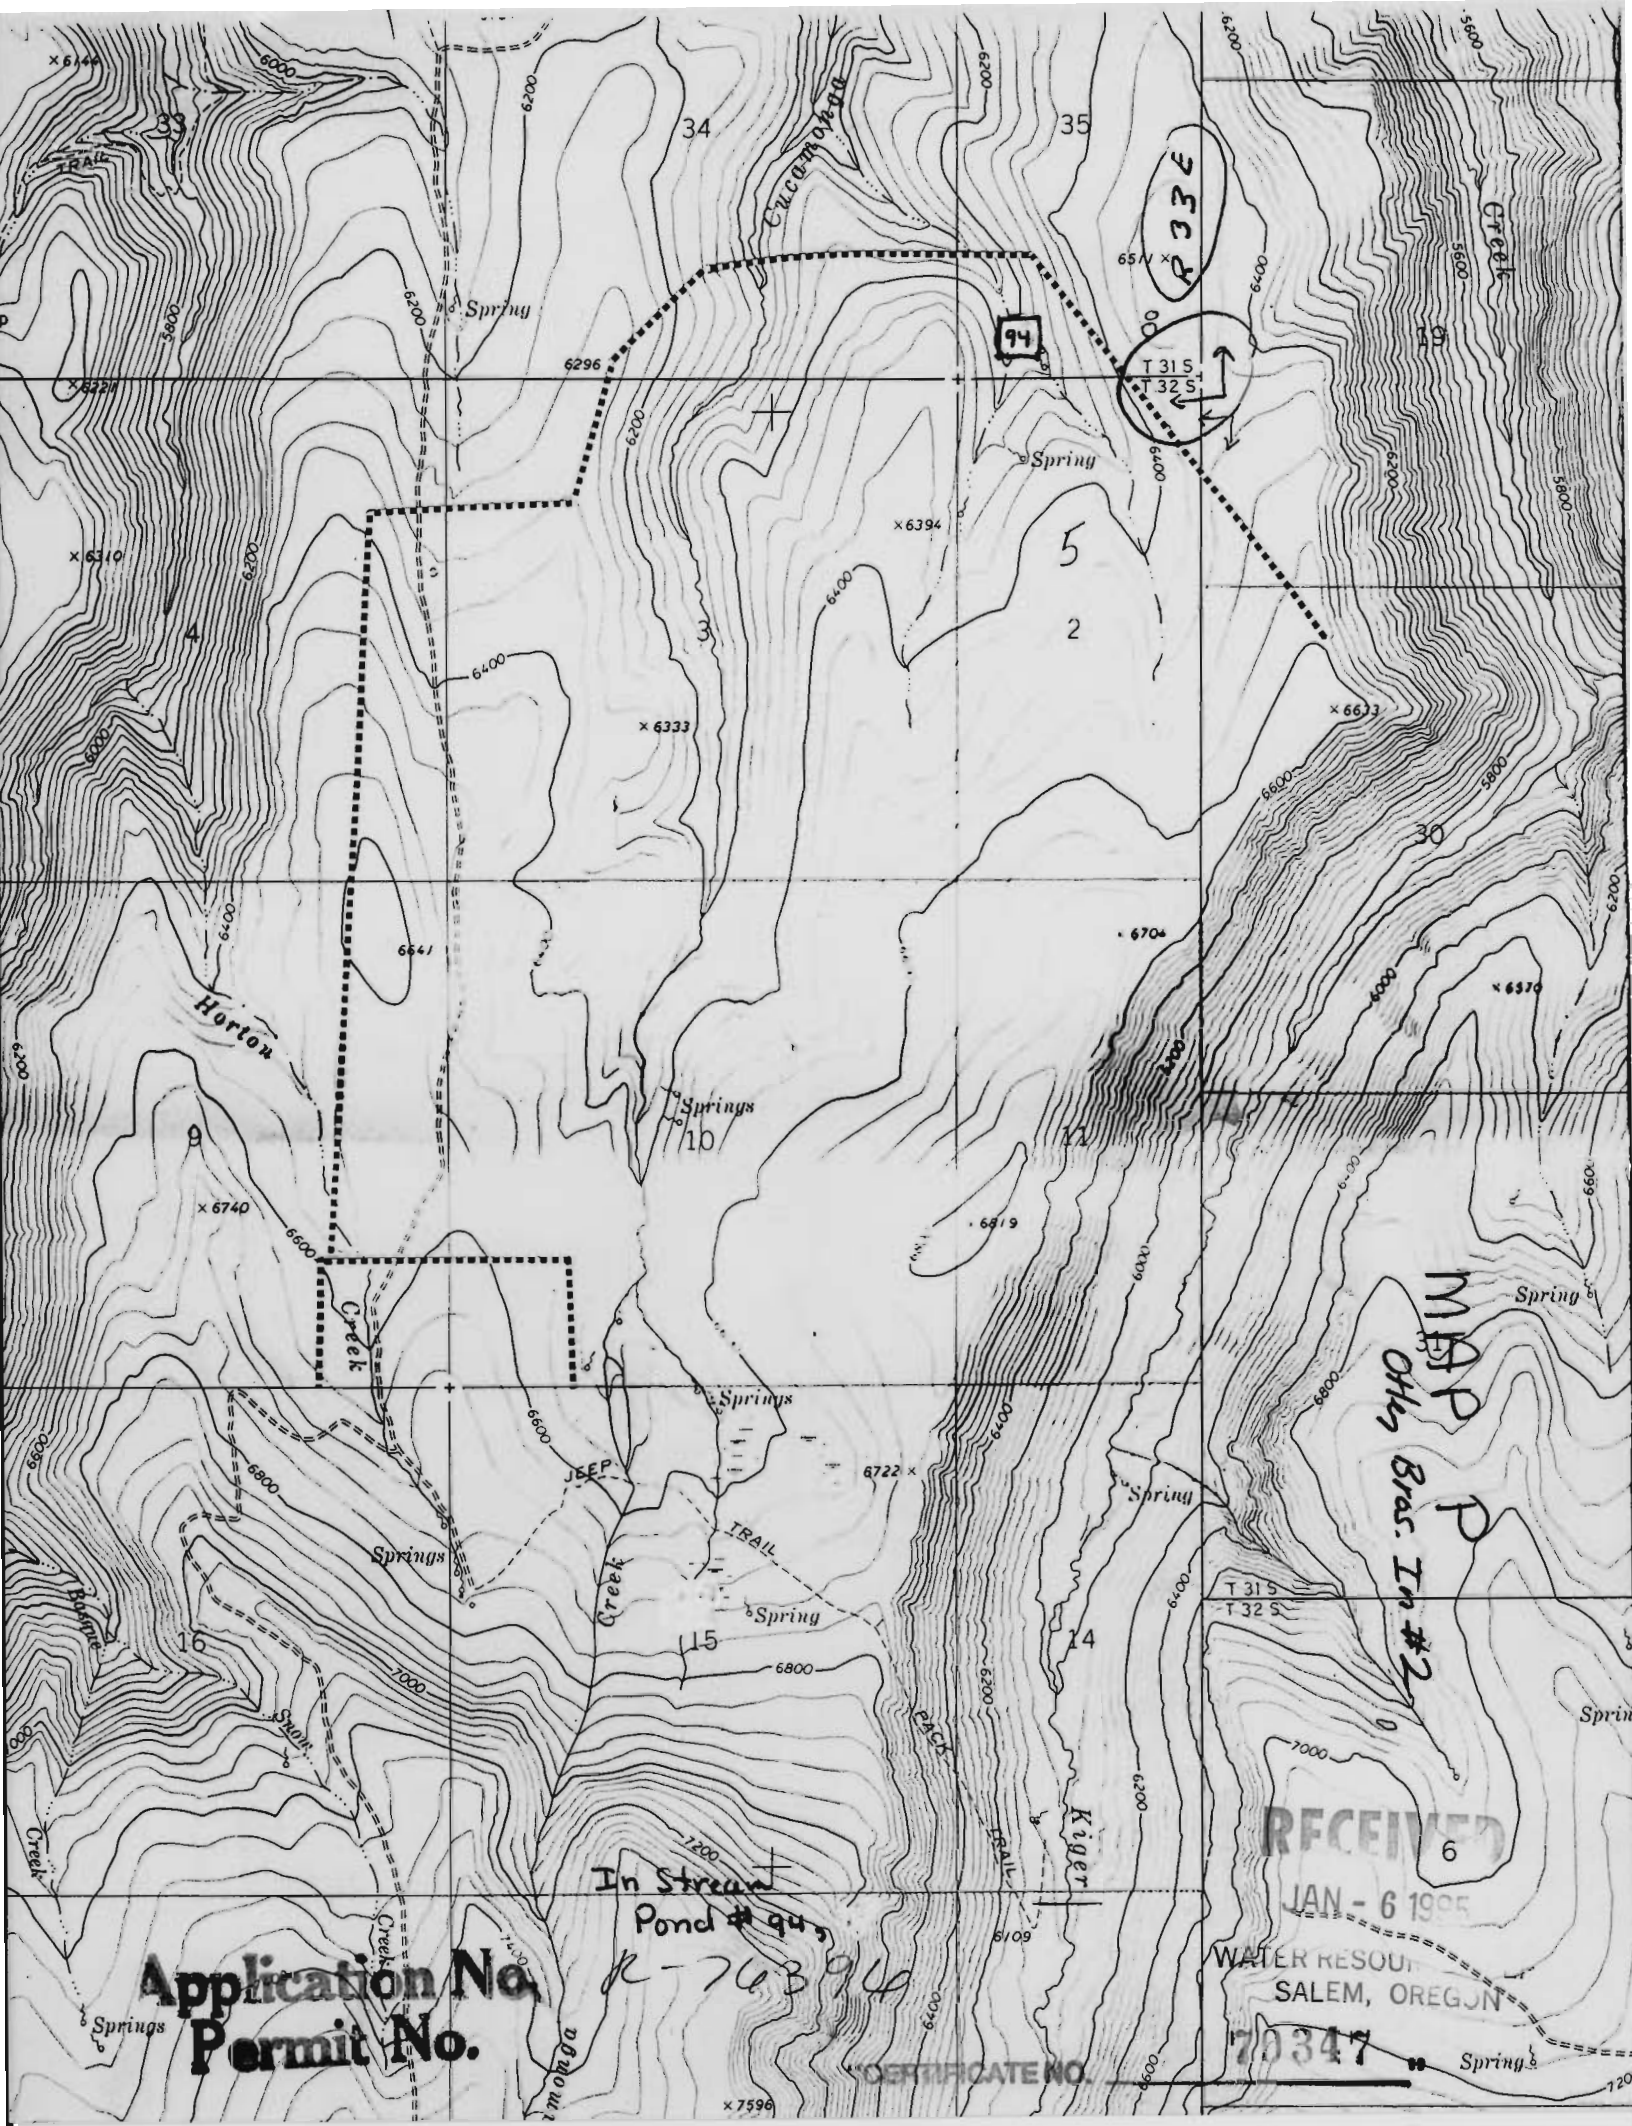

MFP
Other Bros. In #2

RECEIVED 6

JAN - 6 1995


WATER RESOURCES
SALEM, OREGON

70347

CERTIFICATE NO.

Application No.
Permit No.

In Stream
Pond # 94
K-76394

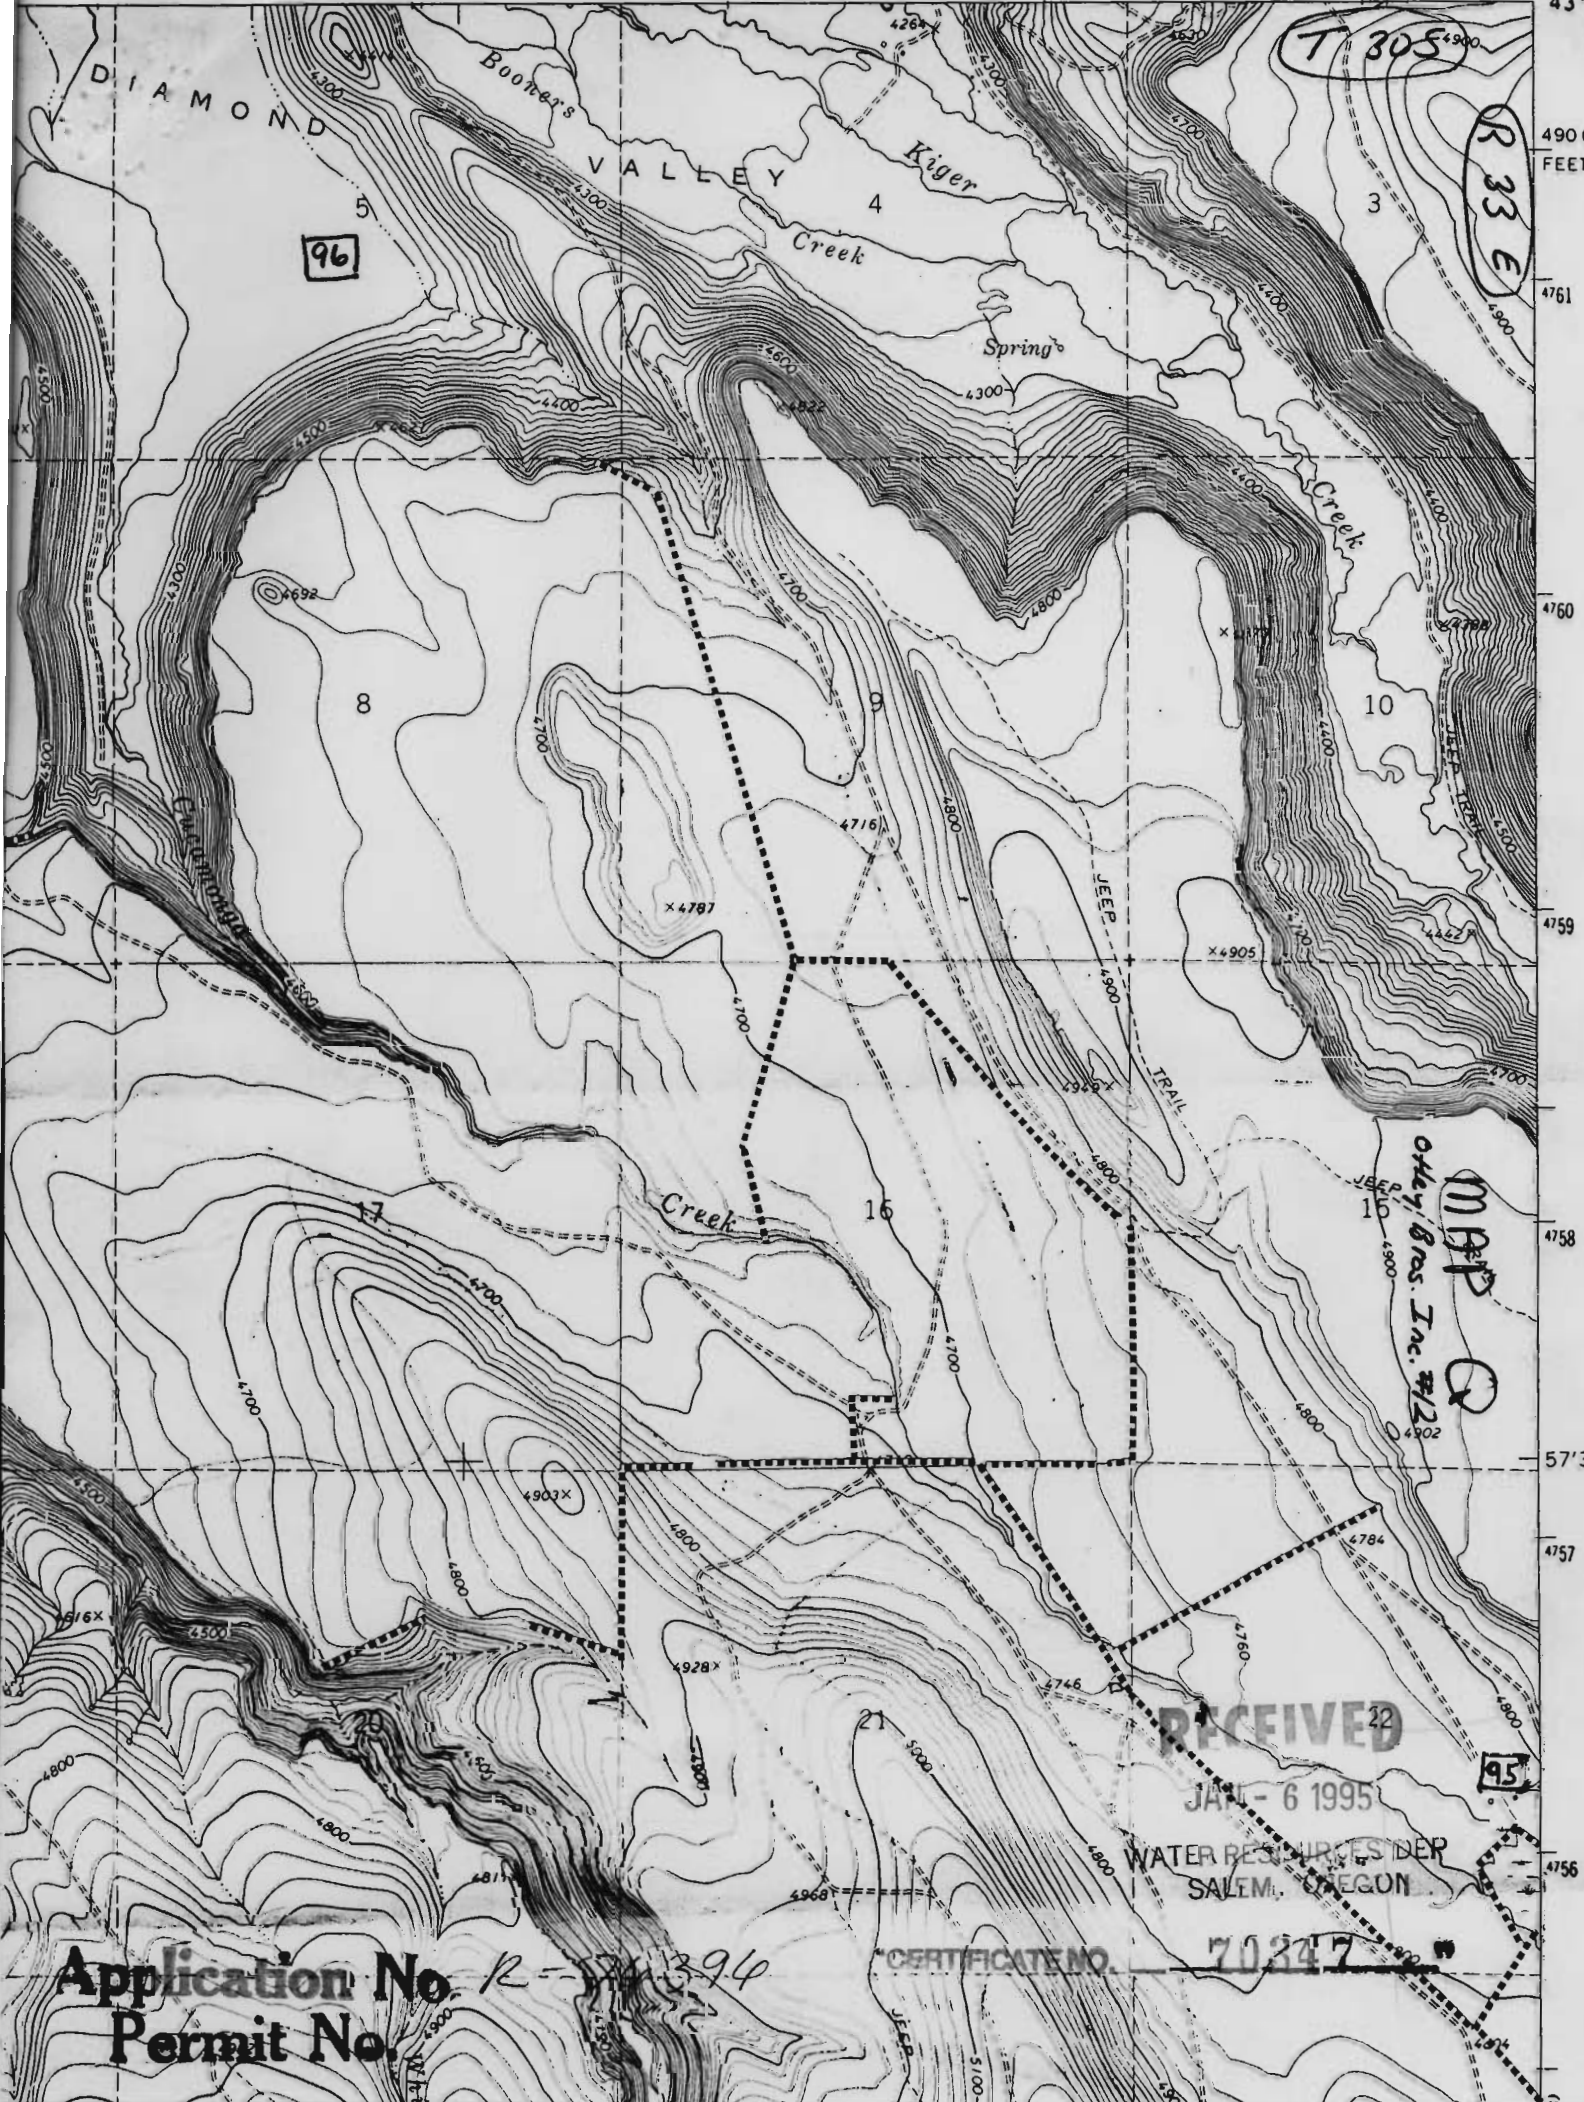

T 305

R 33 E

96

95

MAP Q
Oley Bros Inc. #12

RECEIVED

JAN - 6 1995

WATER RESOURCES DEPT
SALEM, OREGON

CERTIFICATE NO.

70347

Application No R-574394
Permit No.