


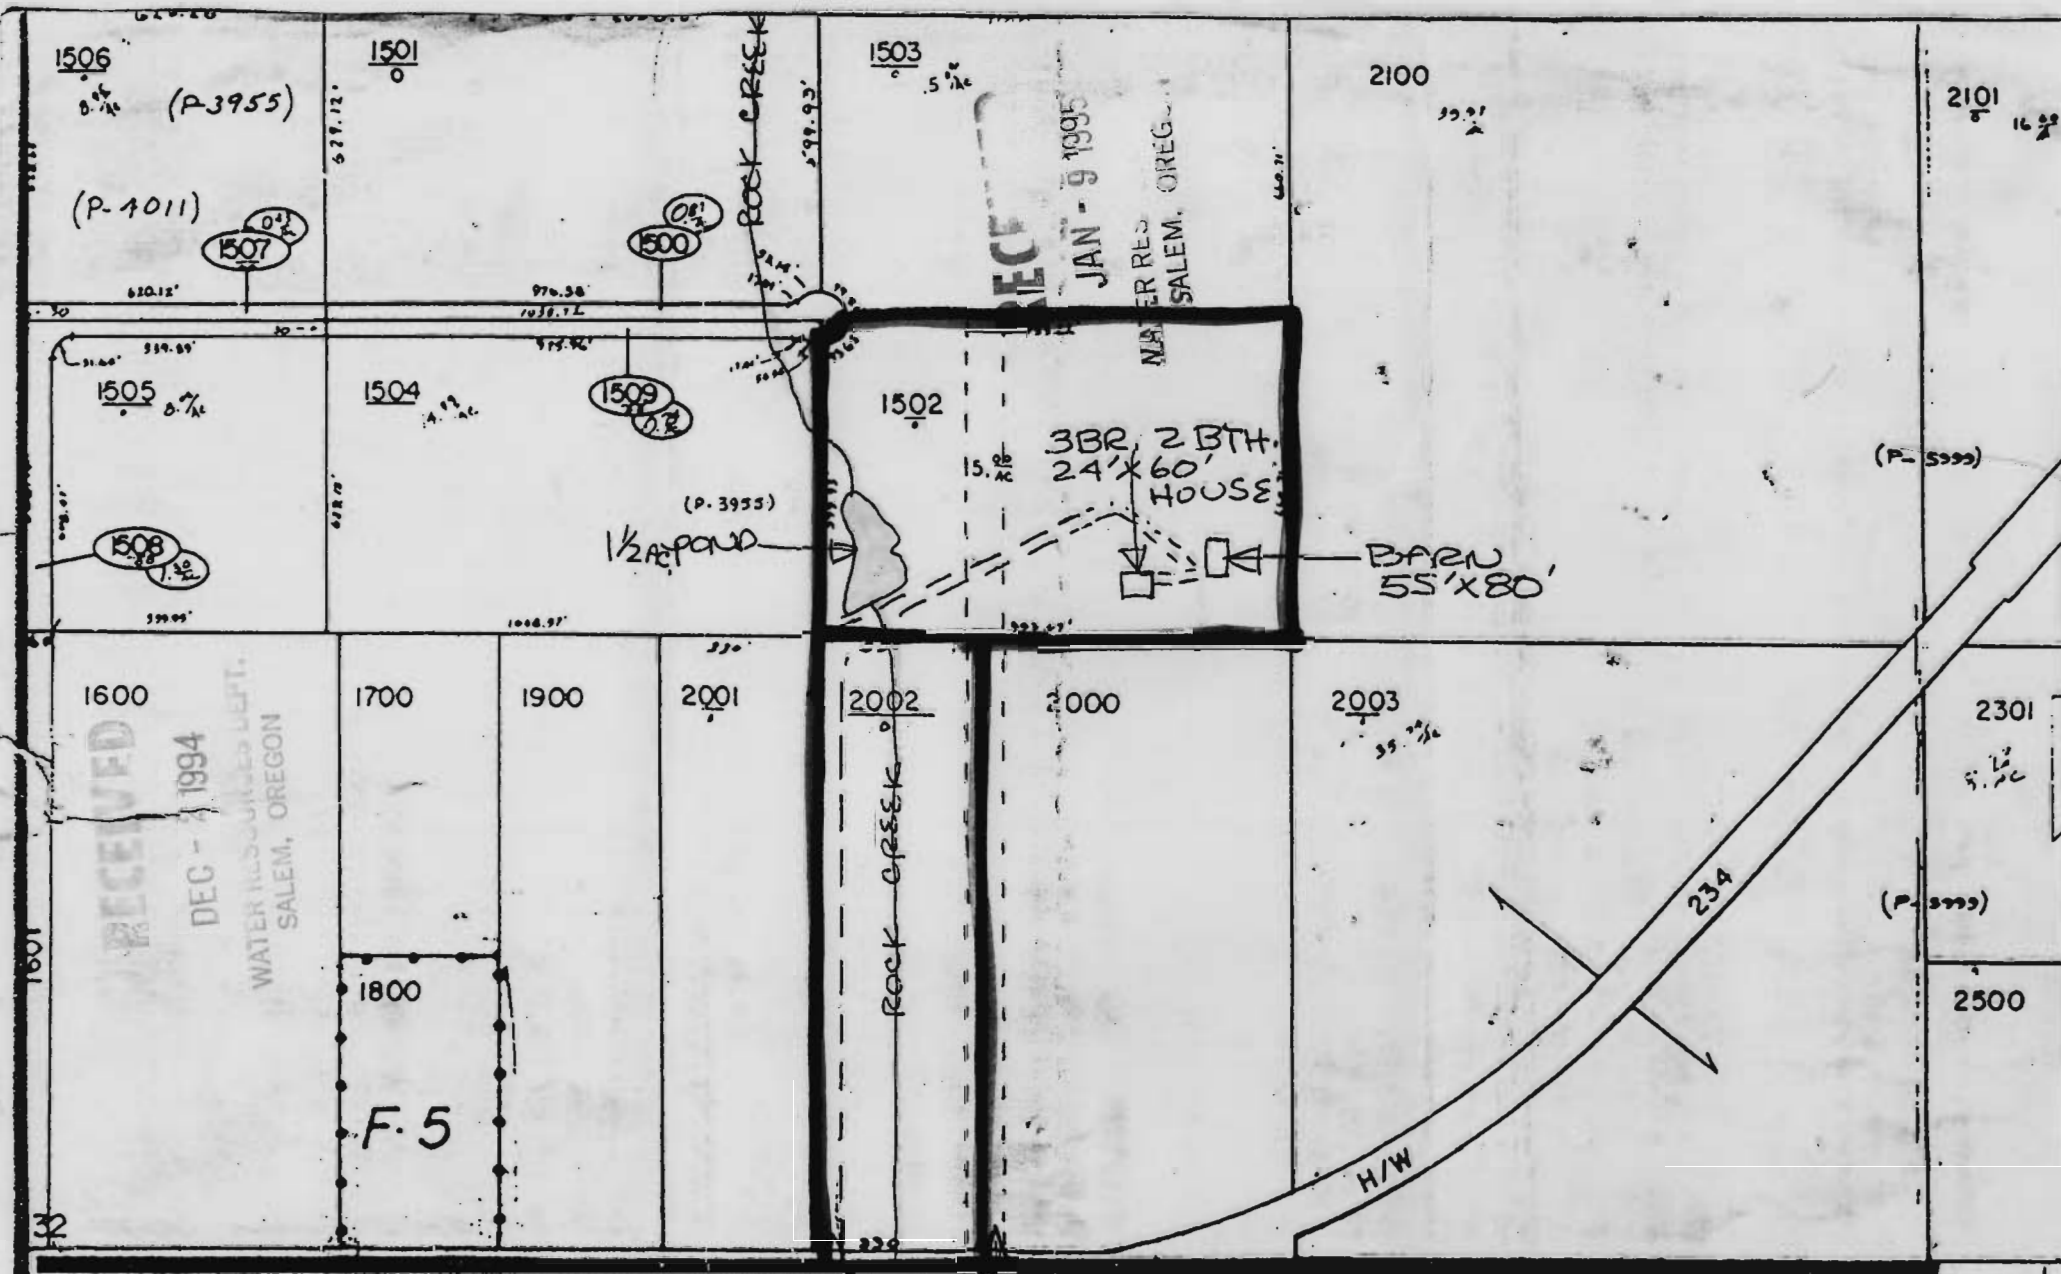

Application No. *P-76402*
 Permit No.

Dan & Janet Crawford
9100 Hwy. 234
Gold Hill, Ore.
97525
(503) 855-1347

35-2W-32

CERTIFICATE NO. *70351*