

Application No R-76408
Permit No.


RECEIVED

JAN - 9 1995

"CERTIFICATE NO. 70356"

HARNEY QUADRANGLE
OREGON-HARNEY CO.
7.5 MINUTE SERIES (TOPOGRAPHIC)

WATER RESOURCES DEP.
SALEM, OREGON

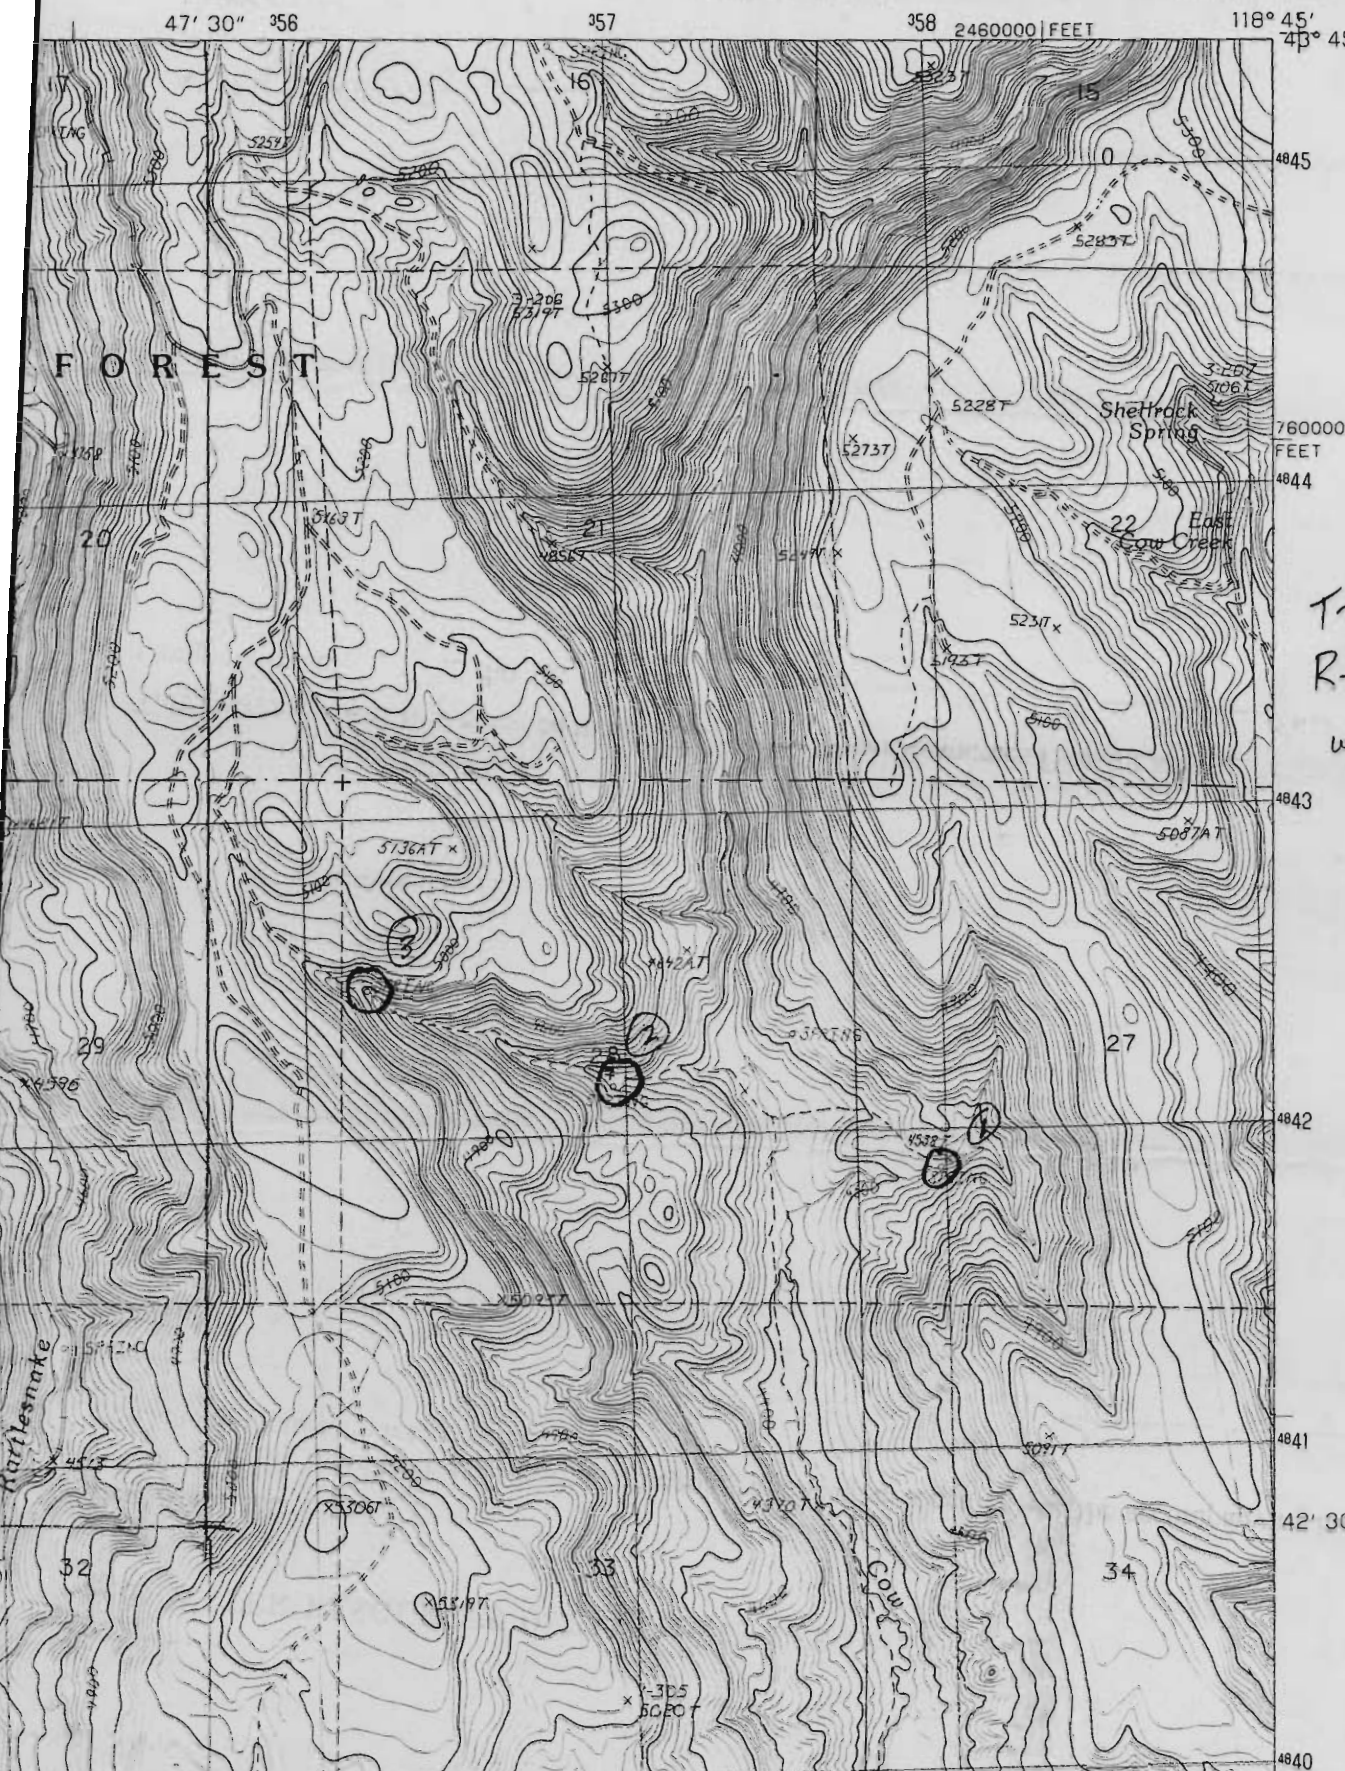

T-21-S
R-32 1/2 E
W.H. Beal