


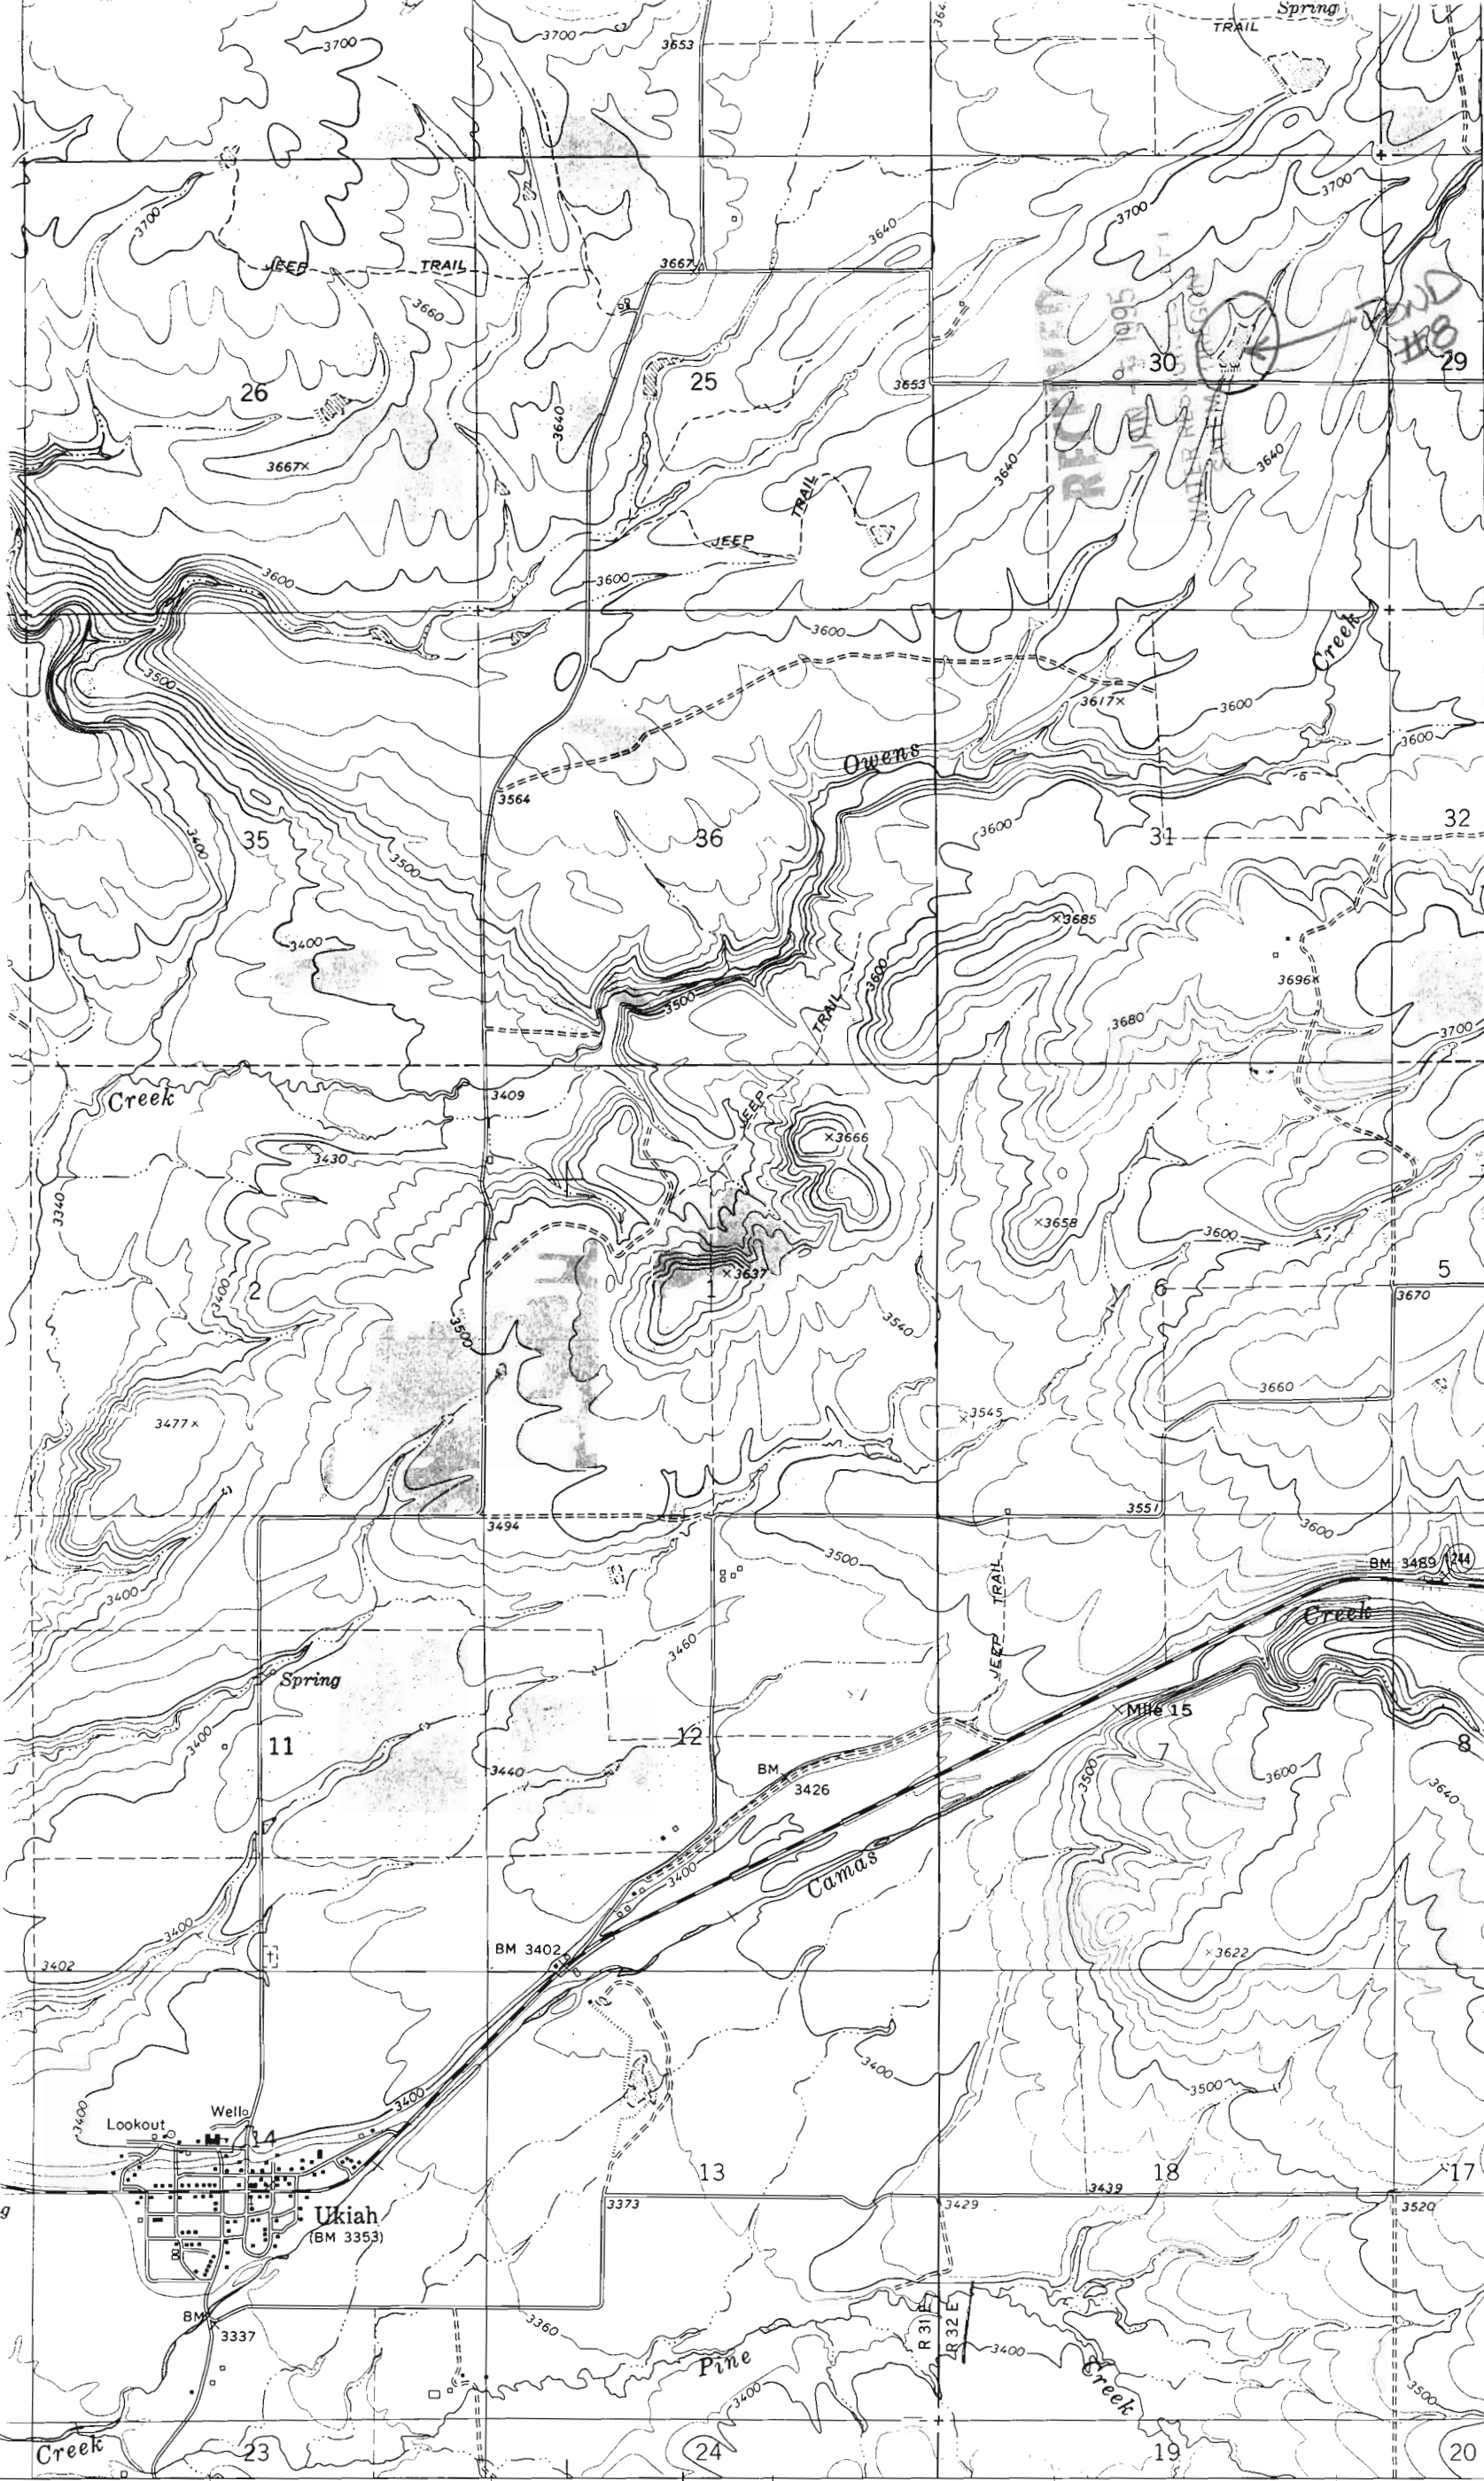

2-74 40 7

Application No.
Permit No.


CERTIFICATE NO. 70357

OWENS BUTTE
2274 III NE

T. 4 S.
T. 5 S.

LEHMAN SPRINGS 13 MI.
LA GRANDE 50 MI.

45°07'30"
118°52'30"
(UKIAH SE)
2274 III SE

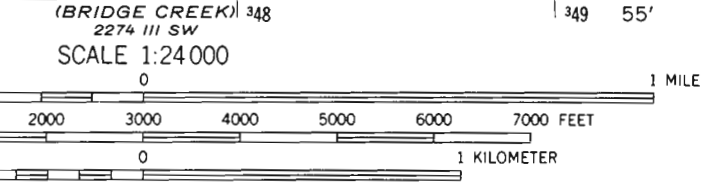

CONTOUR INTERVAL 20 FEET
DATUM IS MEAN SEA LEVEL



ROAD CLASSIFICATION
Medium-duty ——— Light-duty ———
Unimproved dirt - - - - -
U. S. Route (thick line) State Route (thin line)

CONFORMS WITH NATIONAL MAP ACCURACY STANDARDS
PUBLISHED BY THE U.S. GEOLOGICAL SURVEY, DENVER, COLORADO 80225, OR WASHINGTON, D.C. 20242
FOR MORE INFORMATION AND SYMBOLS IS AVAILABLE ON REQUEST

UKIAH, OREG.
N4507.5—W11852.5/7.5
1967