



This map was prepared for assessment purpose only.

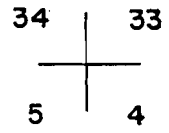

S.E. CORNER
R. WELCH D.L.C.

5.22 ch.

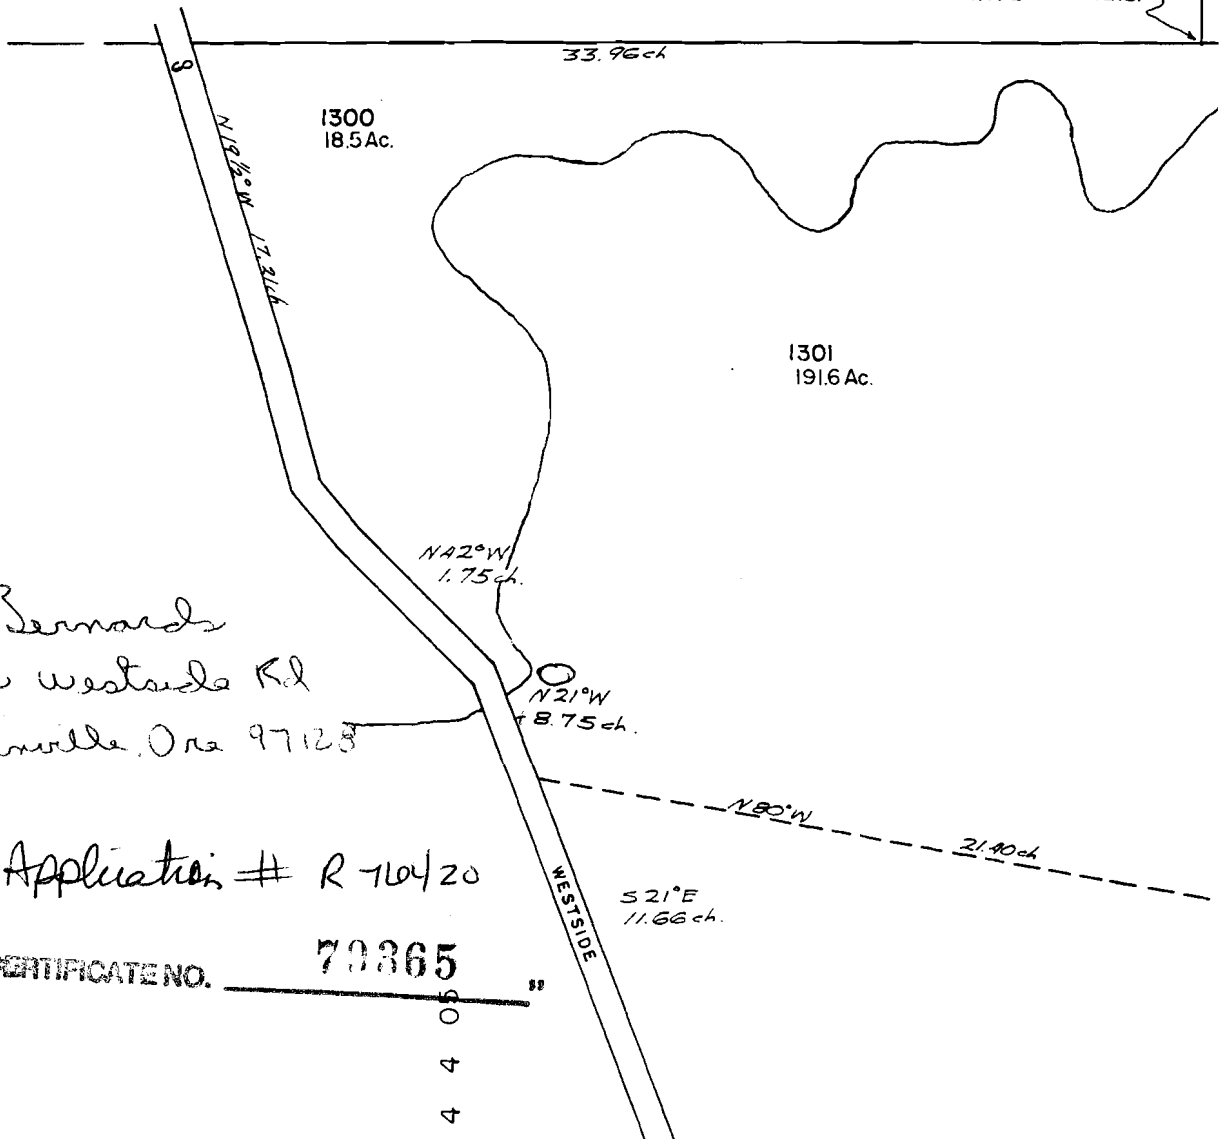

Eugene Bernards
5000 N w westside Rd
Mc Minnville, Ore 97128

Application # R 76420

"CERTIFICATE NO. 70365"

4
4
4
0
5