


# ROY GAMMELL PONDS

LOCATED IN SE 1/4 OF SW 1/4 SECT 18,  
SW 1/4 OF SE 1/4 SECT 18,  
AND IN THE NW 1/4 OF NE 1/4 SECT 19  
T 14 S, R 2 W, W.M.  
LINN COUNTY, OREGON

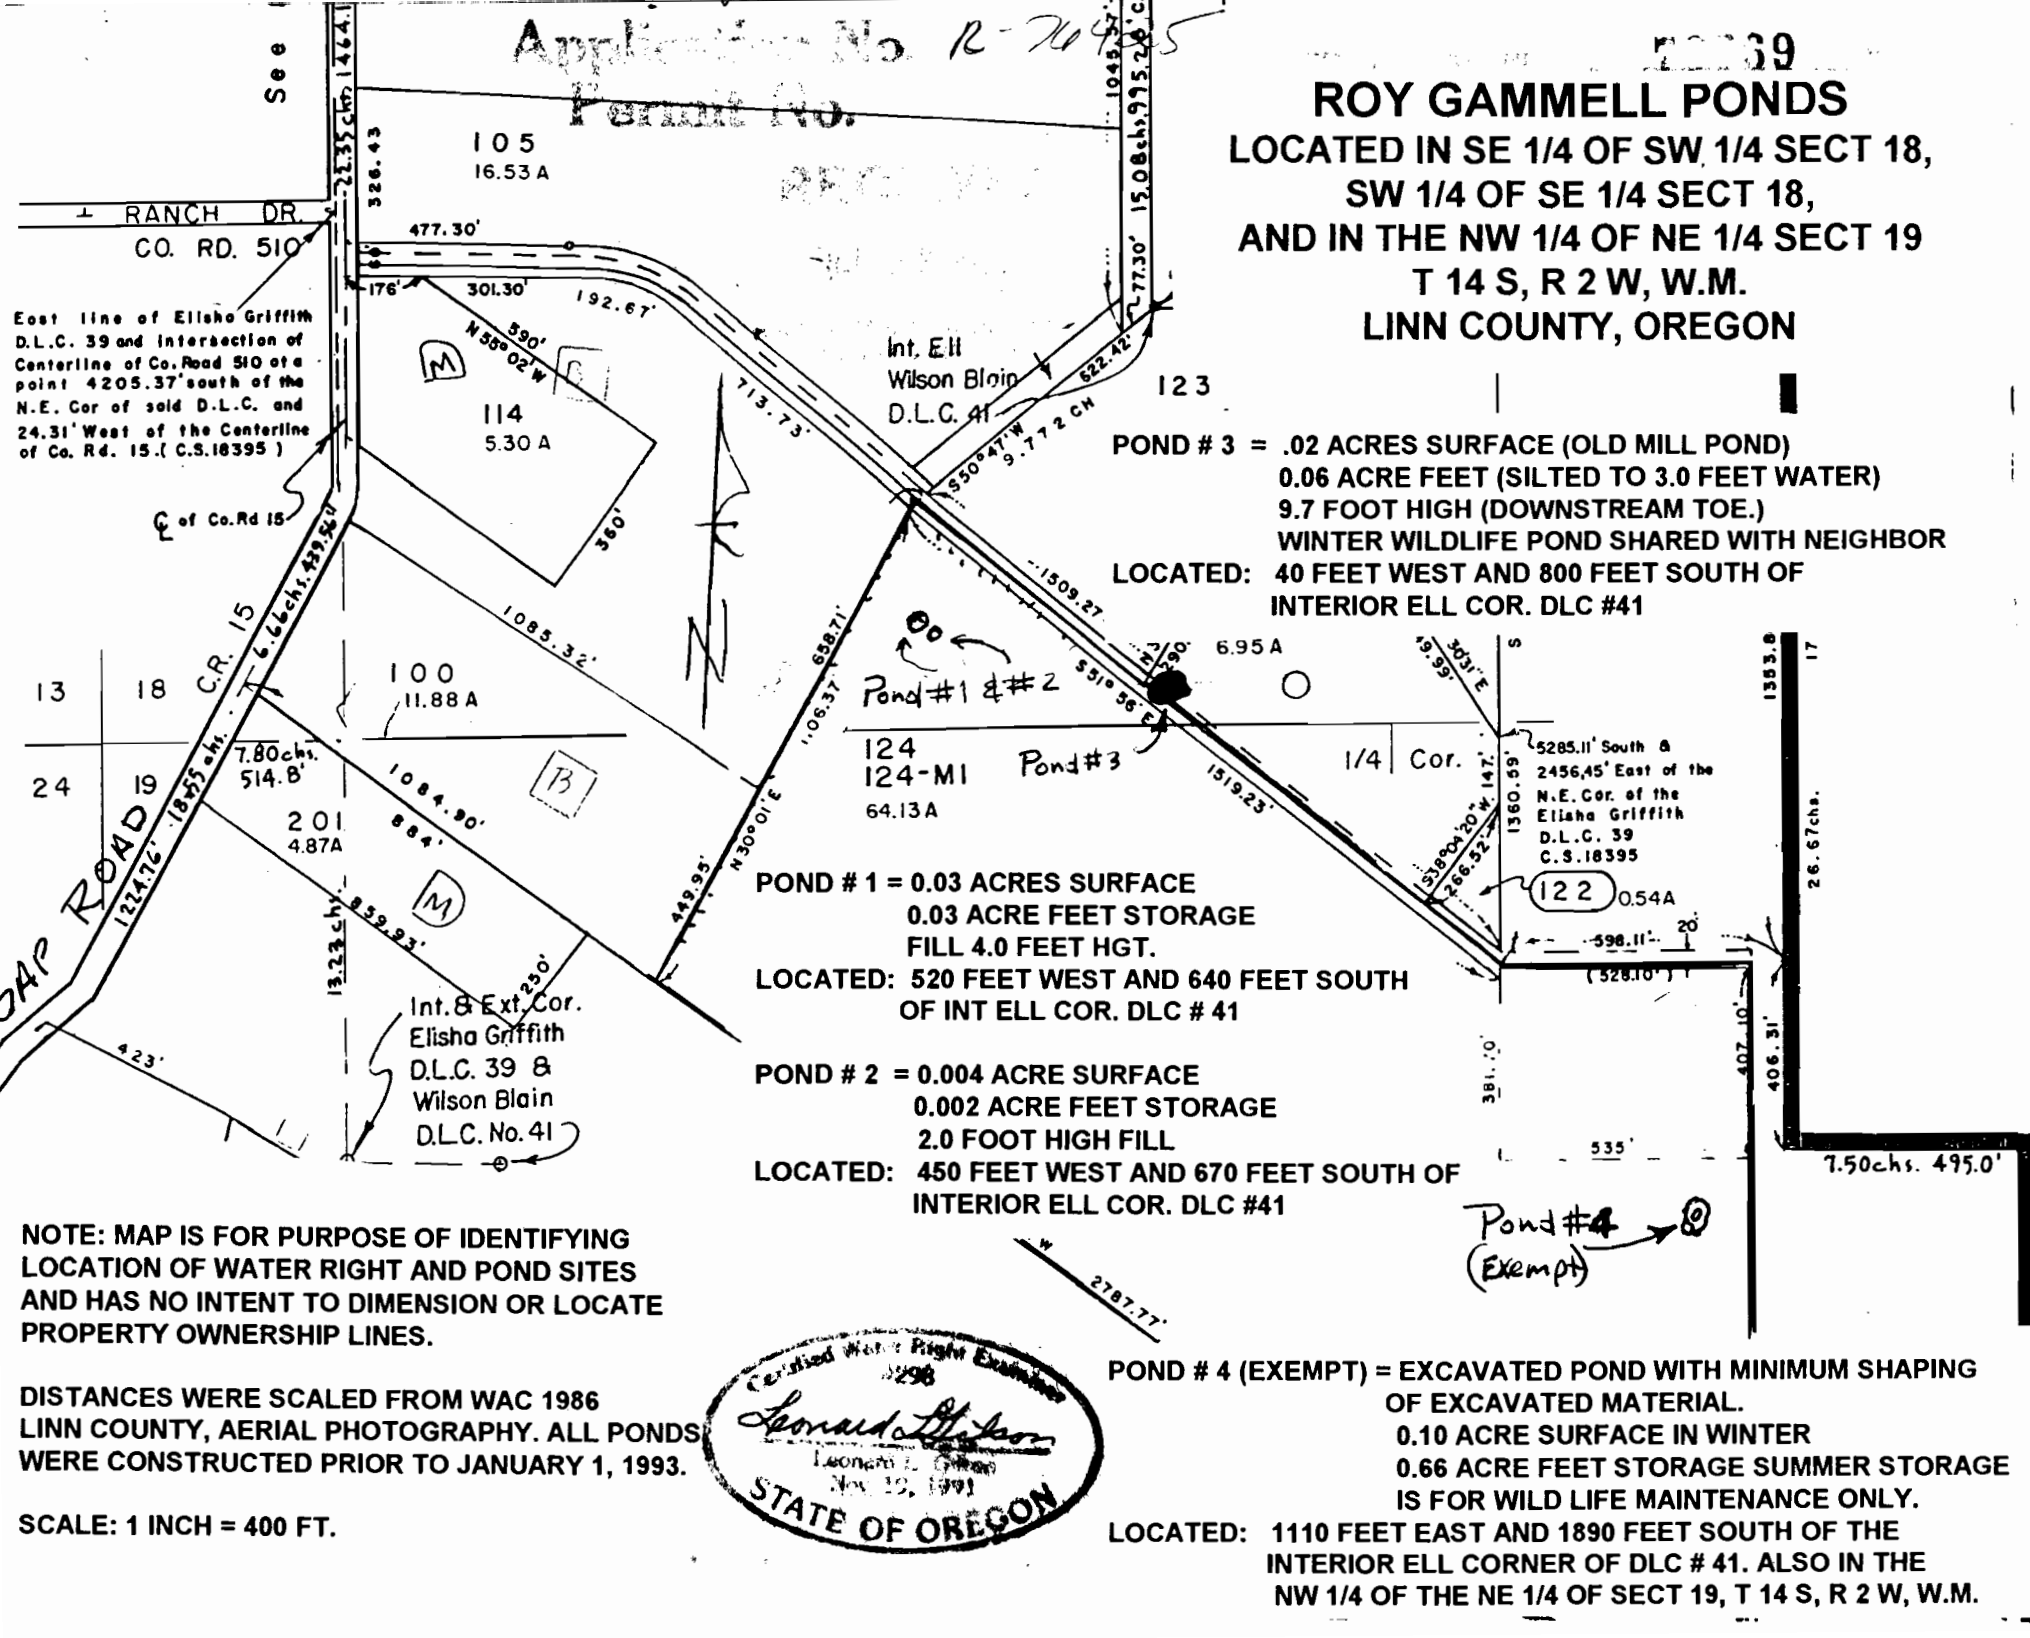


POND # 3 = .02 ACRES SURFACE (OLD MILL POND)  
0.06 ACRE FEET (SILTED TO 3.0 FEET WATER)  
9.7 FOOT HIGH (DOWNSTREAM TOE.)  
WINTER WILDLIFE POND SHARED WITH NEIGHBOR  
LOCATED: 40 FEET WEST AND 800 FEET SOUTH OF  
INTERIOR ELL COR. DLC #41

POND # 1 = 0.03 ACRES SURFACE  
0.03 ACRE FEET STORAGE  
FILL 4.0 FEET HGT.  
LOCATED: 520 FEET WEST AND 640 FEET SOUTH  
OF INT ELL COR. DLC # 41

POND # 2 = 0.004 ACRE SURFACE  
0.002 ACRE FEET STORAGE  
2.0 FOOT HIGH FILL  
LOCATED: 450 FEET WEST AND 670 FEET SOUTH OF  
INTERIOR ELL COR. DLC #41

POND # 4 (EXEMPT) = EXCAVATED POND WITH MINIMUM SHAPING  
OF EXCAVATED MATERIAL.  
0.10 ACRE SURFACE IN WINTER  
0.66 ACRE FEET STORAGE SUMMER STORAGE  
IS FOR WILD LIFE MAINTENANCE ONLY.  
LOCATED: 1110 FEET EAST AND 1890 FEET SOUTH OF THE  
INTERIOR ELL CORNER OF DLC # 41. ALSO IN THE  
NW 1/4 OF THE NE 1/4 OF SECT 19, T 14 S, R 2 W, W.M.

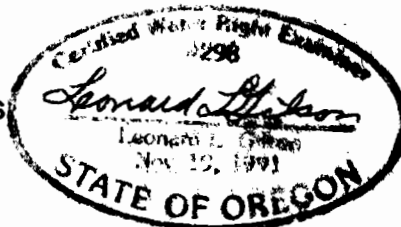

NOTE: MAP IS FOR PURPOSE OF IDENTIFYING  
LOCATION OF WATER RIGHT AND POND SITES  
AND HAS NO INTENT TO DIMENSION OR LOCATE  
PROPERTY OWNERSHIP LINES.

DISTANCES WERE SCALED FROM WAC 1986  
LINN COUNTY, AERIAL PHOTOGRAPHY. ALL PONDS  
WERE CONSTRUCTED PRIOR TO JANUARY 1, 1993.

SCALE: 1 INCH = 400 FT.