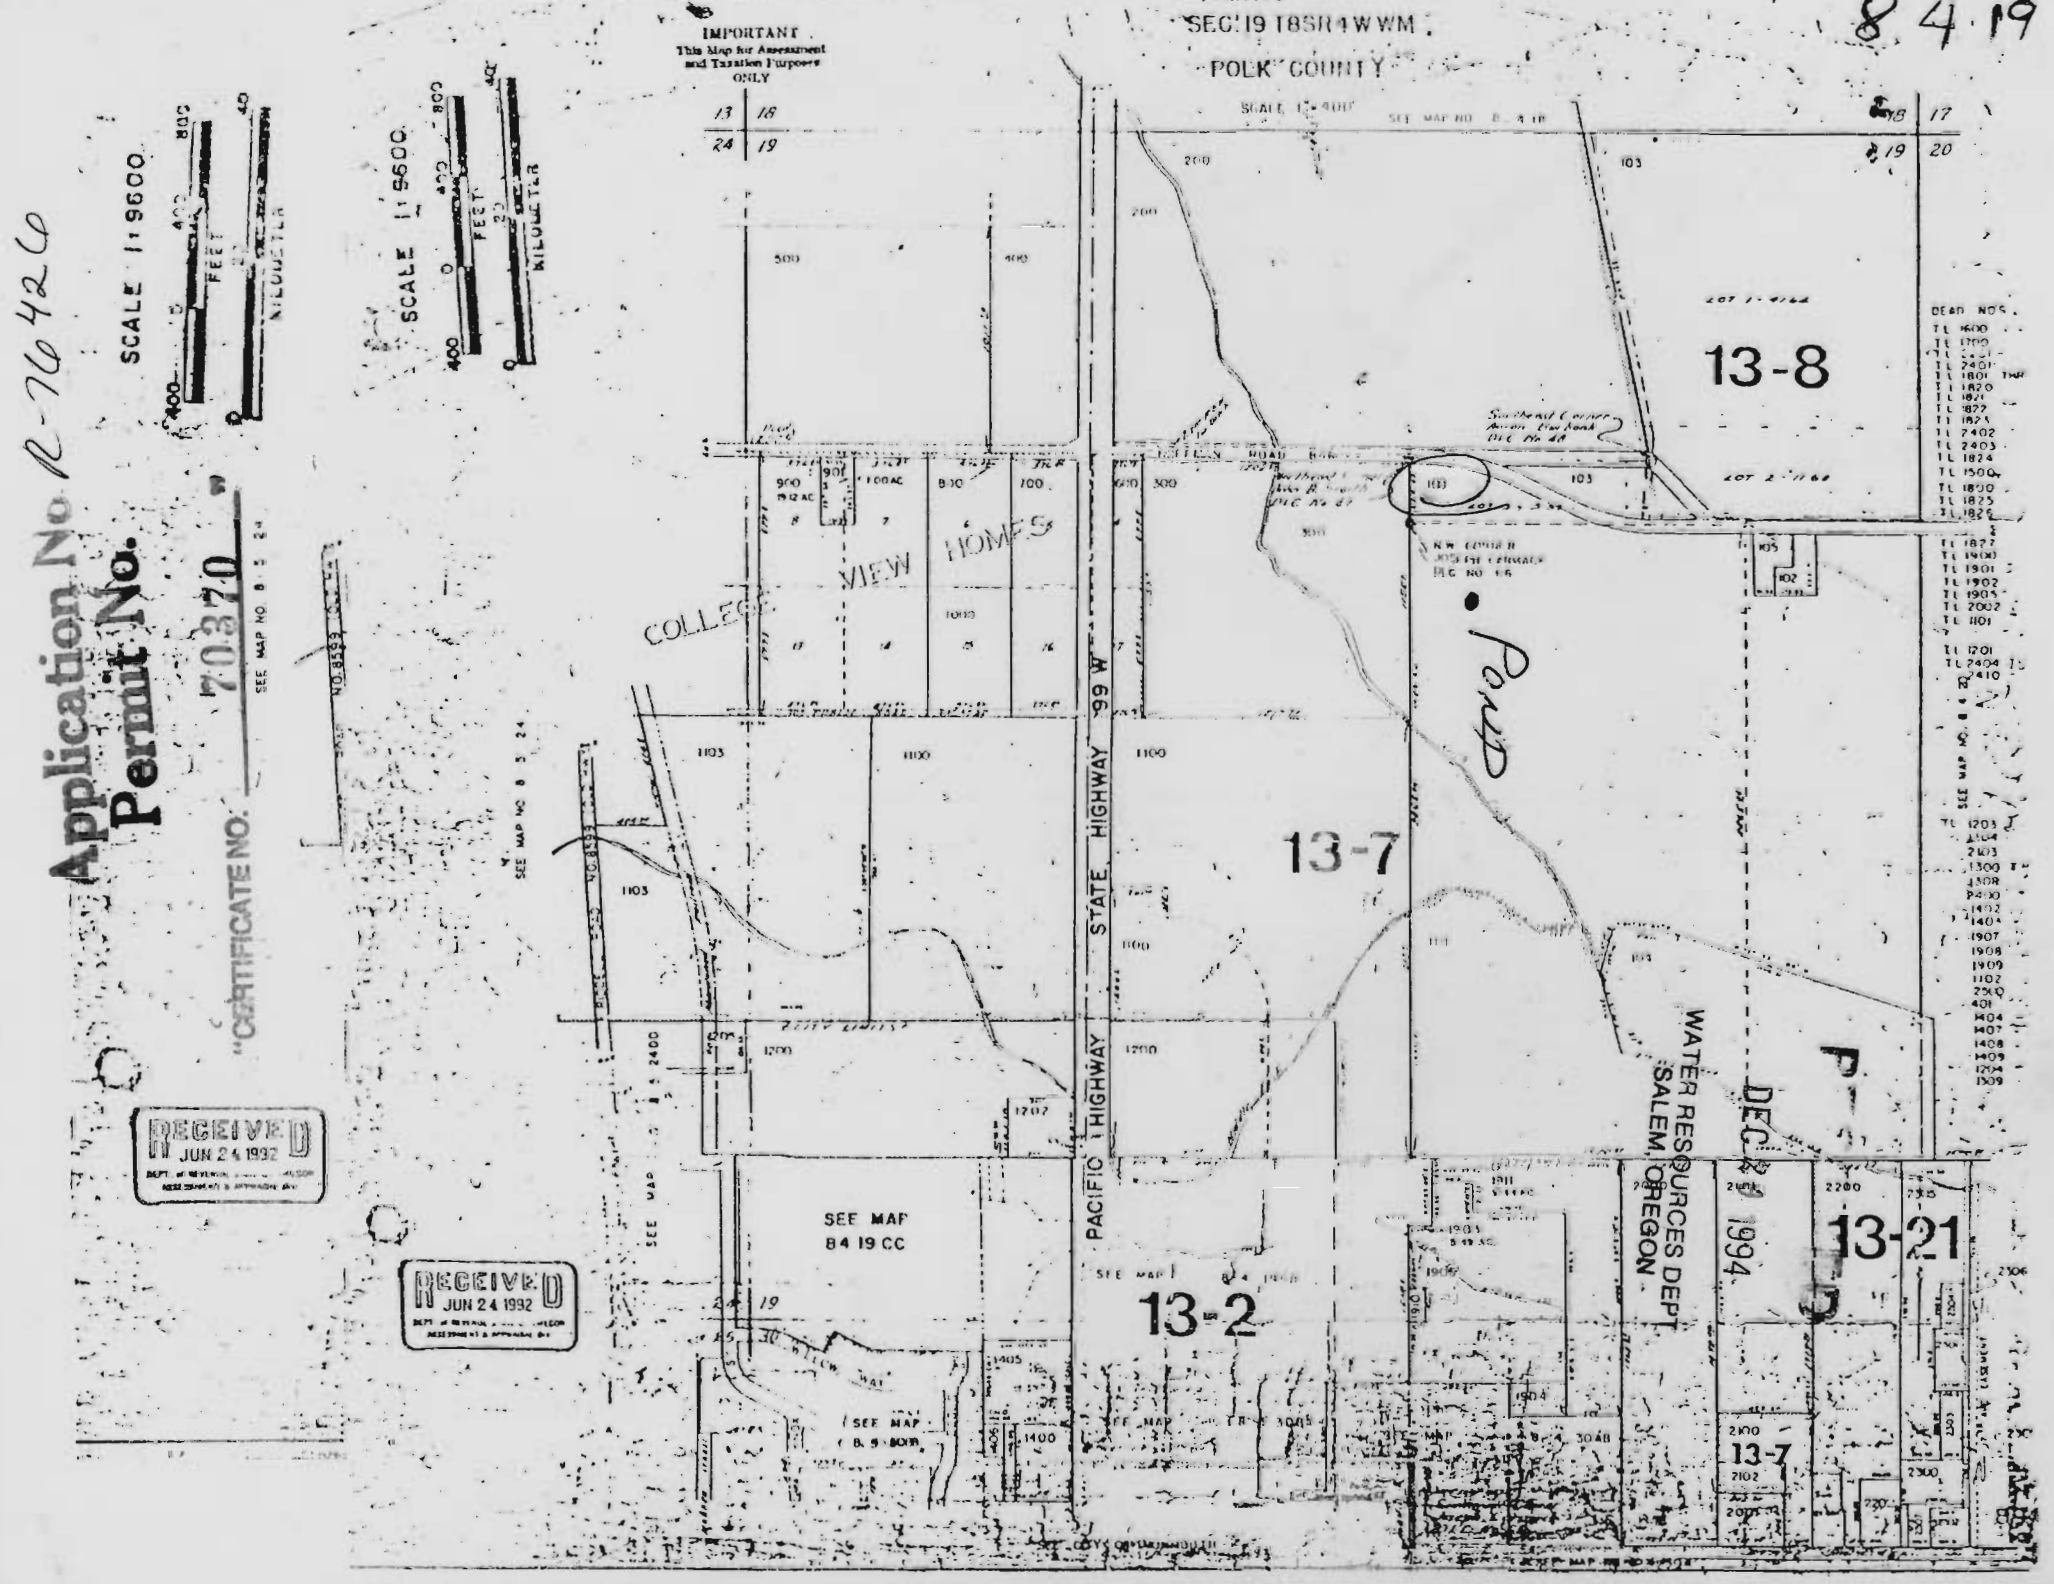

8 4 19
IMPORTANT
This Map for Assessment and Taxation Purposes ONLY
SEC 19 T8SR4WWM
POLK COUNTY
SCALE 1:9600
FEET
KILOMETER
Application No R-76426
Permit No.
"CERTIFICATE NO. 70370"
RECEIVED JUN 24 1992
COLLEGE VIEW HOMES
PACIFIC HIGHWAY 99 W
STATE HIGHWAY
13-8
13-7
13-2
13-21
Pond
WATER RESOURCES DEPT
SALEM, OREGON
DEC 2 1994
SEE MAP 8 4 19 CC