

RECEIVED


DEC 28 1994

WATER RESOURCES DEPT.  
SALEM, OREGON

CERTIFICATE NO.


70374

Application No. R-70470  
Permit No.

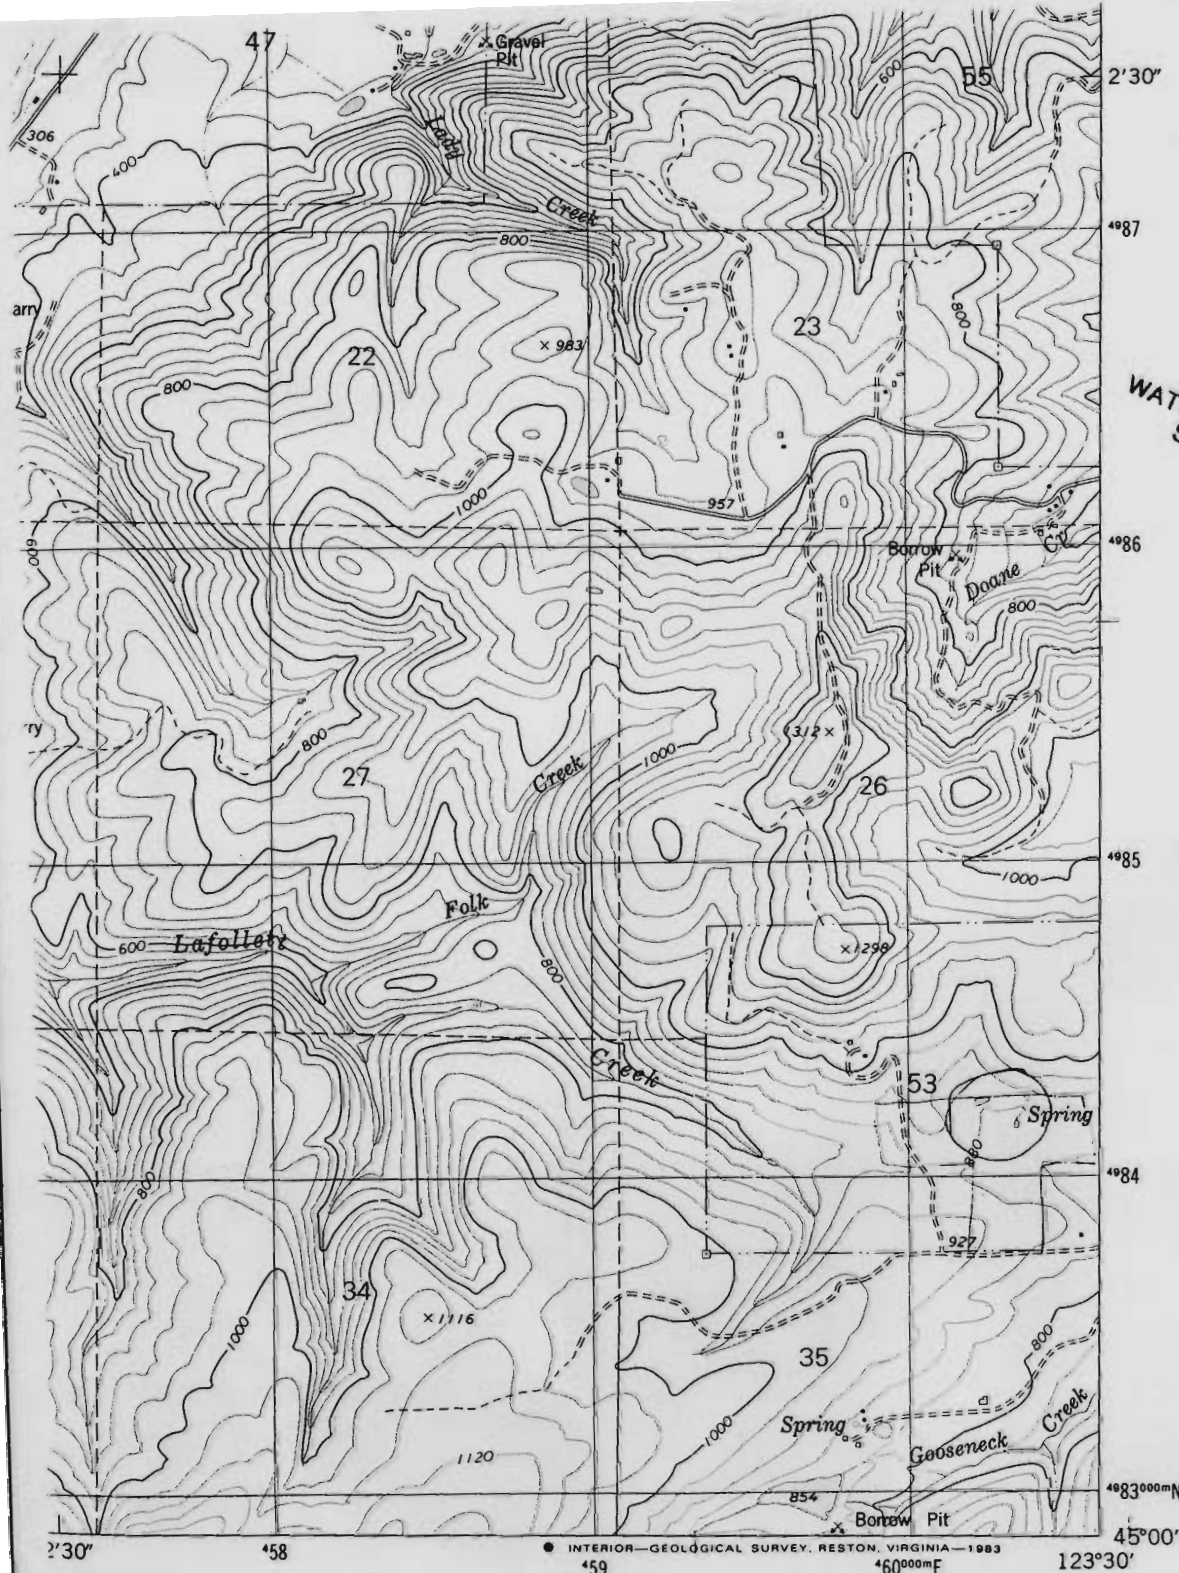

MILE

- ROAD CLASSIFICATION
- Primary highway, hard surface
  - Secondary highway, hard surface
  - Light-duty road, hard or improved surface
  - Unimproved road
  - Interstate Route
  - U. S. Route
  - State Route

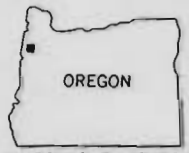

QUADRANGLE LOCATION

GRAND RONDE, OREG.  
SE/4 GRAND RONDE 15' QUADRANGLE  
N4500-W12330/7.5

1979

DMA 1274 II SE-SERIES V892

(SOCALIST VALLEY)  
NW 1/4 N 12330 W 12330