

Map for: **Don & Christina Murray**

Location: SW 1/4, NW 1/4 Section 2, T. 4 S., R. 5 W., W.M.
Yamhill County, Oregon

Tax Lot: 4502 - 200

Application No. R-76432

Date: 26 Dec. 1994

"CERTIFICATE NO. 72275"

RECEIVED

DEC 28 1994

WATER RESOURCES DEPT
SALEM, OREGON

NOTE

All dimensions are scaled from an aerial photograph.

34 35

3 2

I certify that the information I have provided in this application is an accurate representation of the proposed water use and is true and correct to the best of my knowledge. This map is to be used for the purpose of identifying the location of water right only and is not intended to provide legal dimensions or locations of property ownership lines.


Matt Dunckel
Matt Dunckel, CWRE

LEGEND:

- . . . — = Property line
- — — — = D.L.C. line
- — — — = Section line
- — — — = "40" line

North

Scale: 1" = 400'

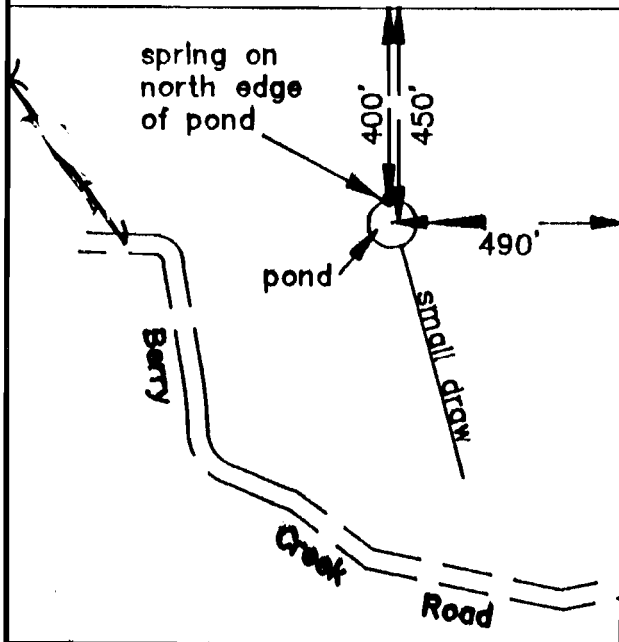

By: Matt Dunckel & Assoc.
19010 Baker Creek Rd.
McMinnville, Oregon 97128
Phone: 472-7904

