


RECEIVED
DEC 29 1994
WATER RESOURCES DEPT.
SALEM, OREGON

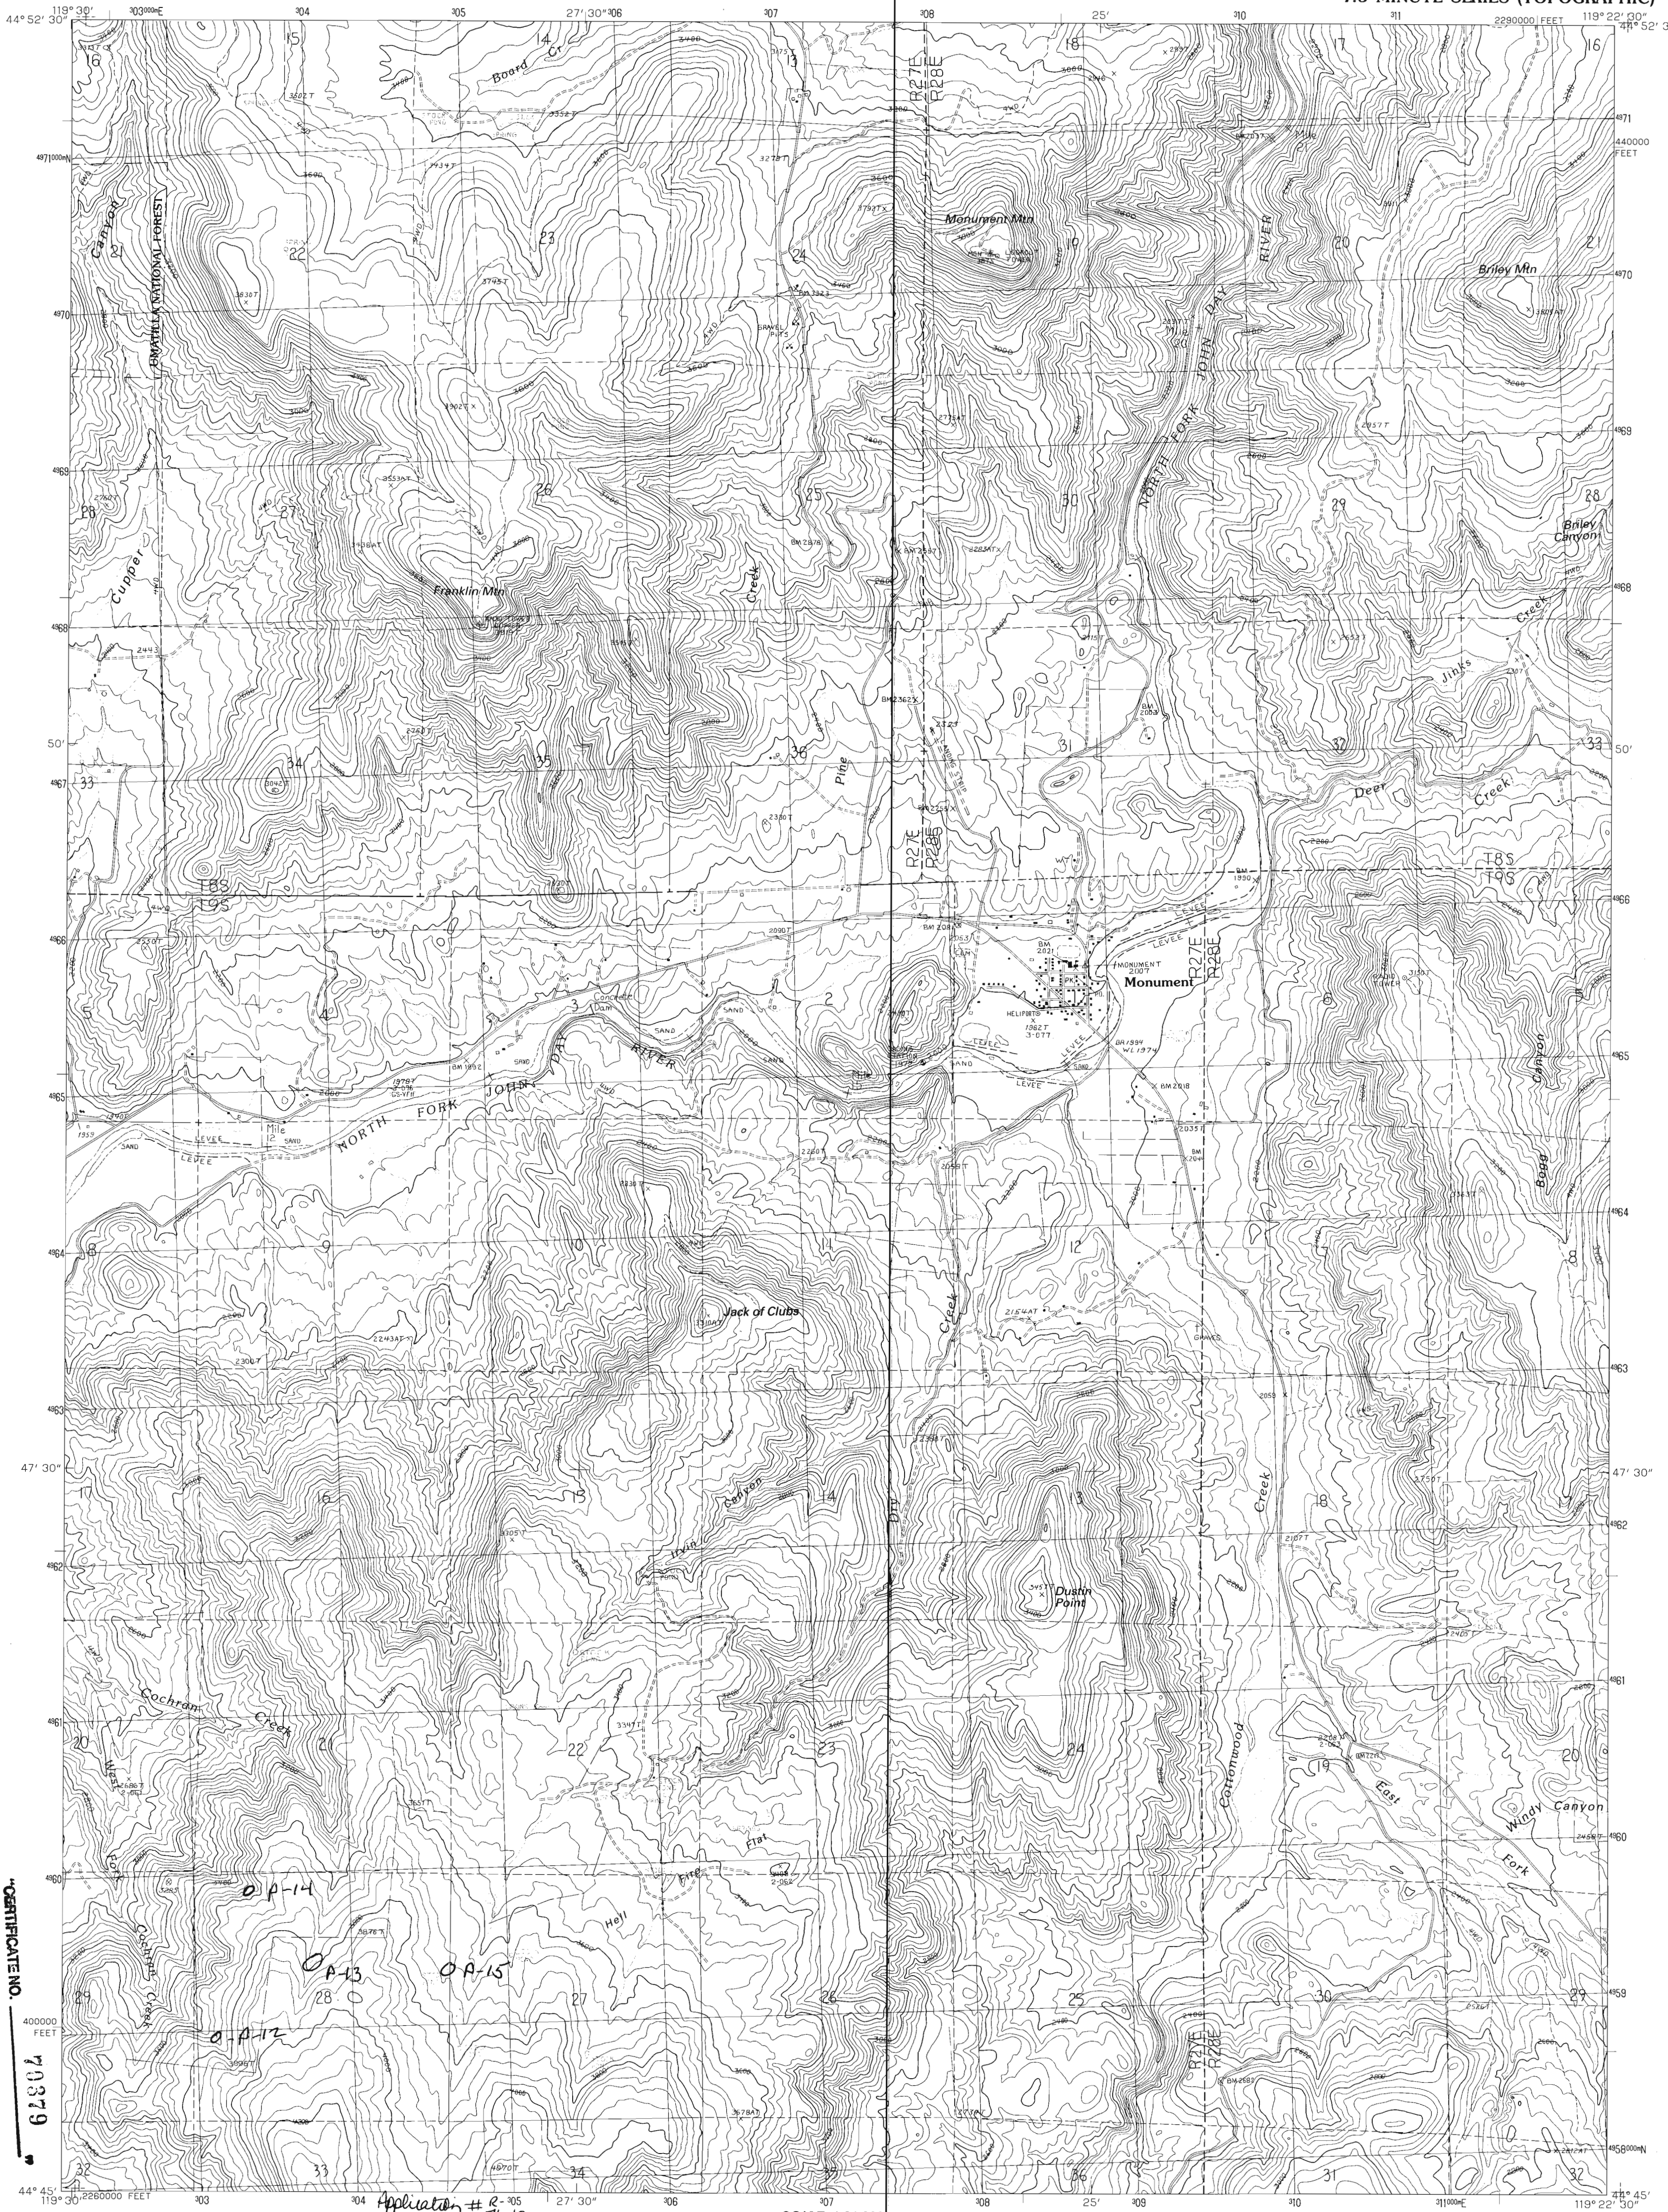


CERTIFICATE NO.

70379

PRODUCED BY THE UNITED STATES GEOLOGICAL SURVEY
CONTROL BY.....USGS AND NOS/NOAA
COMPILED FROM AERIAL PHOTOGRAPHS TAKEN.....1984
FIELD CHECKED.....1987. MAP EDITED.....1990
PROJECTION.....LAMBERT CONFORMAL CONIC
GRID: 1000-METER UNIVERSAL TRANSVERSE MERCATOR.....ZONE 11
10,000-FOOT STATE GRID TICKS.....OREGON, NORTH ZONE
UTM GRID DECLINATION.....1°43' WEST
1990 MAGNETIC NORTH DECLINATION.....18°00' EAST
VERTICAL DATUM.....NATIONAL GEODETIC VERTICAL DATUM OF 1929
HORIZONTAL DATUM.....1927 NORTH AMERICAN DATUM
To place on the predicted North American Datum of 1983,
move the projection lines as shown by dashed corner ticks
(19 meters north and 86 meters east)
There may be private inholdings within the boundaries of any
Federal or State reservations shown on this map
No distinction made between houses, barns, and other buildings

PROVISIONAL MAP
Produced from original
manuscript drawings. Infor-
mation shown as of date of
field check.

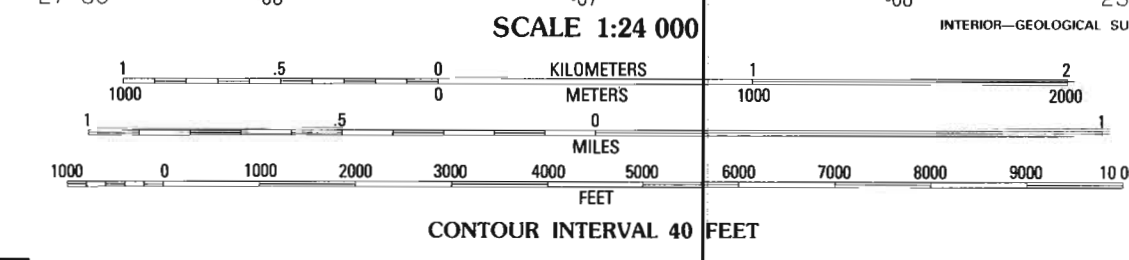

THIS MAP COMPLIES WITH NATIONAL MAP ACCURACY STANDARDS
FOR SALE BY U.S. GEOLOGICAL SURVEY
DENVER, COLORADO 80225, OR RESTON, VIRGINIA 22092


1	2	3	1 Turner Mtn
4	5	2 Johnny Cake Mtn	
6	7	3 Slicker Mtn	
		4 Bologna Basin	
		5 Steer Mtn	
		6 Miller Flat	
		7 Courthouse Rock	
		8 Hamilton	

ROAD LEGEND
Improved Road
Unimproved Road
Trail
Interstate Route
U. S. Route
State Route

MONUMENT, OREGON
PROVISIONAL EDITION 1990


44119-G4-TF-024

RECEIVED
DEC 29 1994
WATER RESOURCES DEPT.
SALEM, OREGON

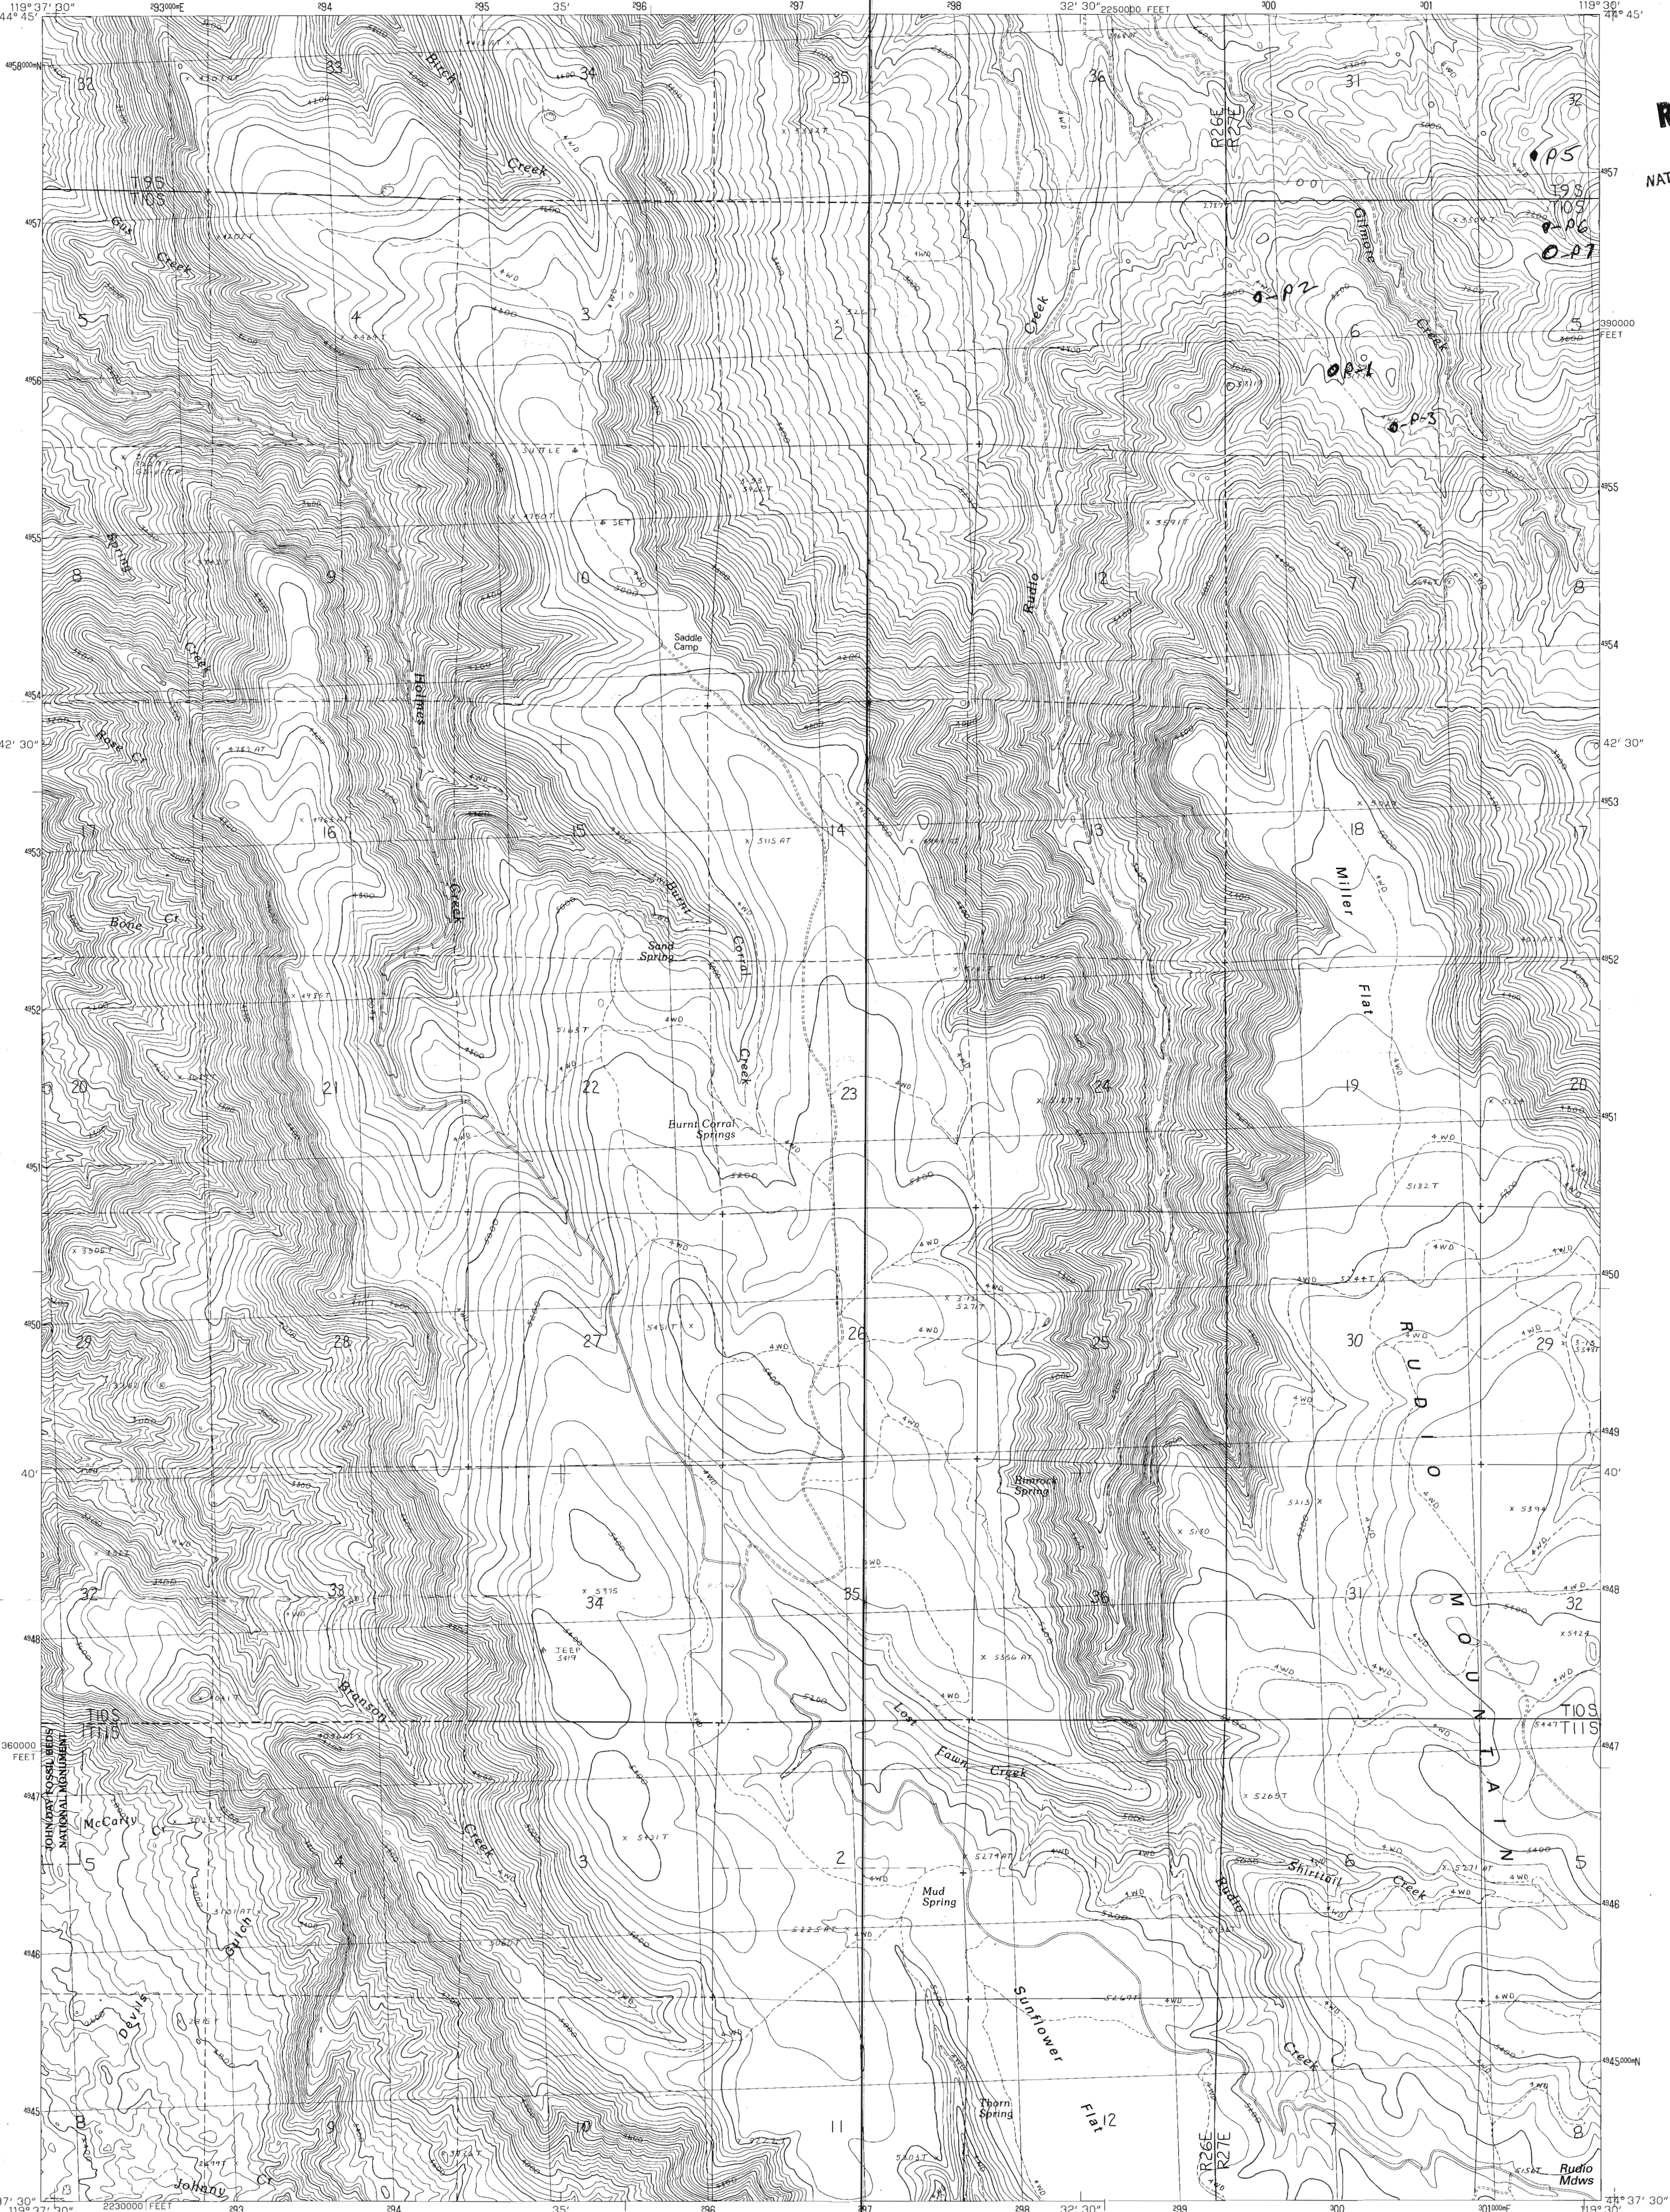

PRODUCED BY THE UNITED STATES GEOLOGICAL SURVEY
CONTROL BY.....USGS AND NOS/NOAA
COMPILED FROM AERIAL PHOTOGRAPHS TAKEN.....1984
FIELD CHECKED.....1986. MAP EDITED.....1990
PROJECTION.....LAMBERT CONFORMAL CONIC
GRID: 1000-METER UNIVERSAL TRANSVERSE MERCATOR, ZONE 11
10,000-FOOT STATE GRID TICKS.....OREGON, NORTH ZONE
UTM GRID DECLINATION.....1°48' WEST
1990 MAGNETIC NORTH DECLINATION.....18°00' EAST
VERTICAL DATUM.....NATIONAL GEODETIC VERTICAL DATUM OF 1929
HORIZONTAL DATUM.....1927 NORTH AMERICAN DATUM
To place on the predicted North American Datum of 1983,
move the projection lines as shown by dashed corner ticks
(19 meters north and 86 meters east)
There may be private inholdings within the boundaries of any
Federal or State reservations shown on this map

PROVISIONAL MAP
Produced from original
manuscript drawings. Infor-
mation shown as of date of
field check.

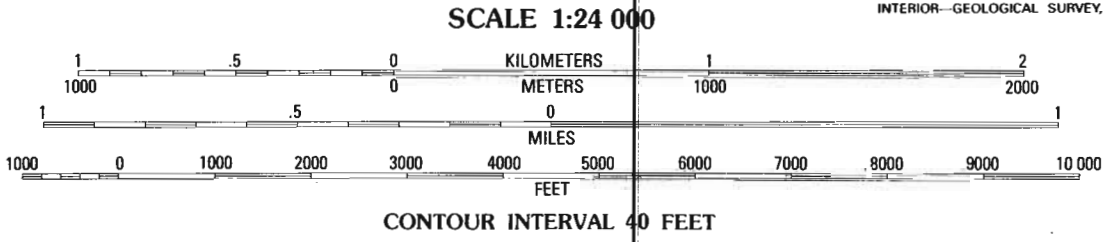

THIS MAP COMPLIES WITH NATIONAL MAP ACCURACY STANDARDS
FOR SALE BY U.S. GEOLOGICAL SURVEY
DENVER, COLORADO 80225, OR RESTON, VIRGINIA 22092


QUADRANGLE LOCATION		
1	2	3
4	5	6
7	8	9

1 Kimberly
2 Bologna Basin
3 Monument
4 Mt. Misery
5 Courthouse Rock
6 Picture Gorge W.
7 Picture Gorge E.
8 Sheep Ridge

ROAD LEGEND
Improved Road
Unimproved Road
Trail
Interstate Route
U.S. Route
State Route

MILLER FLAT, OREGON
PROVISIONAL EDITION 1990


44119-F5-TF-024

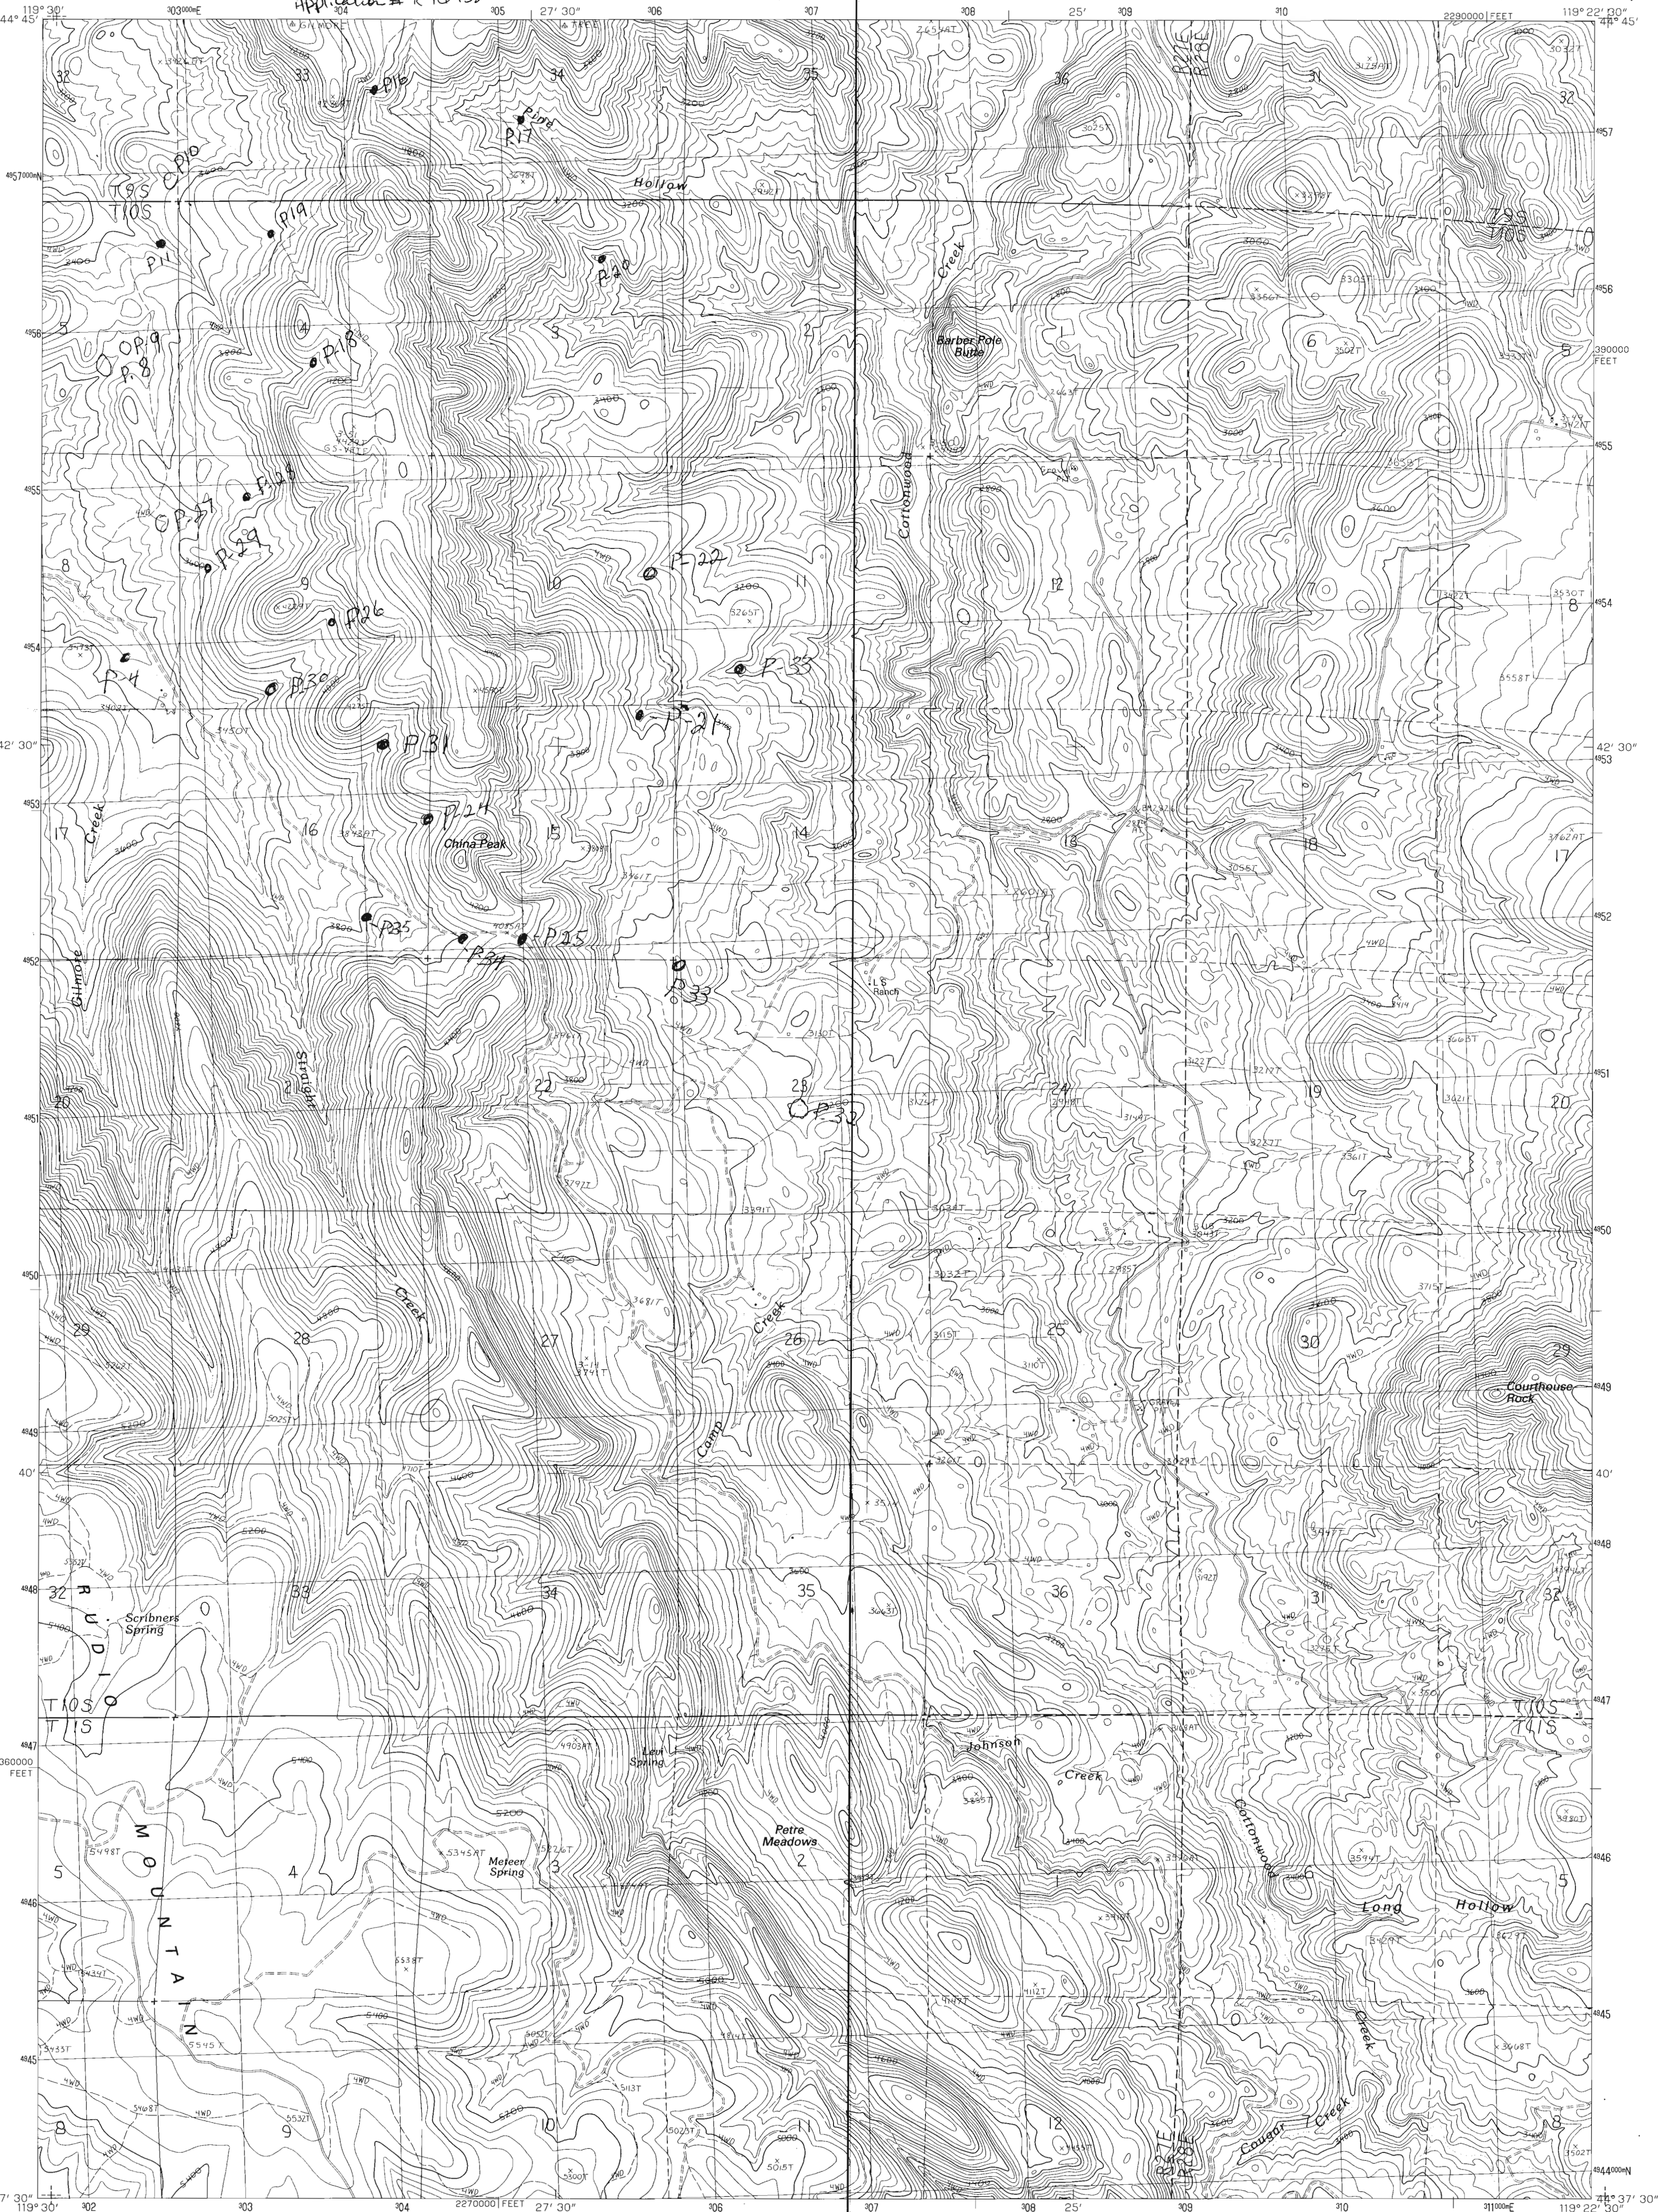

RECEIVED
DEC 29 1994
WATER RESOURCES DIV
SALEM, OREGON

PRODUCED BY THE UNITED STATES GEOLOGICAL SURVEY
CONTROL BY.....USGS AND NOS/NOAA
COMPILED FROM AERIAL PHOTOGRAPHS TAKEN.....1984
FIELD CHECKED.....1987. MAP EDITED.....1990
PROJECTION.....LAMBERT CONFORMAL CONIC
GRID: 1000-METER UNIVERSAL TRANSVERSE MERCATOR.....ZONE 11
10,000-FOOT STATE GRID TICS.....OREGON, NORTH ZONE
UTM GRID DECLINATION.....1°43' WEST
1990 MAGNETIC NORTH DECLINATION.....18°00' EAST
VERTICAL DATUM.....NATIONAL GEODETIC VERTICAL DATUM OF 1929
HORIZONTAL DATUM.....1927 NORTH AMERICAN DATUM
To place on the predicted North American Datum of 1983,
move the projection lines as shown by dashed corner ticks
(19 meters north and 86 meters east)
There may be private inholdings within the boundaries of any
Federal or State reservations shown on this map

PROVISIONAL MAP
Produced from original
manuscript drawings. Infor-
mation shown as of date of
field check.

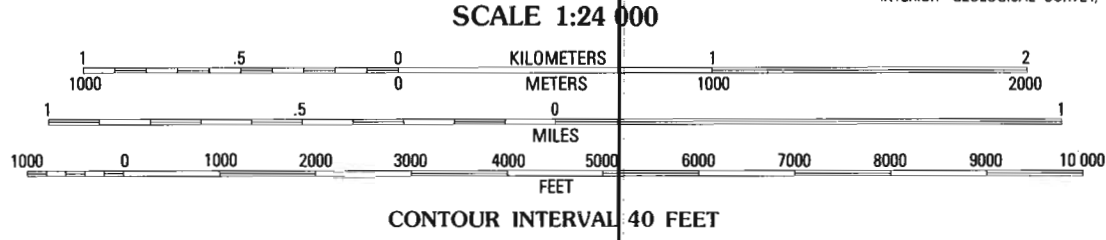

THIS MAP COMPLIES WITH NATIONAL MAP ACCURACY STANDARDS
FOR SALE BY U.S. GEOLOGICAL SURVEY
DENVER, COLORADO 80225, OR RESTON, VIRGINIA 22092

1	2	3	1 Bologna Basin
4	5	2 Monument	3 Sweet Mtn
6	7	4 Miller Flat	5 Hamilton
		6 Picture Gorge E	7 Sheep Ridge
		8 Donaldson Creek	

ROAD LEGEND
Improved Road.....
Unimproved Road.....
Trail.....
Interstate Route..... U.S. Route..... State Route.....

COURTHOUSE ROCK, OREGON
PROVISIONAL EDITION 1990

44119-F4-TF-024