
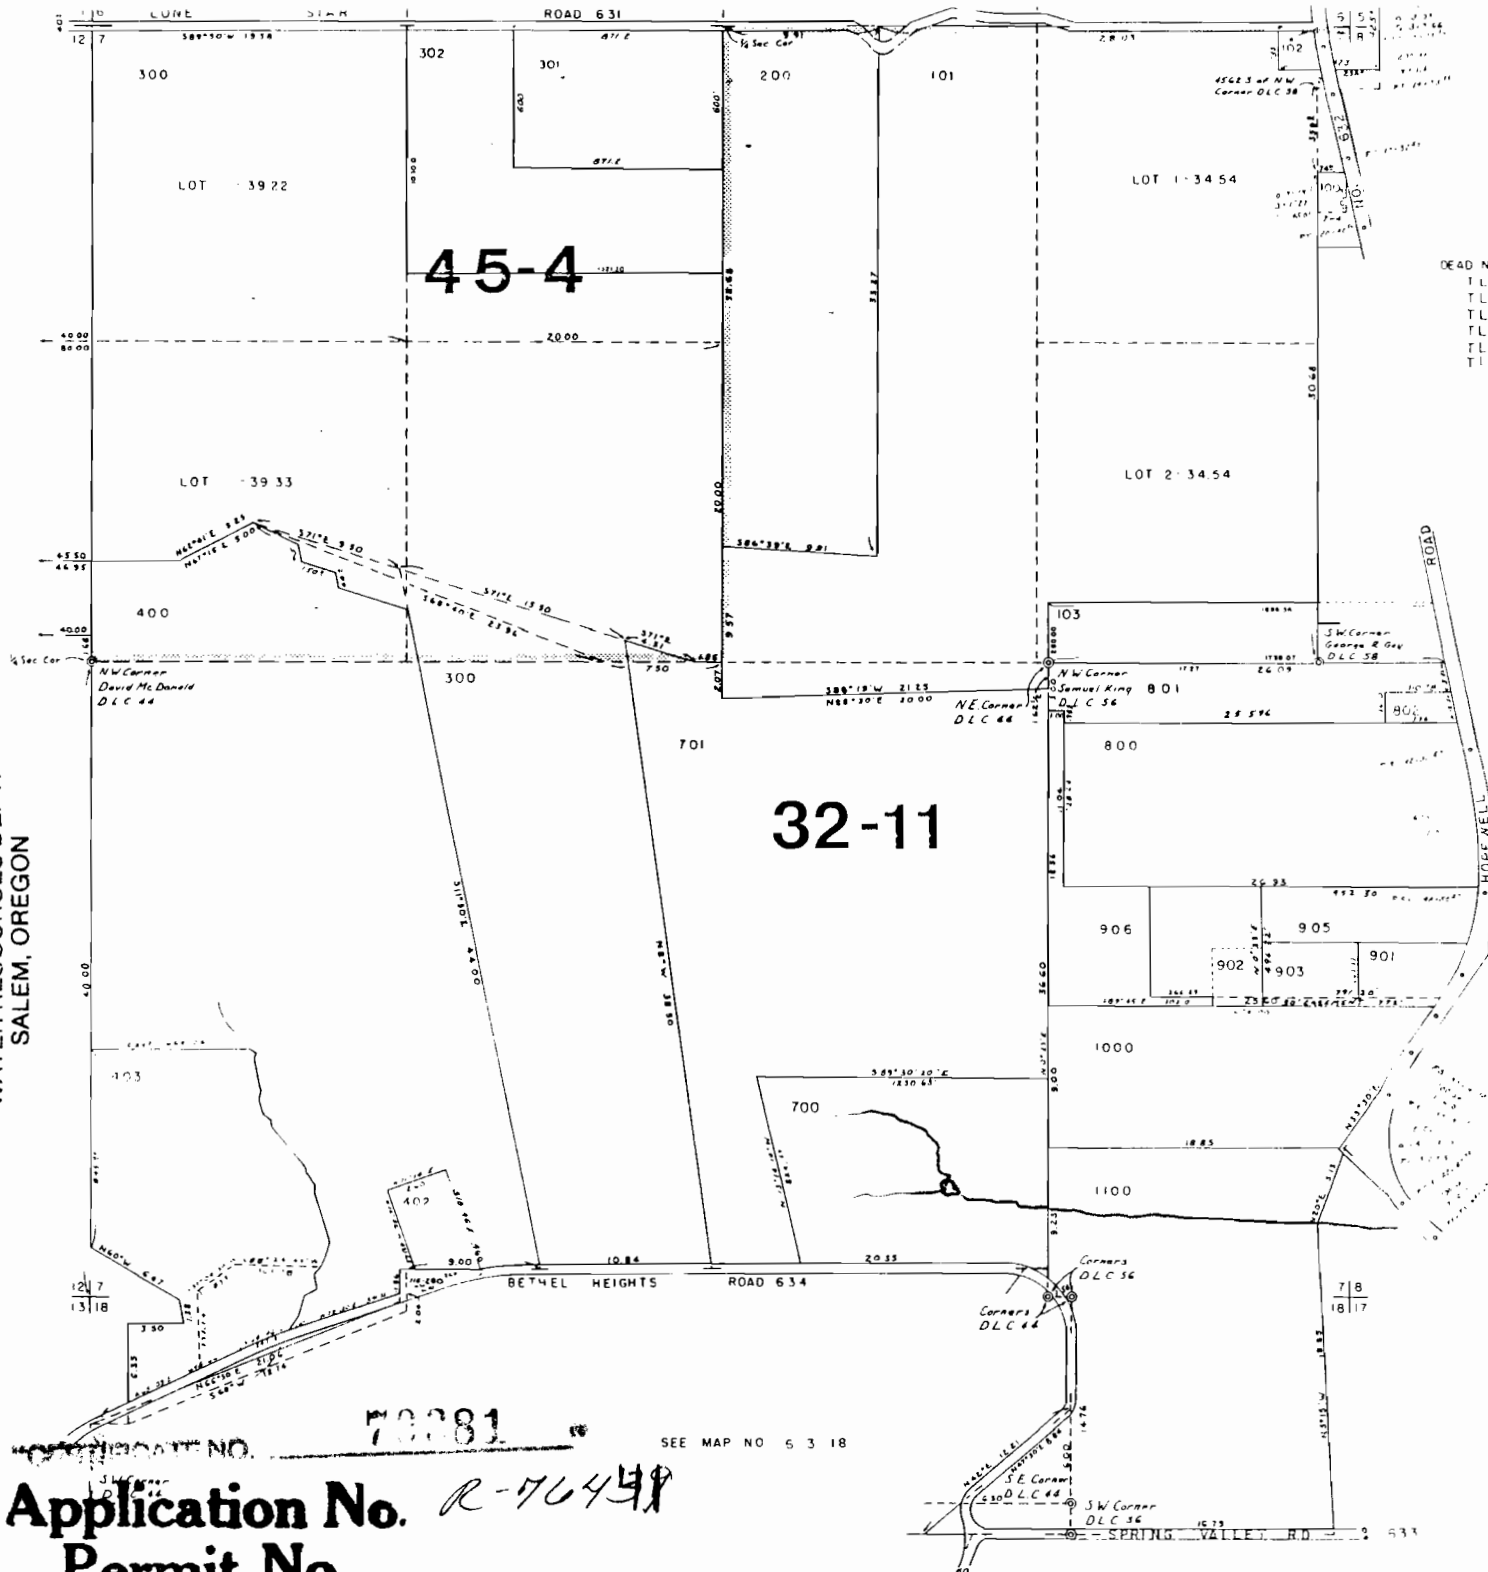


DEC 28 1994

WATER RESOURCES DEPT.  
SALEM, OREGON

SEE MAP NO 6 4 12

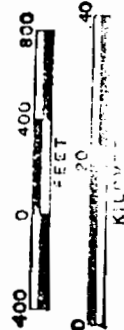

DEAD NUMBERS  
TL 500  
TL 600  
TL 904  
TL 401  
TL 170  
TL 900

SEE MAP NO. 38

6 3 7

Application No. R-76441

Permit No. \_\_\_\_\_

Polk Co. Regional Taxlot Map

Scale 1:270

RECEIVED

DEC 28 1994


WATER RESOURCES DEPT.  
SALEM, OREGON


Owners Charles & Jeanette Zabrist:

Property located in Polk Co, OR described as follows:

Beginning at a point on the East line of the David McDonald Land Claim No. 44, said point being 124.3 feet North 0°23' East from Re-entrant corner on the East line of the said Donation Land Claim No. 44 in Township 6 South, Range 3 West, of the Willamette Meridian in Polk Co. Oregon; running thence North 89°30'20" West 1036.78 feet to a point from which an iron rod bears North 13°14'10" West 21.99 feet; thence North 13°14'10" West 824.67 feet to an iron rod; thence South 89°30'20" East 1230.63 feet to an iron rod; on the East line of said Donation Land Claim No. 44; thence South 0°23' West 800.00 feet to the place of beginning.

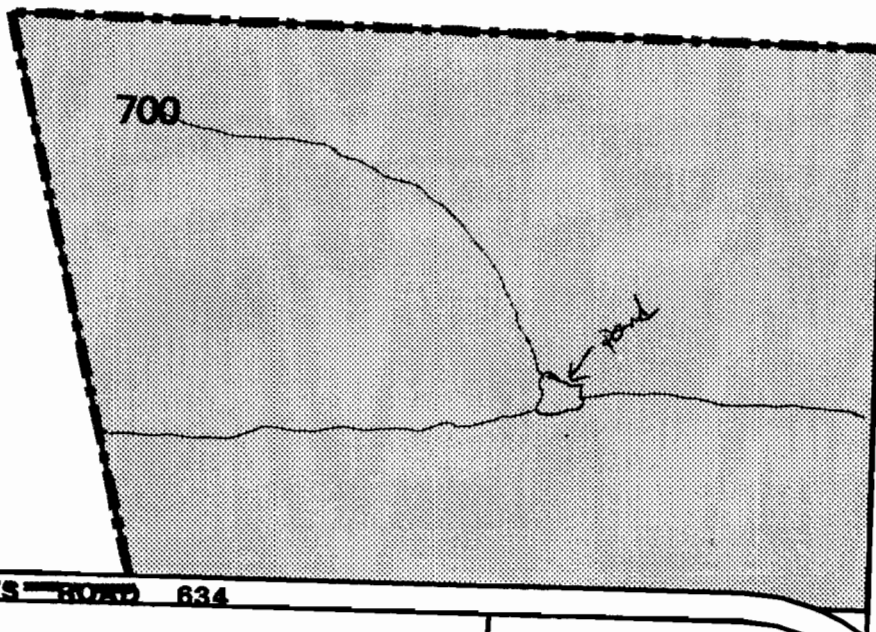


We certify that this pond was in existence prior to 1980.

Charles Zabrist

Jeanette Zabrist

102

DATE: 12-28-94

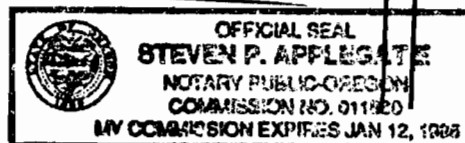

Note: Source of taxlots is County Assessor Map.