


70392

Application No. R-74454
Permit No.

THIS MAP WAS PREPARED FOR
ACQUISITION PURPOSE ONLY.

NW1/4 SEC.4 T.24S. R.5W. W.M.
DOUGLAS COUNTY

24 5 4B

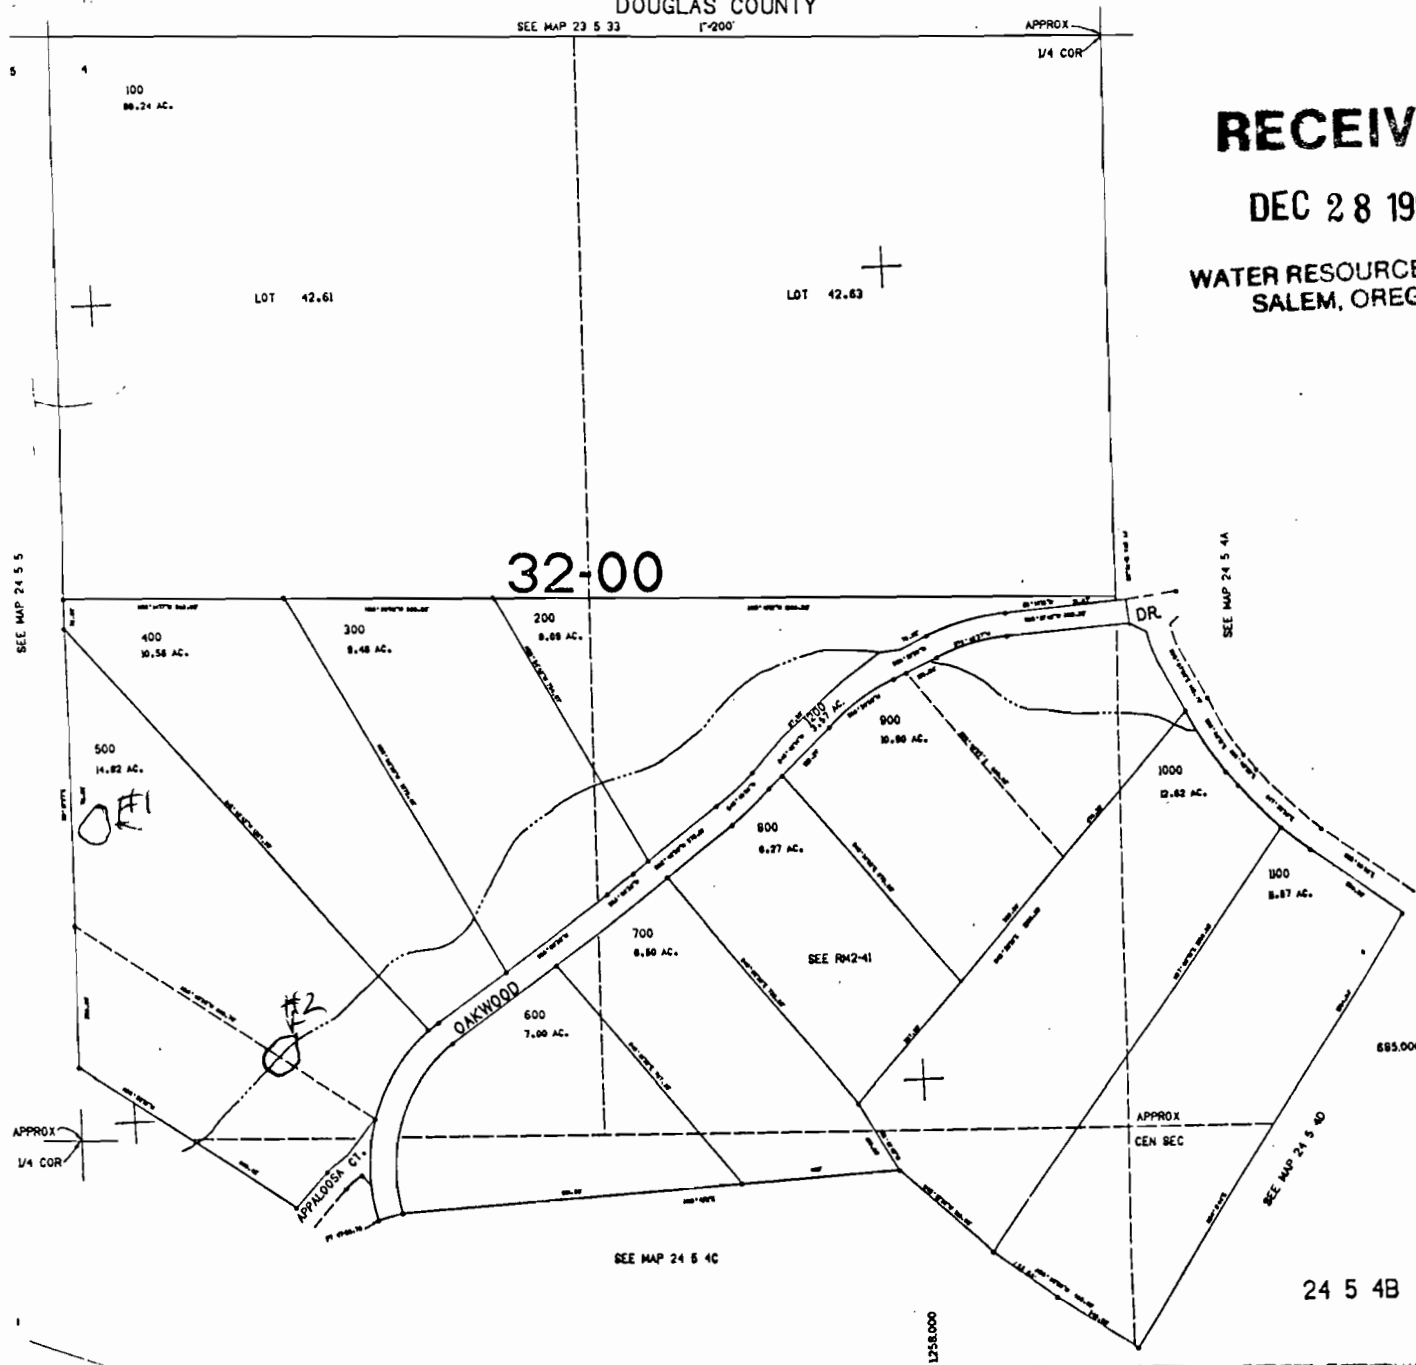

RECEIVED

DEC 28 1994

WATER RESOURCES DEPT
SALEM, OREGON

24 5 4B