


STATE <i>Oregon</i>	PROJECT <i>Richard Aarhus</i>
BY <i>Gibson</i>	DATE <i>8-27-68</i>
CHECKED BY	DATE
JOB NO.	
SHEET <i>1</i> OF <i>1</i>	

SCALE 1" = 1320'

T. 6 S. R. 1 W. W M

RECEIVED  
 STATE OF OREGON  
 DEC 28 1994

WATER RESOURCES DEPT.  
SALEM, OREGON

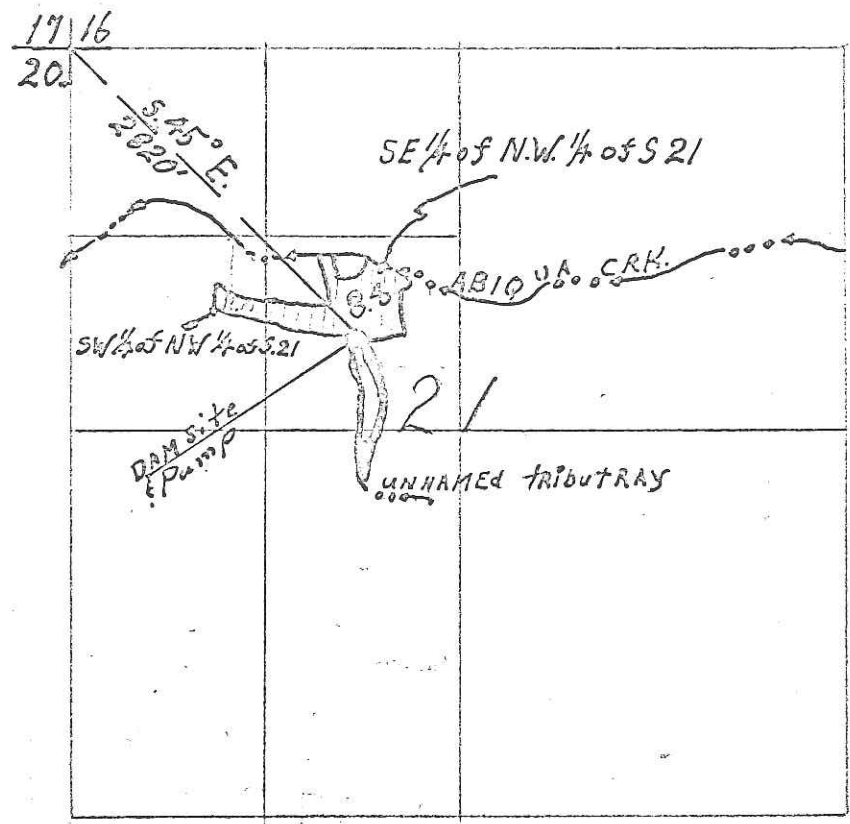

Application No.  
Permit No.

R-45346 & 45347  
R-5358 & 53860

Application No. *R-76457*  
Permit No.

"CERTIFICATE NO. 70395"