



RECEIVED
DEC 2 1994
WATER RESOURCES DEPT.
SALEM, OREGON

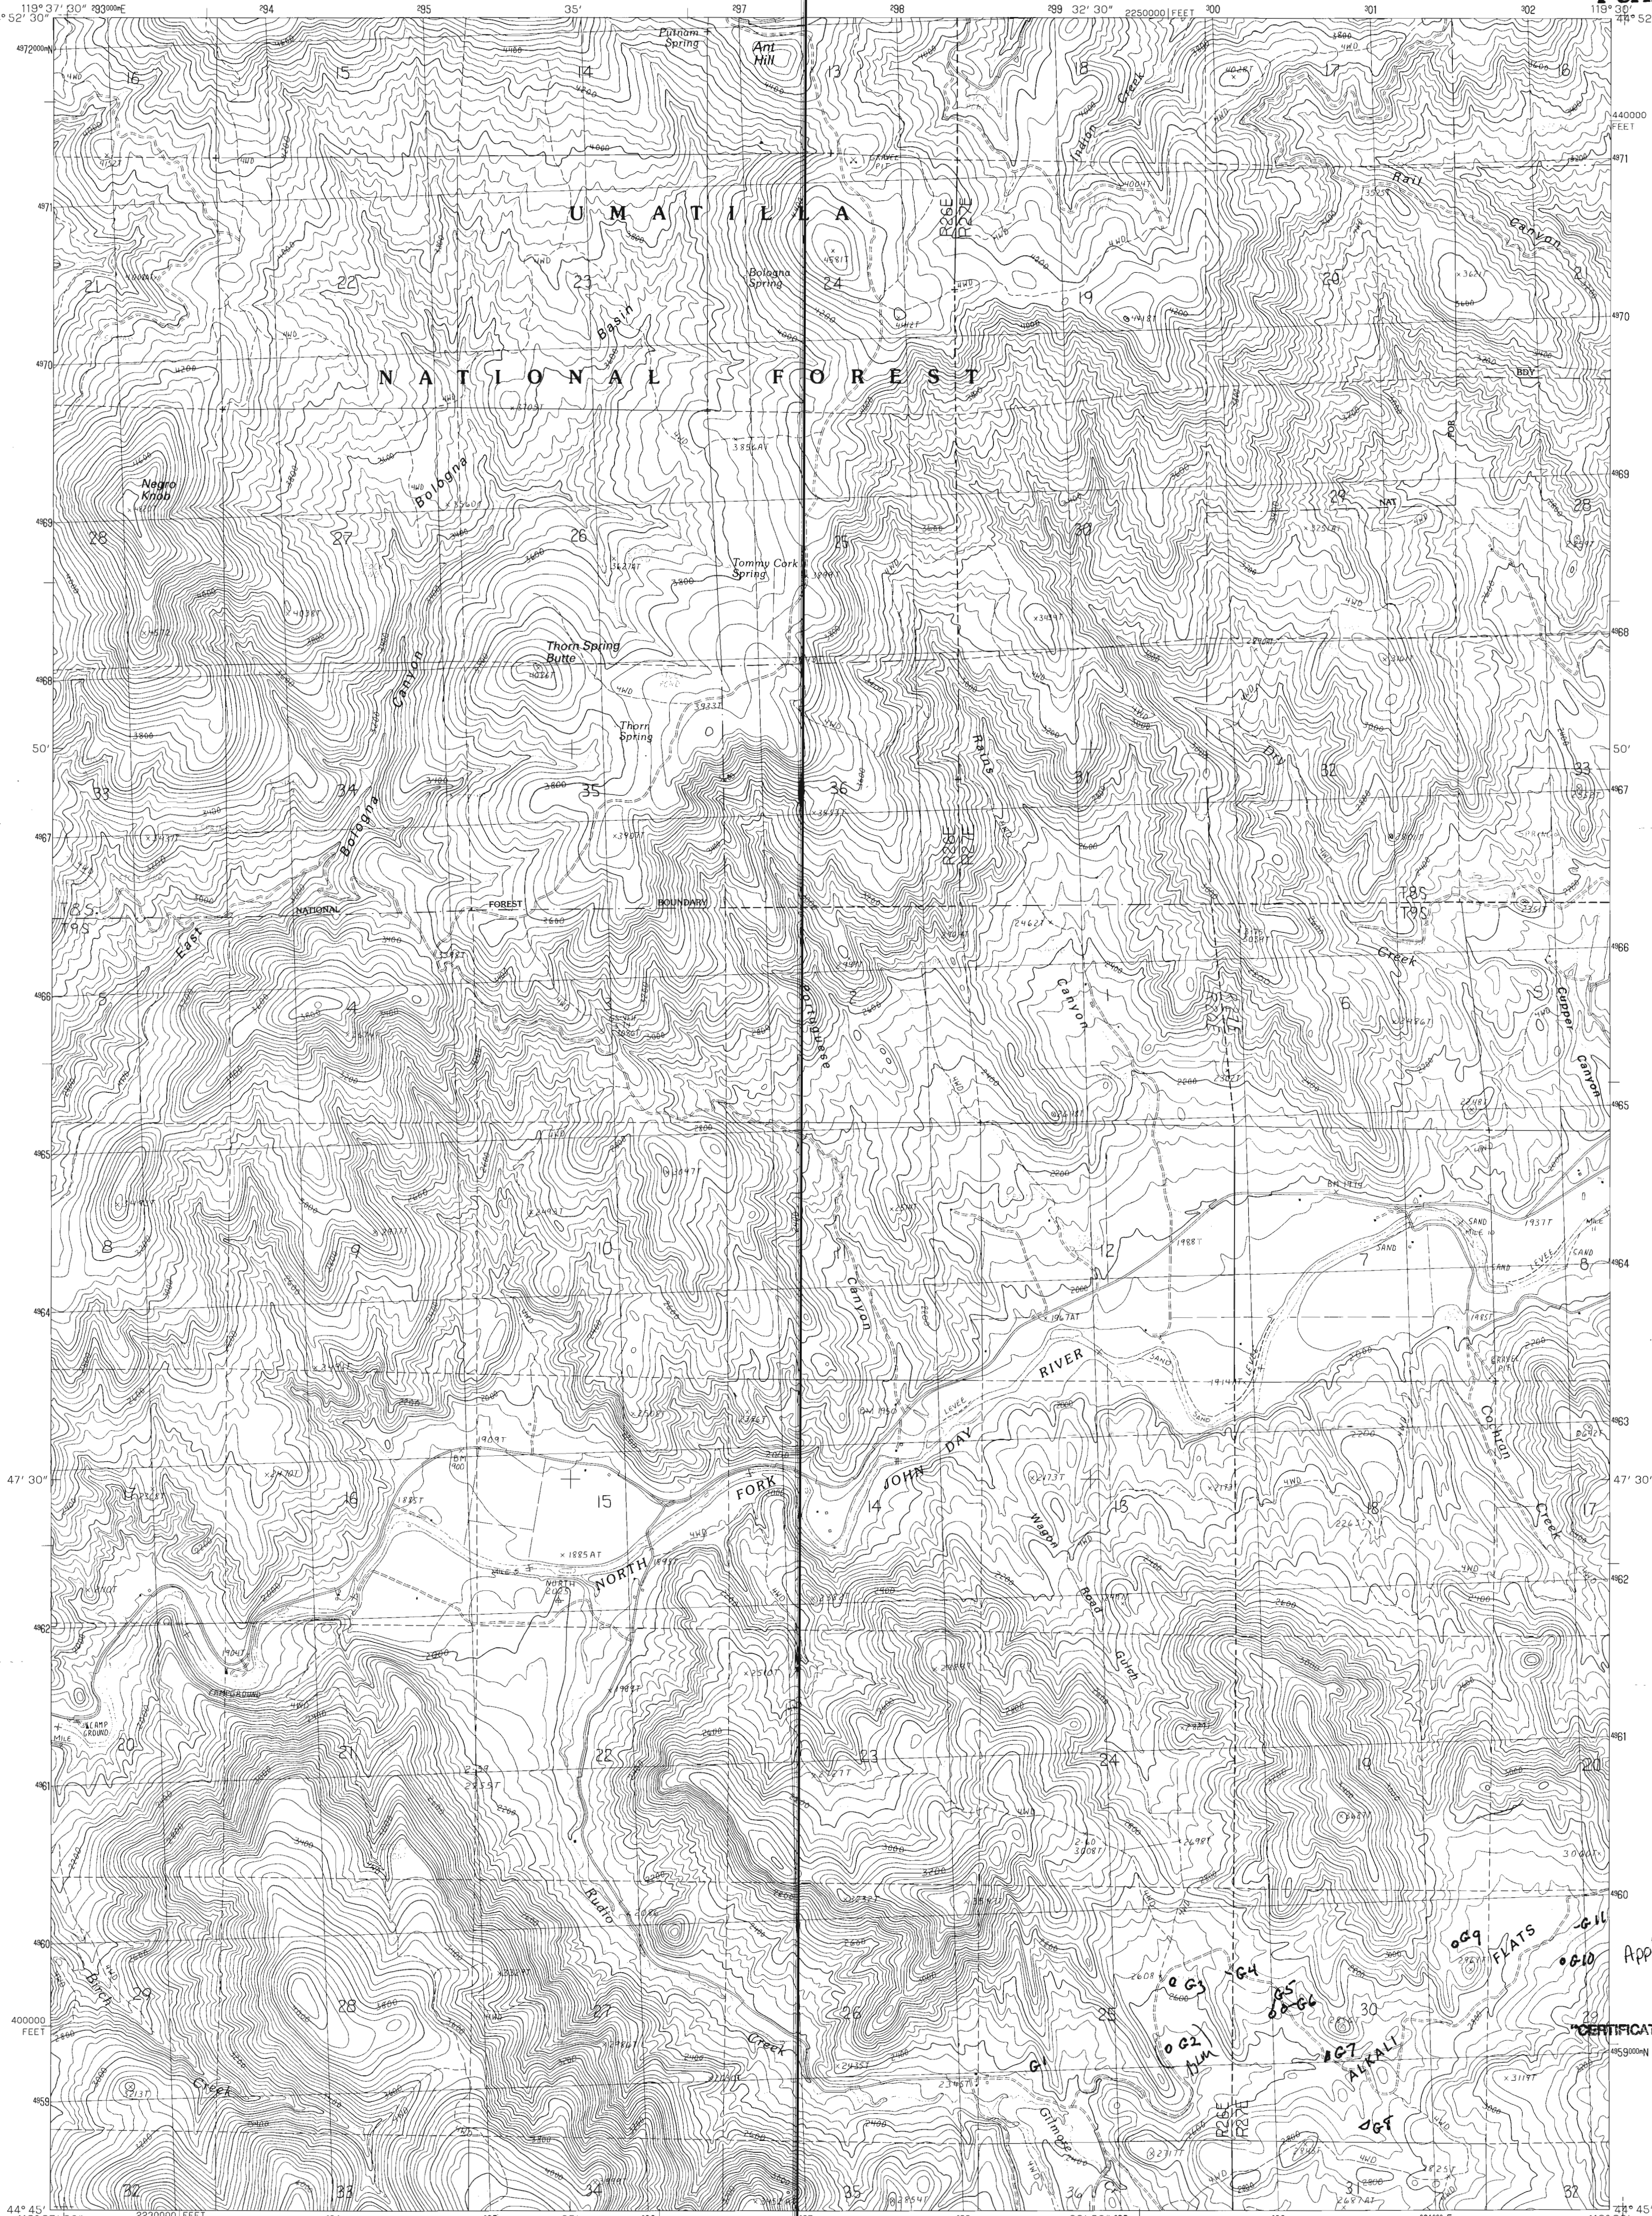

PRODUCED BY THE UNITED STATES GEOLOGICAL SURVEY
CONTROL BY.....USGS AND NOS/NOAA
COMPILED FROM AERIAL PHOTOGRAPHS TAKEN.....1984
FIELD CHECKED.....1987. MAP EDITED.....1990
PROJECTION.....LAMBERT CONFORMAL CONIC
GRID: 1000-METER UNIVERSAL TRANSVERSE MERCATOR.....ZONE 11
10,000-FOOT STATE GRID TICKS.....OREGON, NORTH ZONE
UTM GRID DECLINATION.....1°48' WEST
1990 MAGNETIC NORTH DECLINATION.....18°00' EAST
VERTICAL DATUM.....NATIONAL GEODETIC VERTICAL DATUM OF 1929
HORIZONTAL DATUM.....1927 NORTH AMERICAN DATUM
To place on the predicted North American Datum of 1983,
move the projection lines as shown by dashed corner ticks
(19 meters north and 86 meters east)
There may be private inholdings within the boundaries of any
Federal or State reservations shown on this map
No distinction made between houses, barns, and other buildings

PROVISIONAL MAP
Produced from original
manuscript drawings. Infor-
mation shown as of date of
field check.

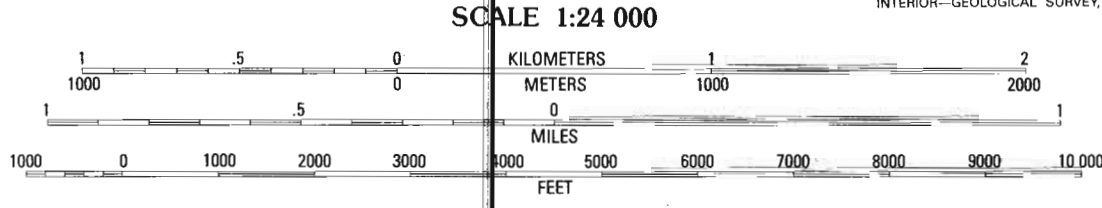

THIS MAP COMPLIES WITH NATIONAL MAP ACCURACY STANDARDS
FOR SALE BY U.S. GEOLOGICAL SURVEY
DENVER, COLORADO 80225, OR RESTON, VIRGINIA 22092

1	2	3	1 Whitetail Butte
			2 Turner Mtn
			3 Johnny Cake Mtn
4		5	4 Kimberly
			5 Monument
			6 Mt Misery
6	7	8	7 Miller Flat
			8 Courthouse Rock

ROAD LEGEND
Improved Road
Unimproved Road
Trail
Interstate Route U.S. Route State Route

BOLOGNA BASIN, OREGON
PROVISIONAL EDITION 1990


44119-G5-TF-024

119° 37' 30"
4° 45'

2 MILLER FLAT QUADRANGLE
OREGON-GRANT CO.
7.5 MINUTE SERIES (TOPOGRAPHIC)

RECEIVED

DEC 29 1994
WATER RESOUR.
SALEM, OREGON

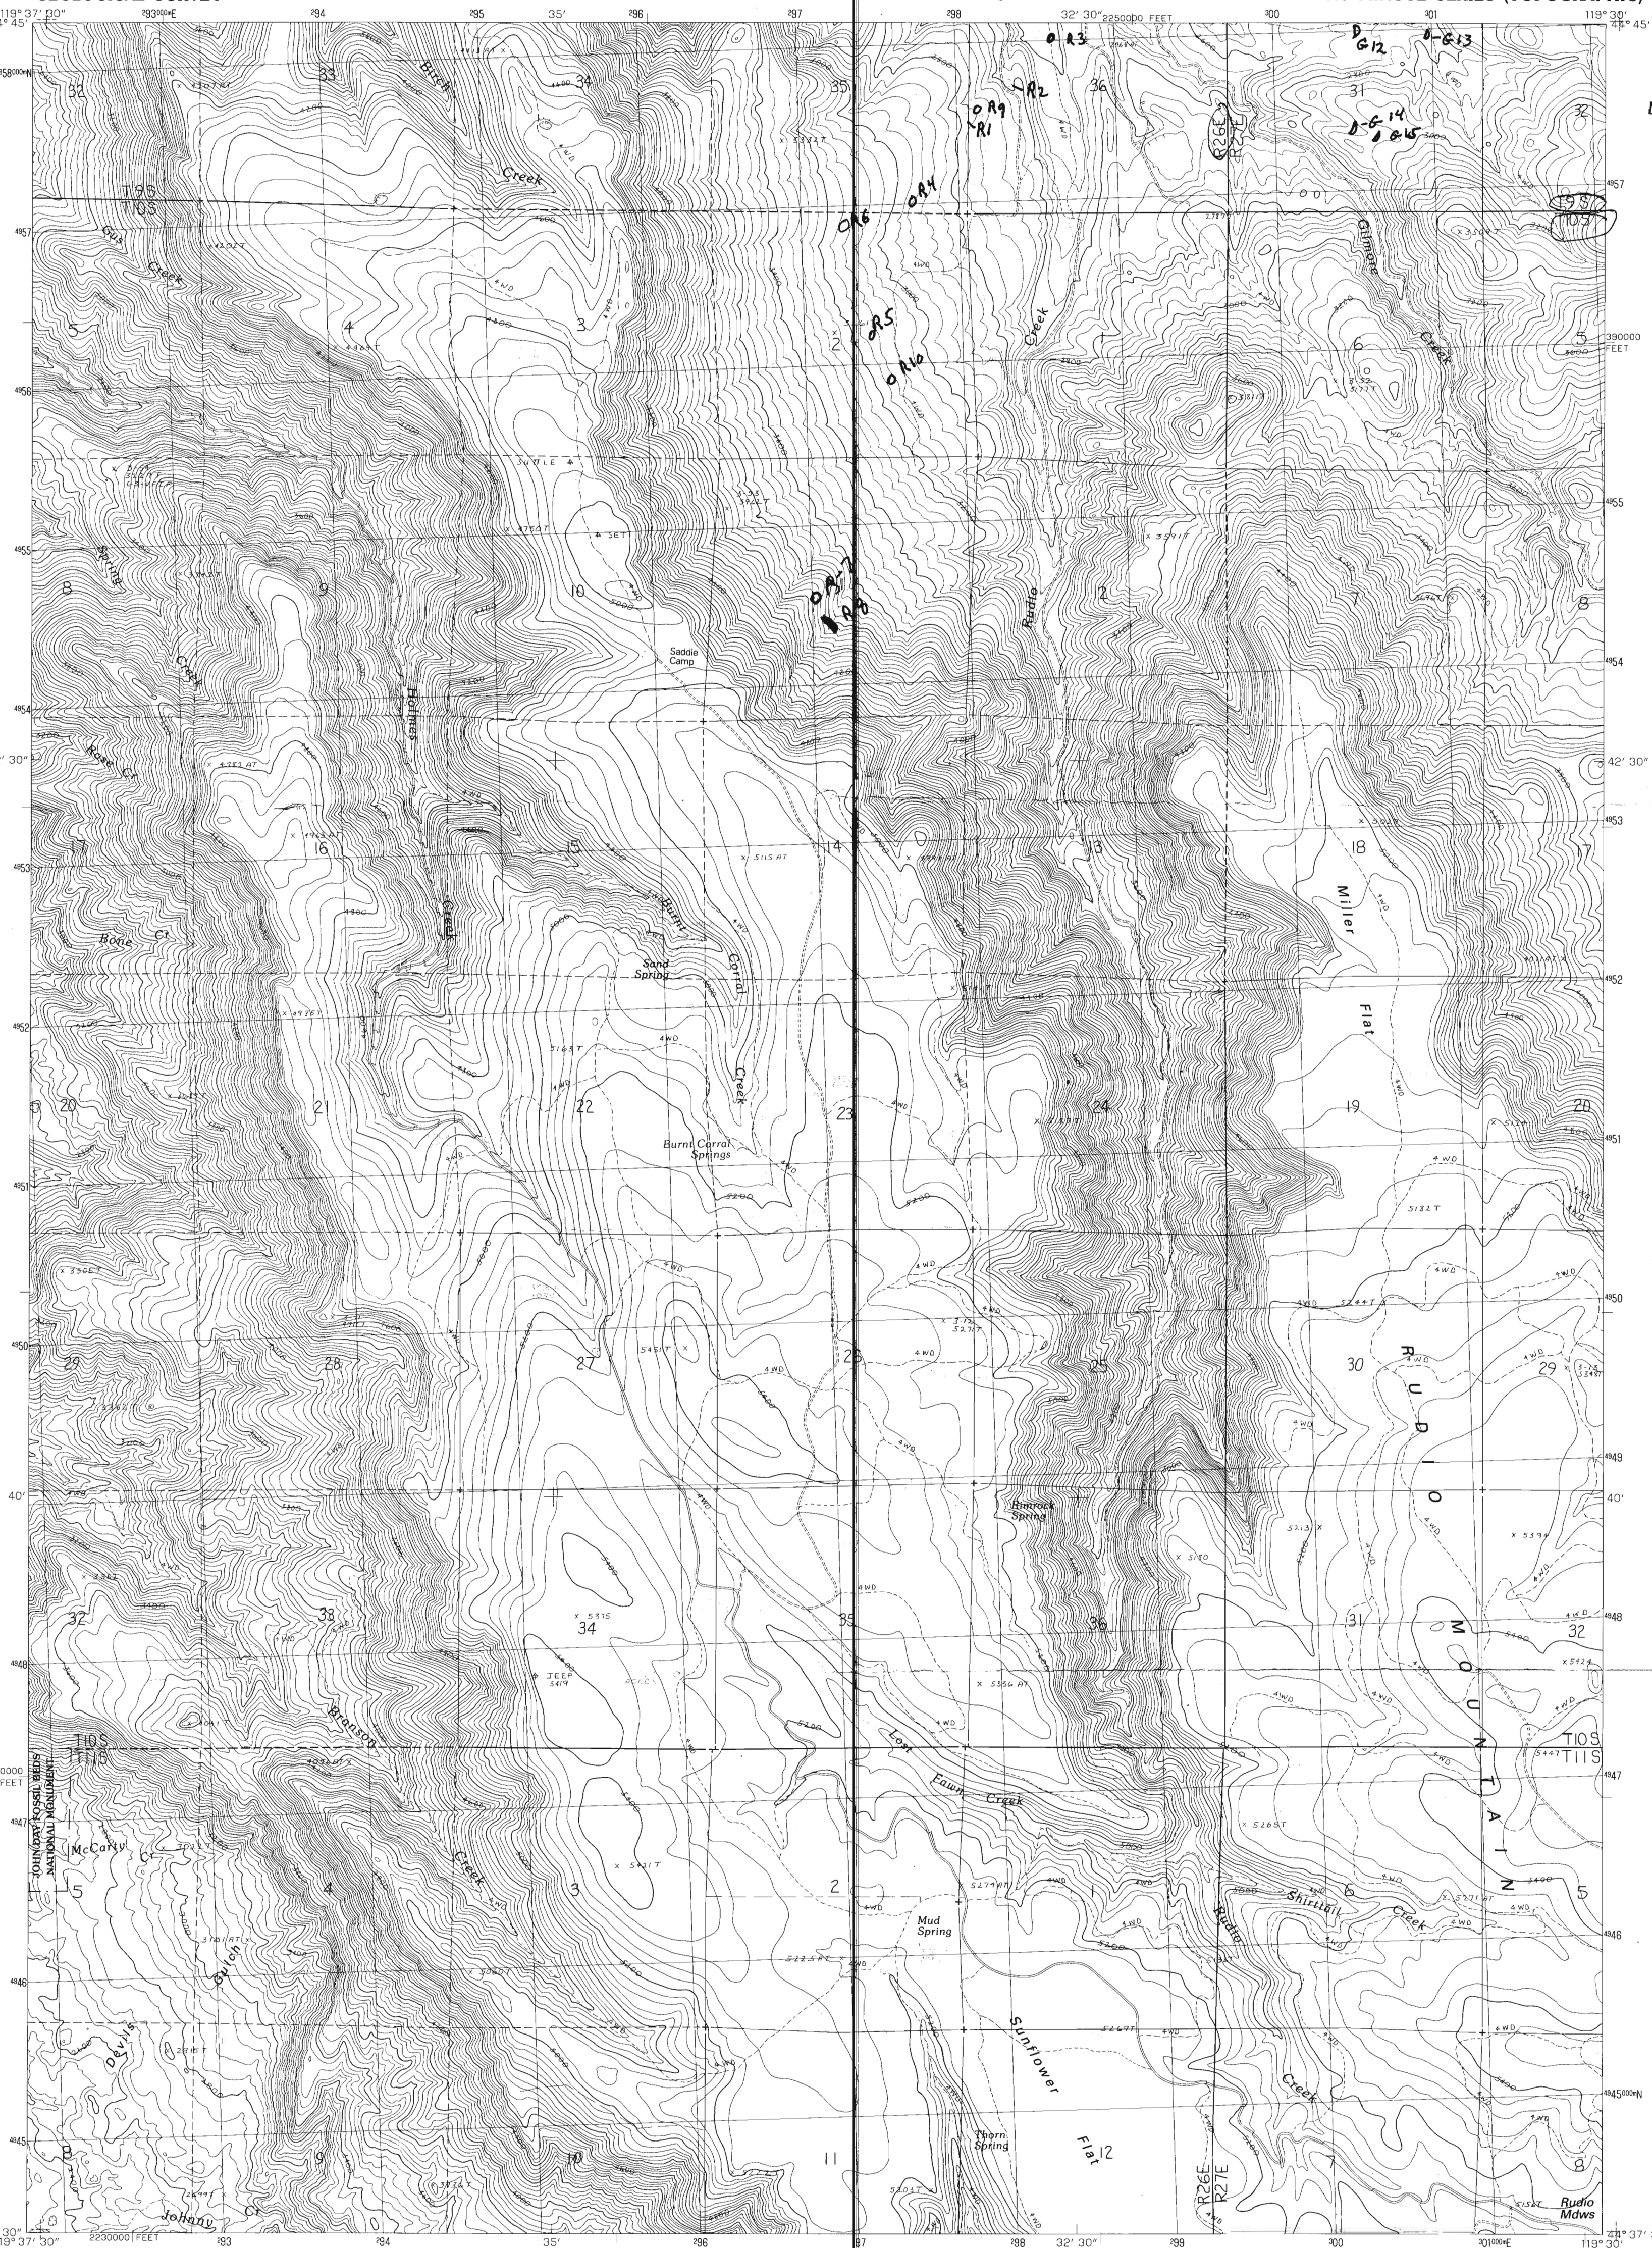

OODUCED BY THE UNITED STATES GEOLOGICAL SURVEY
 NTROL BY _____ USGS AND NOS-NOAA
 MPLED FROM AERIAL PHOTOGRAPHS TAKEN _____ 1984
 LD CHECKED _____ 1986. MAP EDITED _____ 1990
 OBJECTION _____ LAMBERT CONFORMAL CONIC
 _____ UNIVERSITY TRANSVERSE MERCATOR _____ ZONE 11
 10.000-FOOT STATE GRID TICKS _____ OREGON, NORTH ZONE
 M GRID DECLINATION _____ 18° 48' EAST
 0 MAGNETIC NORTH DECLINATION _____ 18°00' EAST
 _____ NATIONAL GEODETIC VERTICAL DATUM OF 1929
 _____ HORIZONTAL DATUM _____ 1927 NORTH AMERICAN DATUM
 place on the predicted North American Datum of 1983,
 the projection lines as shown by dashed corner ticks
 _____ meters north and 86 meters east)
 there may be private inholdings within the boundaries of any
 Federal or State reservations shown on this map

PROVISIONAL MAP
Produced from original
manuscript drawings. Infor-
mation shown as of date of
field check. 2

SCALE 1:24 000

INTERIOR - GEOLOGICAL SURVEY.

The scale bar is divided into four segments:

- KILOMETERS:** 0 to 5
- METERS:** 0 to 2000
- MILES:** 0 to 1
- FEET:** 0 to 10000

CONTOUR INTERVAL 40 FEET

THIS MAP COMPLIES WITH NATIONAL MAP ACCURACY STANDARDS
FOR SALE BY U. S. GEOLOGICAL SURVEY
DENVER, COLORADO 80225, OR RESTON, VIRGINIA 22092



OREGON

QUADRANGLE LOCATION

1	2	3	1 Kimberly 2 Bologna Basin 3 Monument 4 Mt. Misery 5 Courthouse Rock 6 Picture Gorge W 7 Picture Gorge E. 8 Sheep Ridge
4		5	
6	7	8	

ROAD LEGEND

Improved Road
Unimproved Road
Trail
 Interstate Route  U. S. Route  State Route

MILLER FLAT, OREGON
PROVISIONAL EDITION 1990

44119-F5-TF-024