

Application No. *R-76494*
Permit No.


"CERTIFICATE NO. 73405"

T. 13 S.R. 6 W.W.M.

RECEIVED

DEC 28 1994

WATER RESOURCES DEPT
SALEM, OREGON

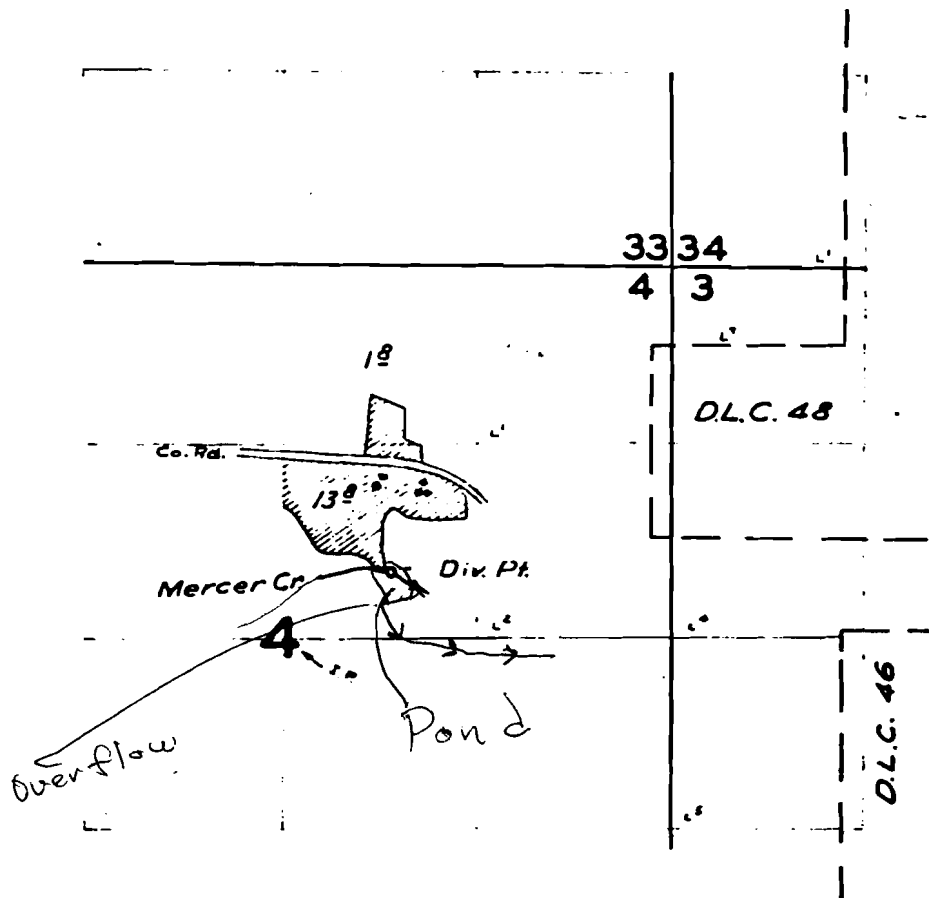

FINAL PROOF SURVEY
UNDER

Application No. *32188* Permit No. *25391*
IN NAME OF

GLENN & MARY DECKER

Surveyed 2 Oct. 1958, by *C.O. Bartels*

OFJ-3D-25
1959-B