


POND

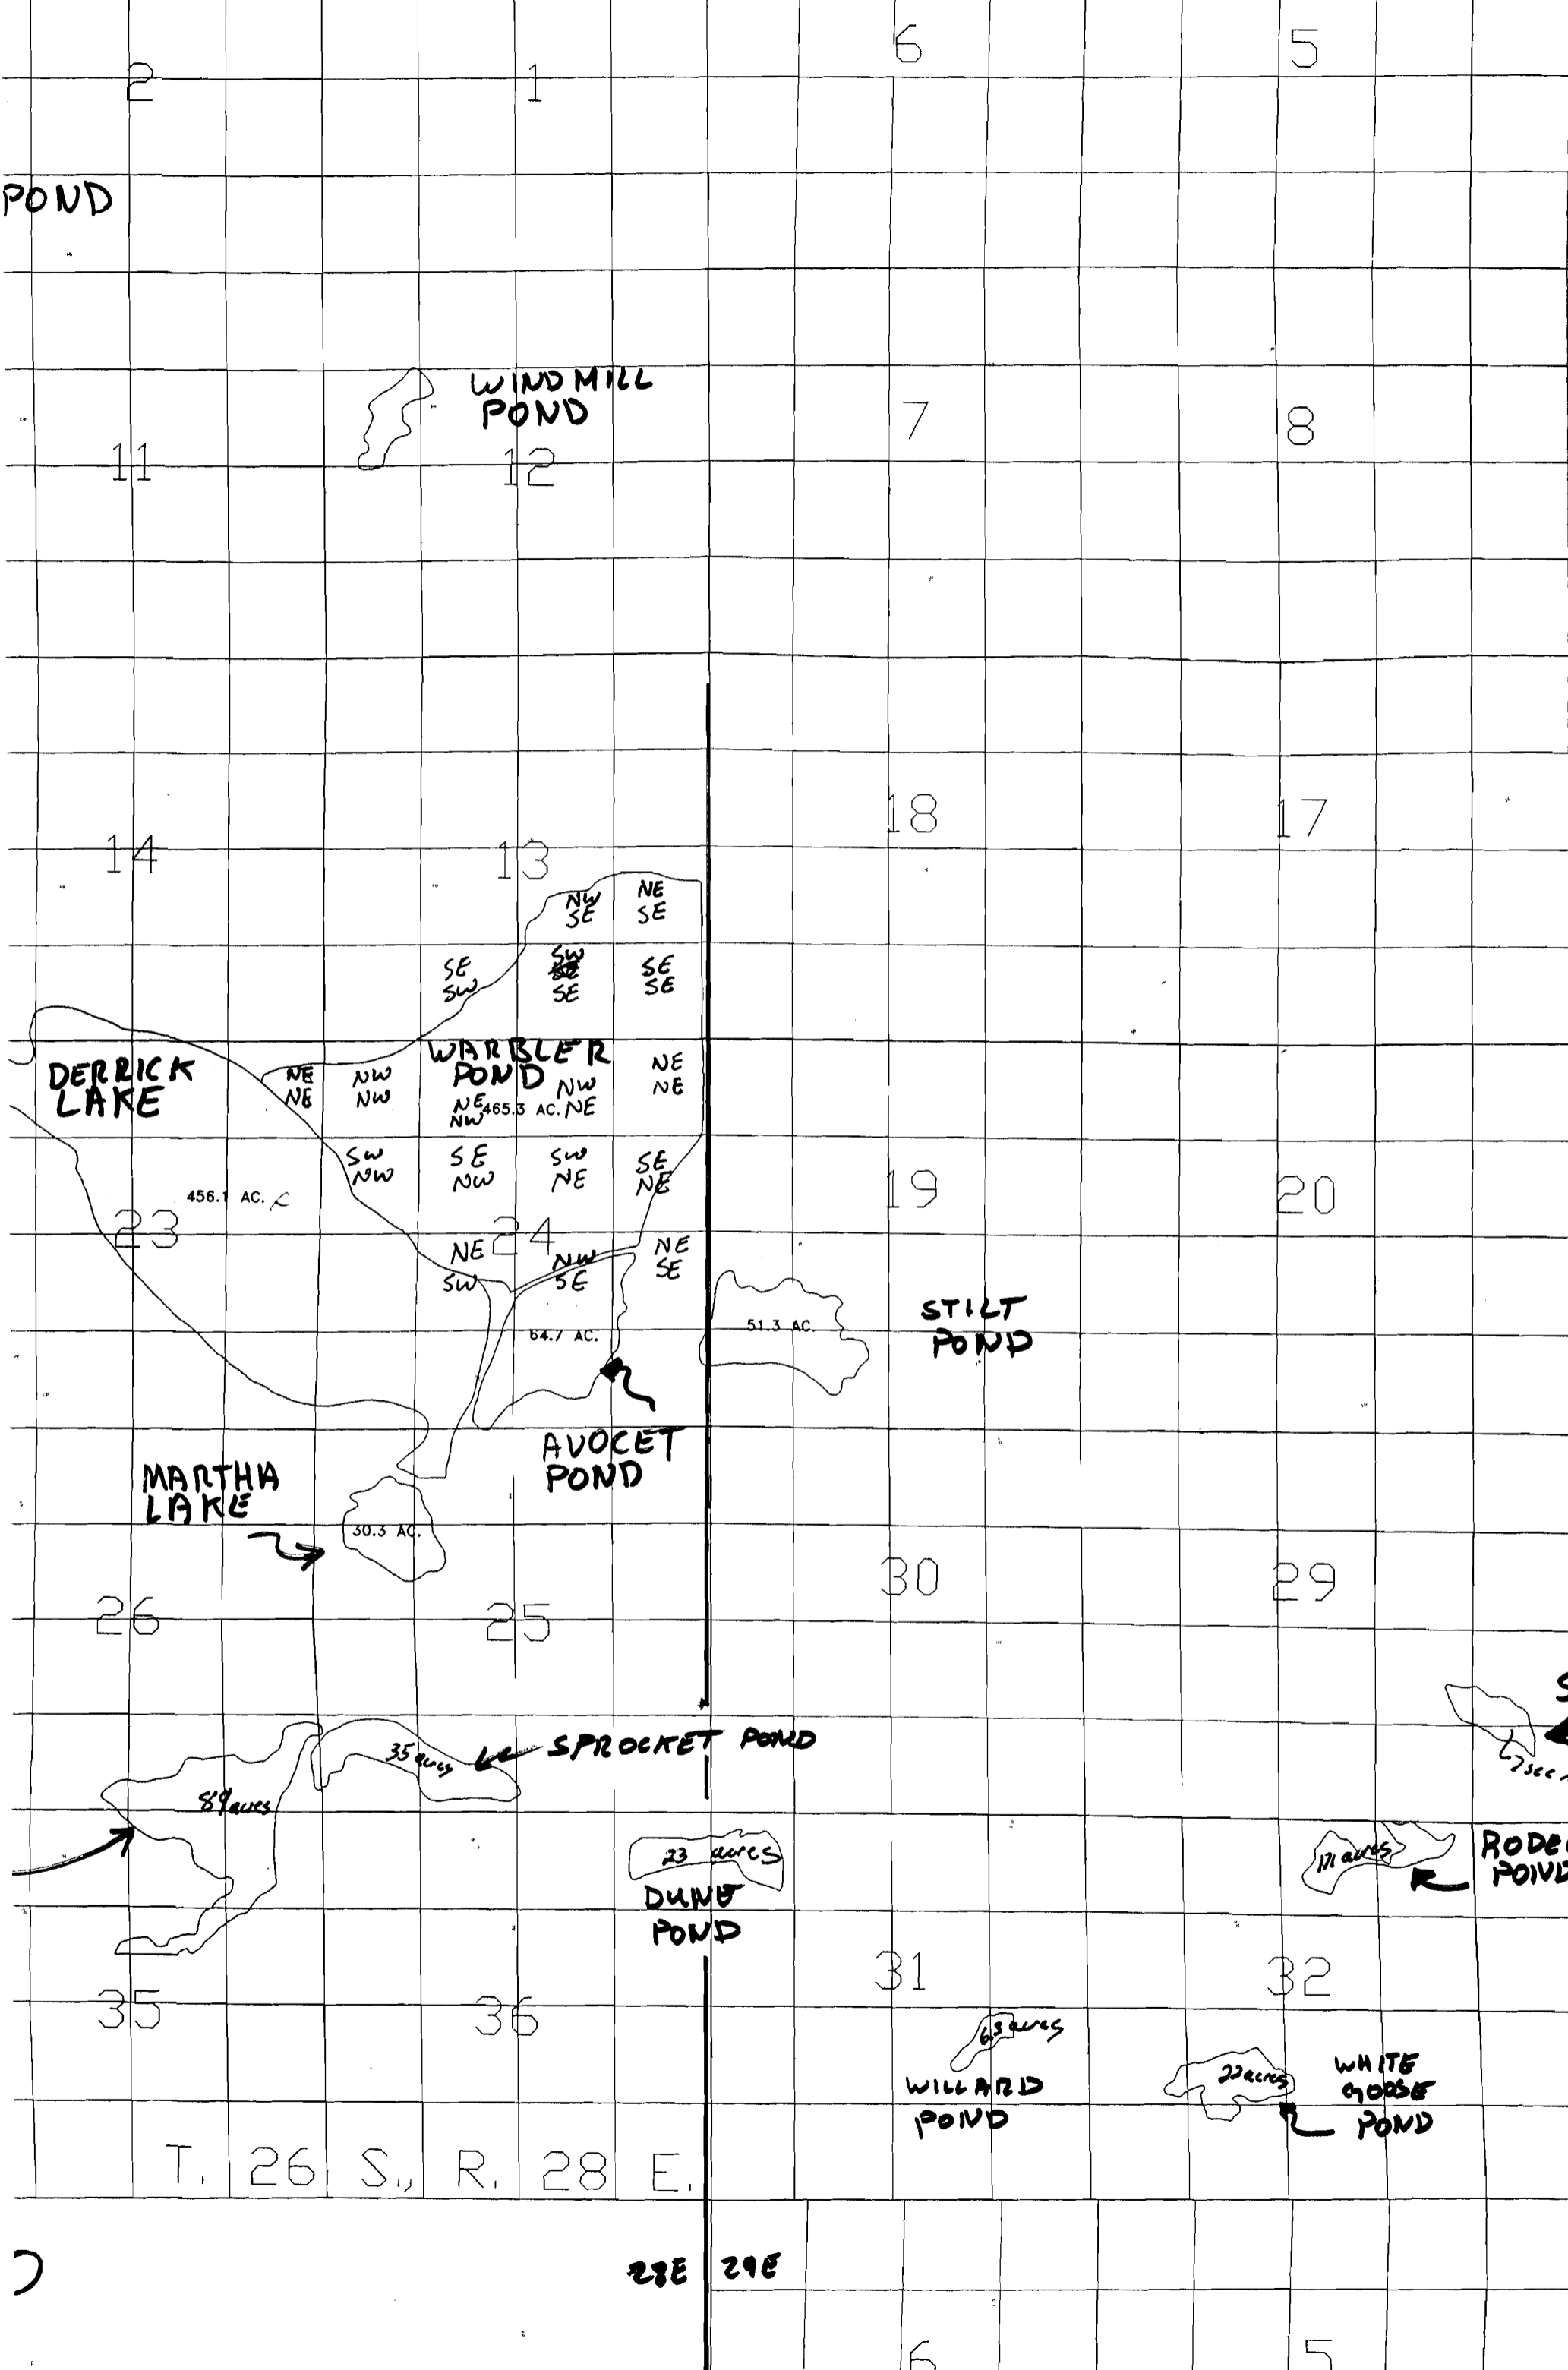

2

28E 29E

6

5