

UNITED STATES
DEPARTMENT OF THE INTERIOR
GEOLOGICAL SURVEY


RECEIVED

JAN - 6 1995

Application No. R-76544
Permit No.

Sheep Ridge Quad
T11S R27E Sec 17
SE 1/4 NE 1/4

CERTIFICATE NO. 70575

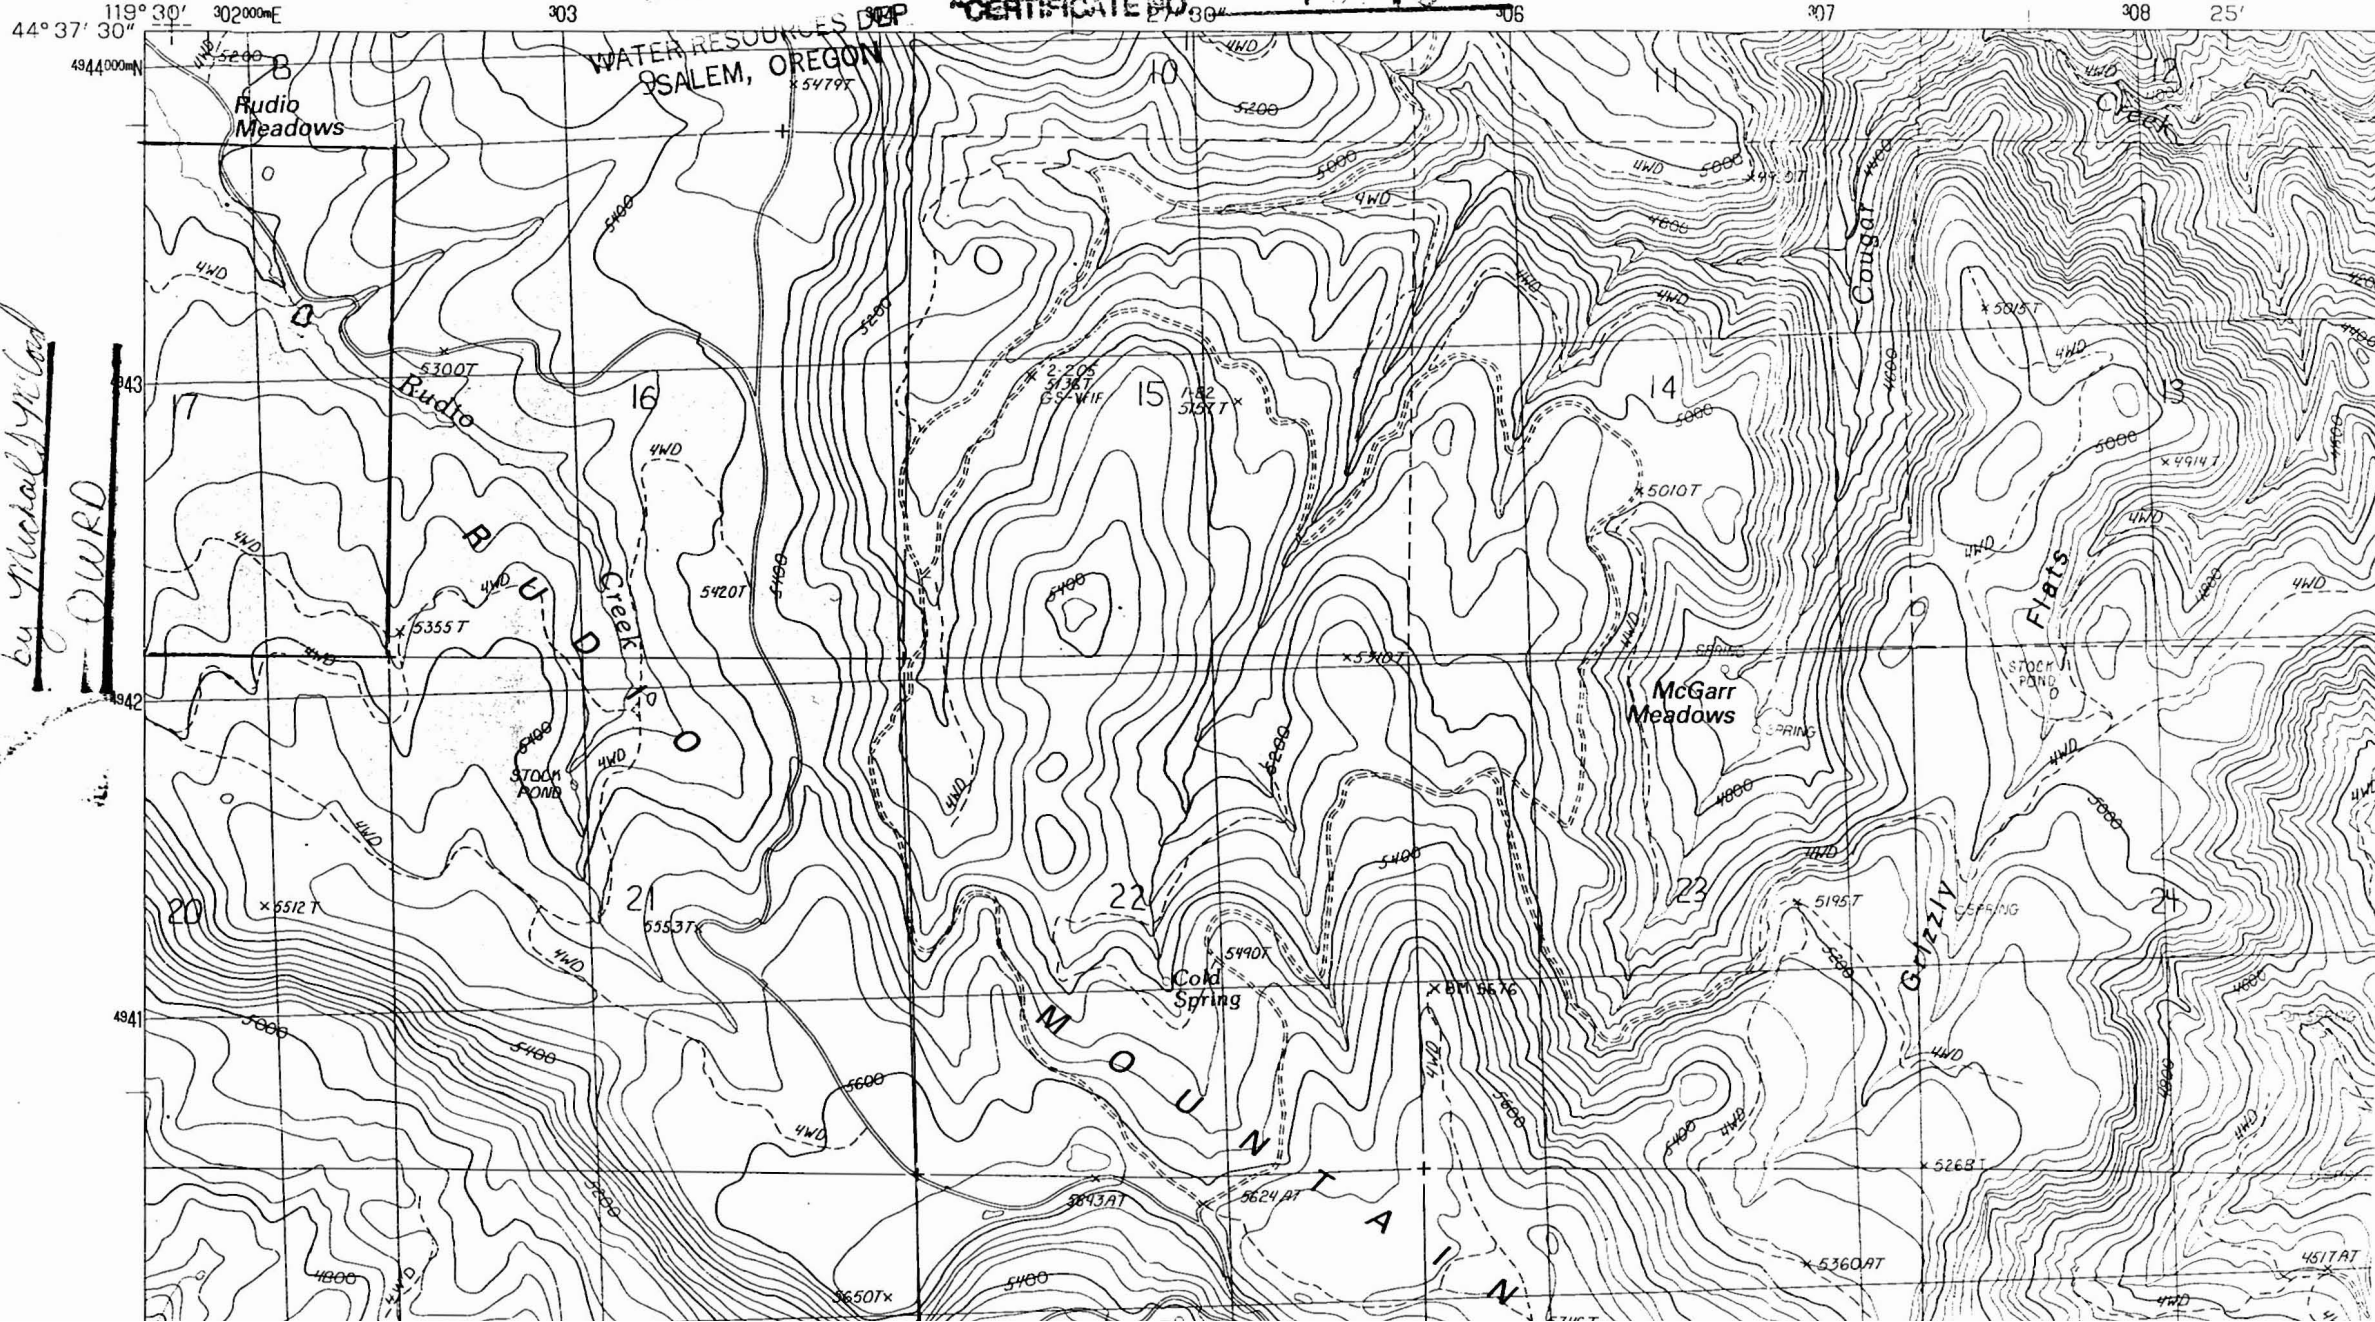

Received Jan 3, 1995
by Michael J. McLeod
OWRD

No Final Proof Map available

No Permit Map available