


$$1'' = 2000'$$

R-74545

SALFRA, OREGON

0 25

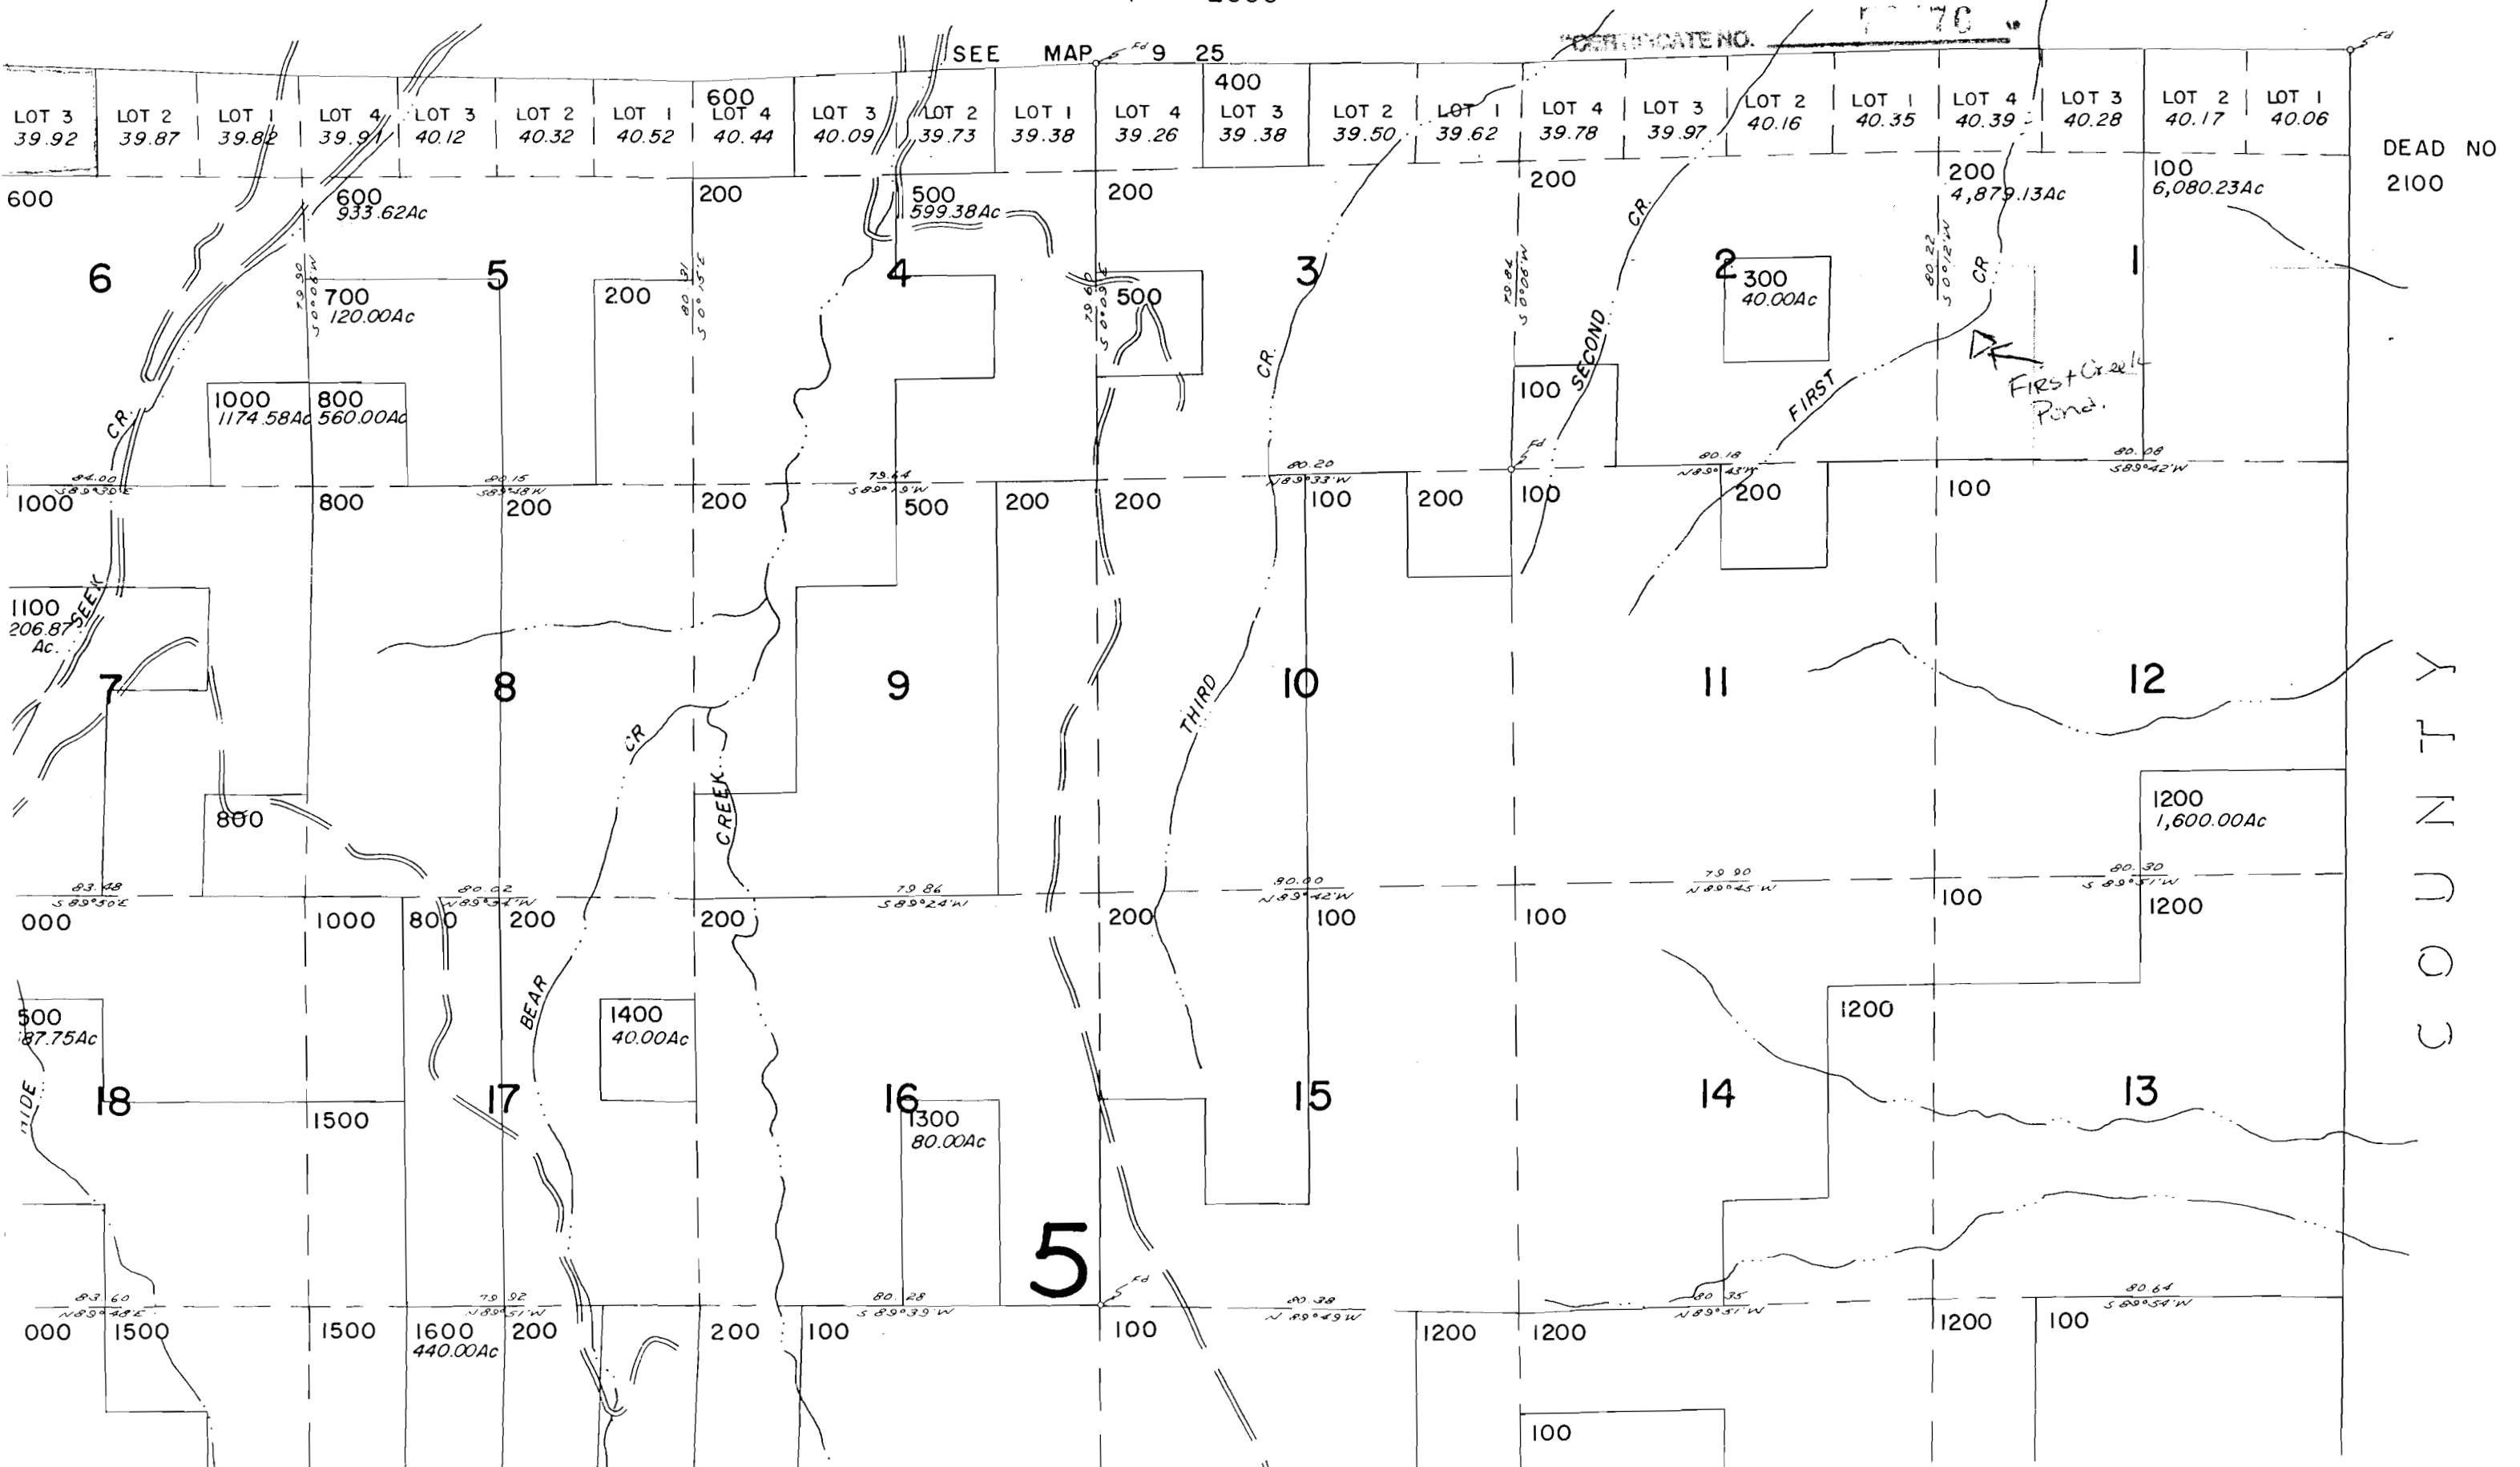

No Final Proof Map available

No Permit Map available