


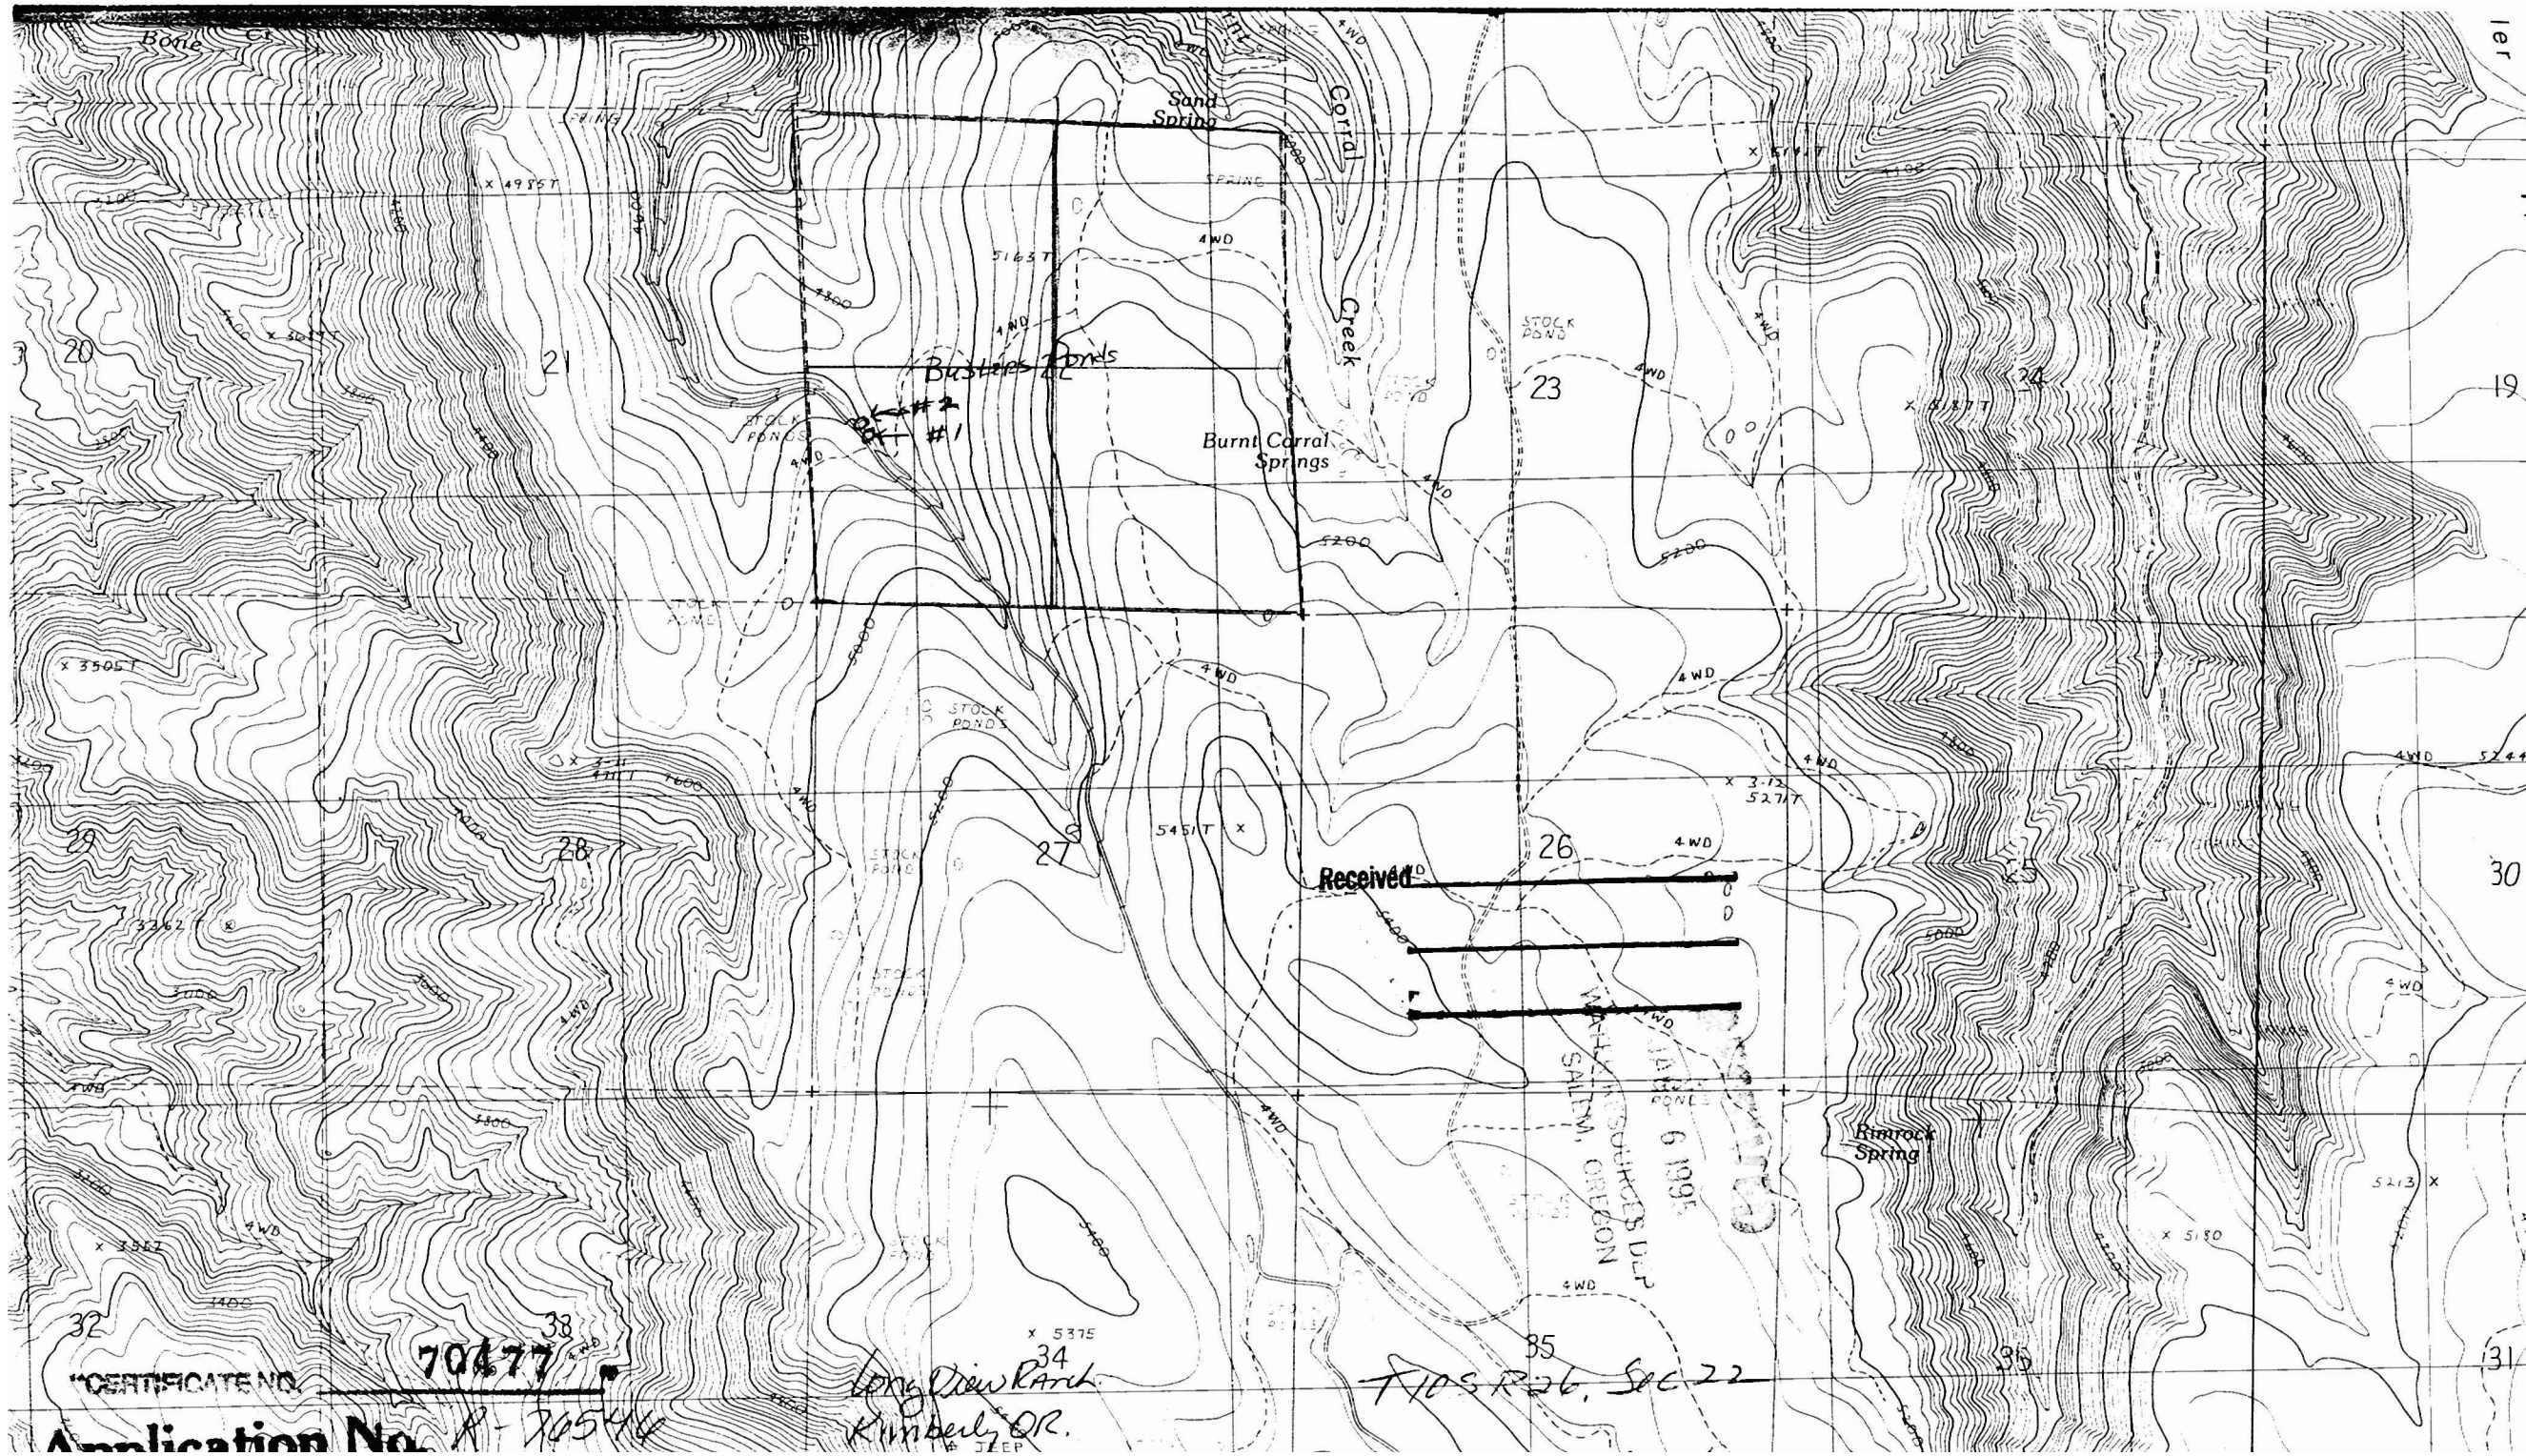

CERTIFICATE NO. 70477
Application No. A-70546

Long View Ranch
Kimberly, OR.

705 R26, Sec 22

No Final Proof Map available

No Permit Map available