


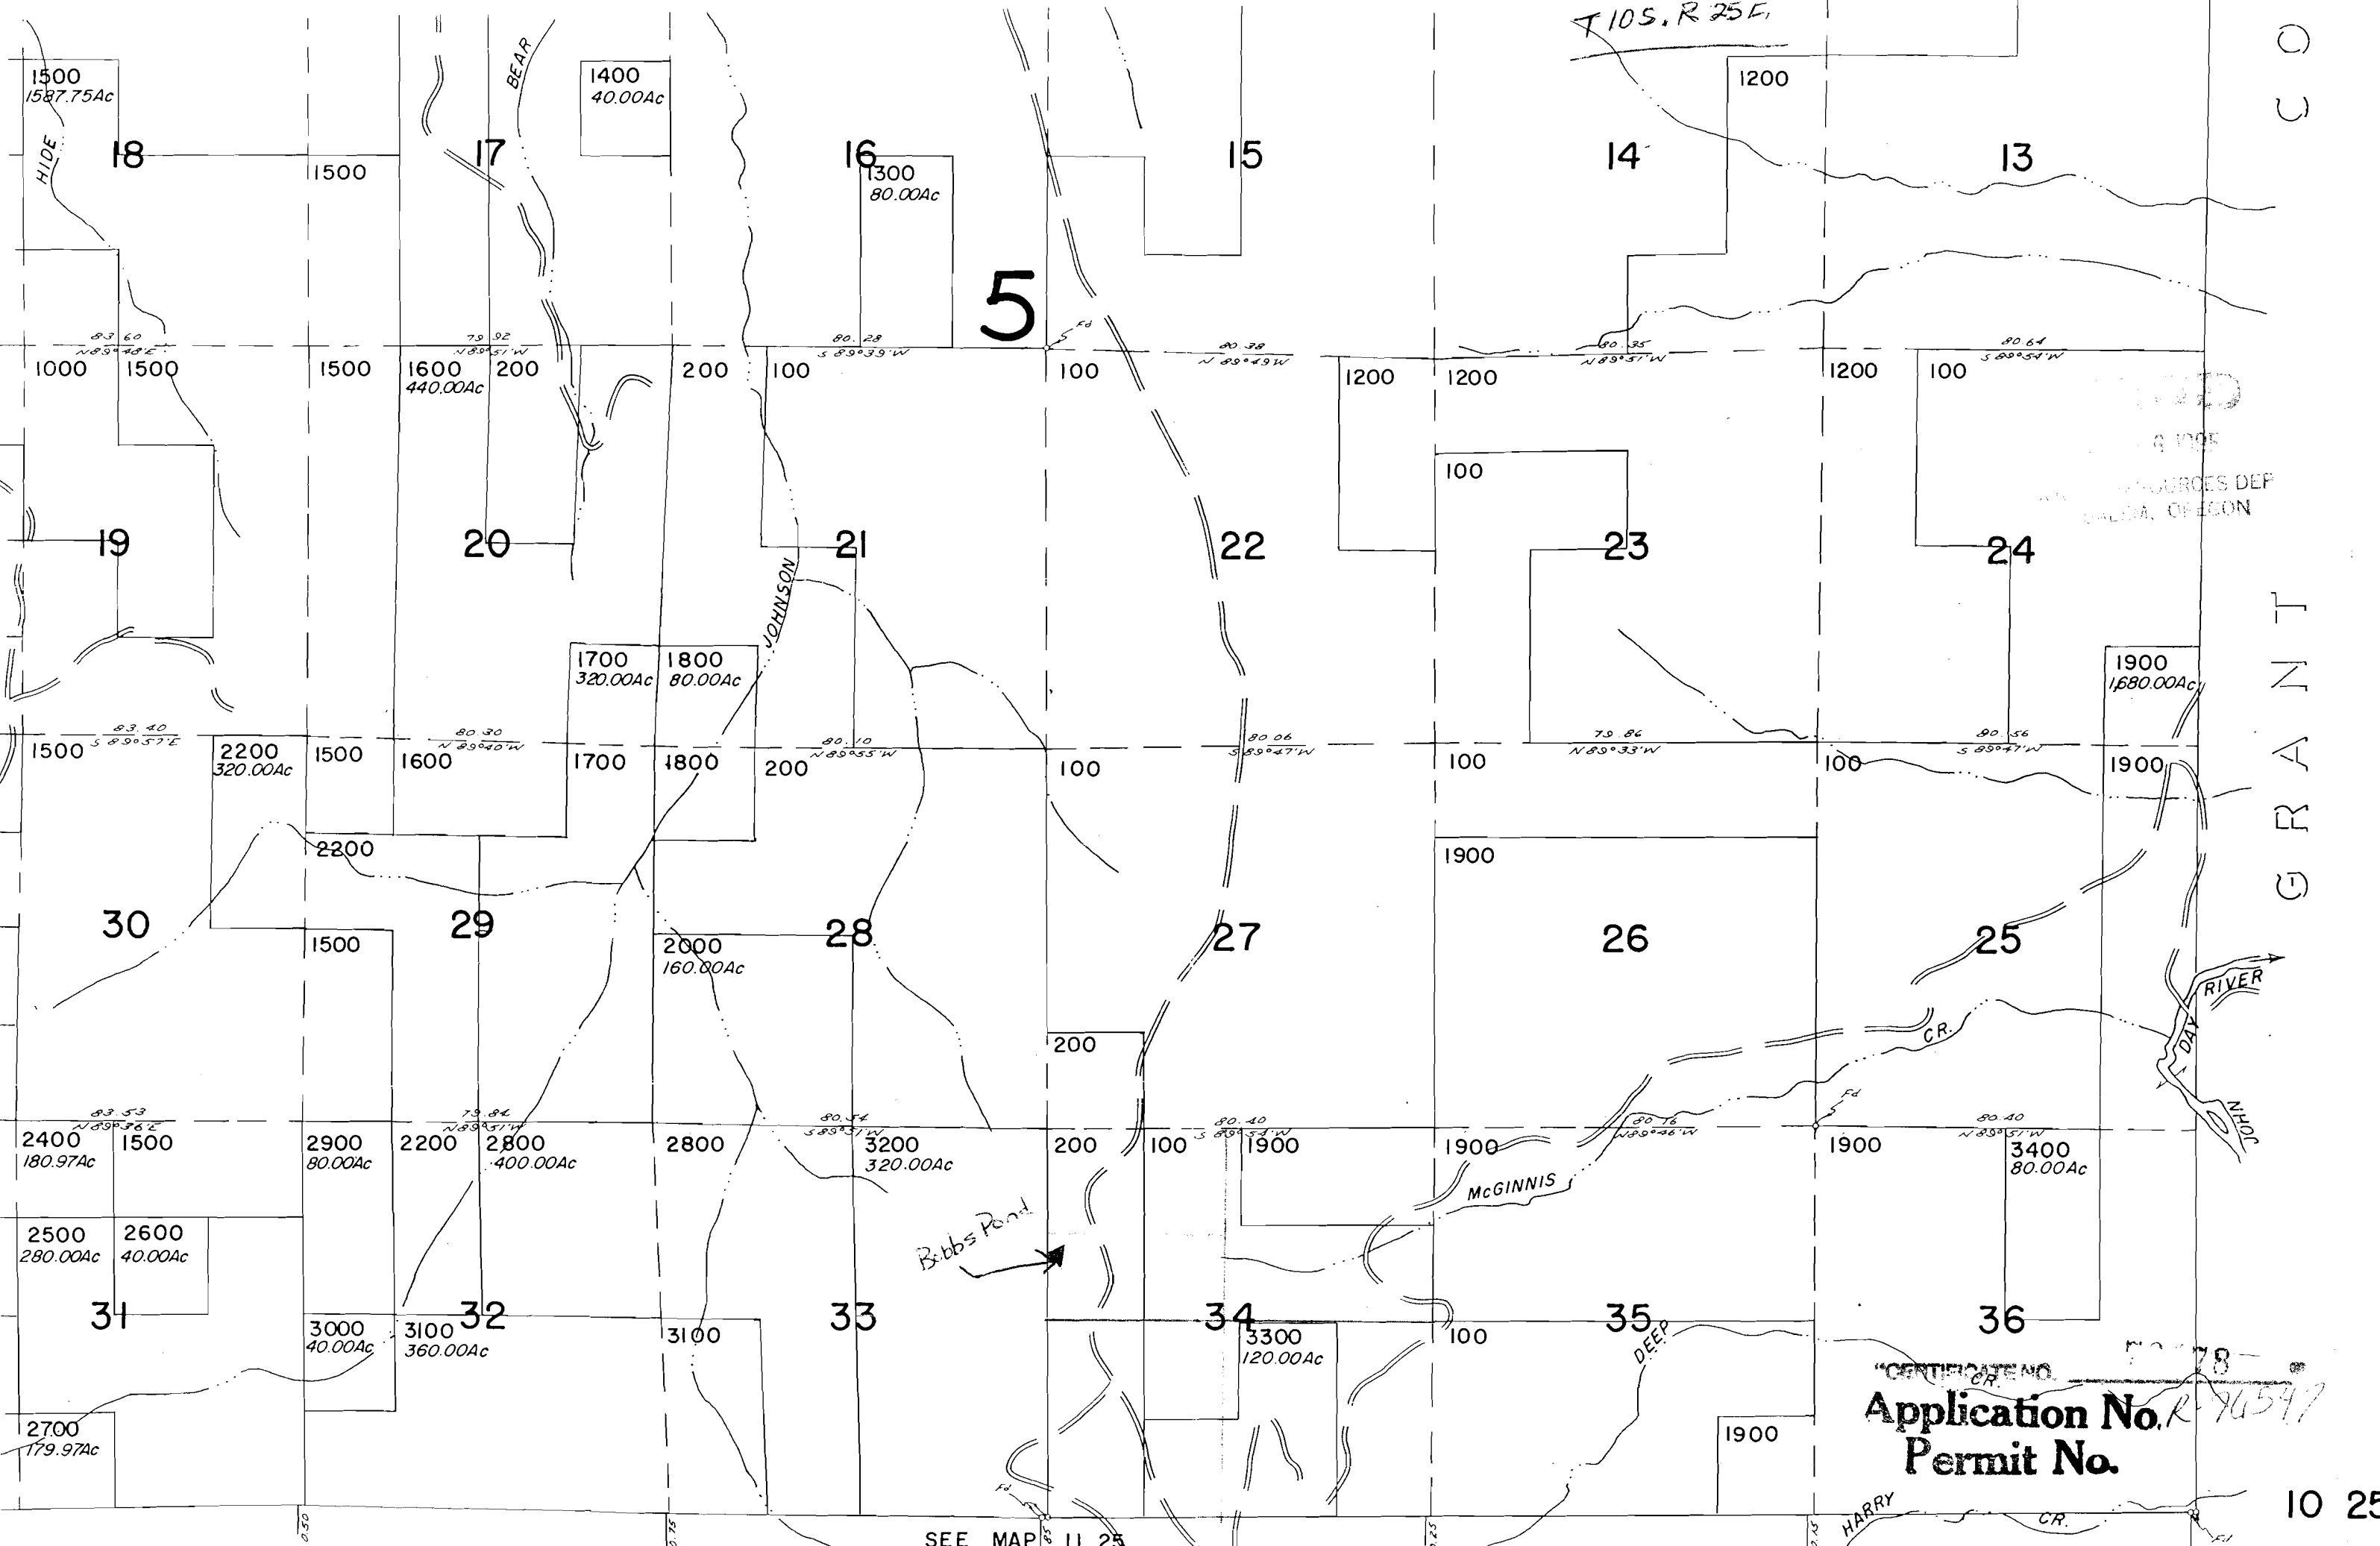

SEE MAP II 25

No Final Proof Map available

No Permit Map available