


10 2

SALEM, OREGON

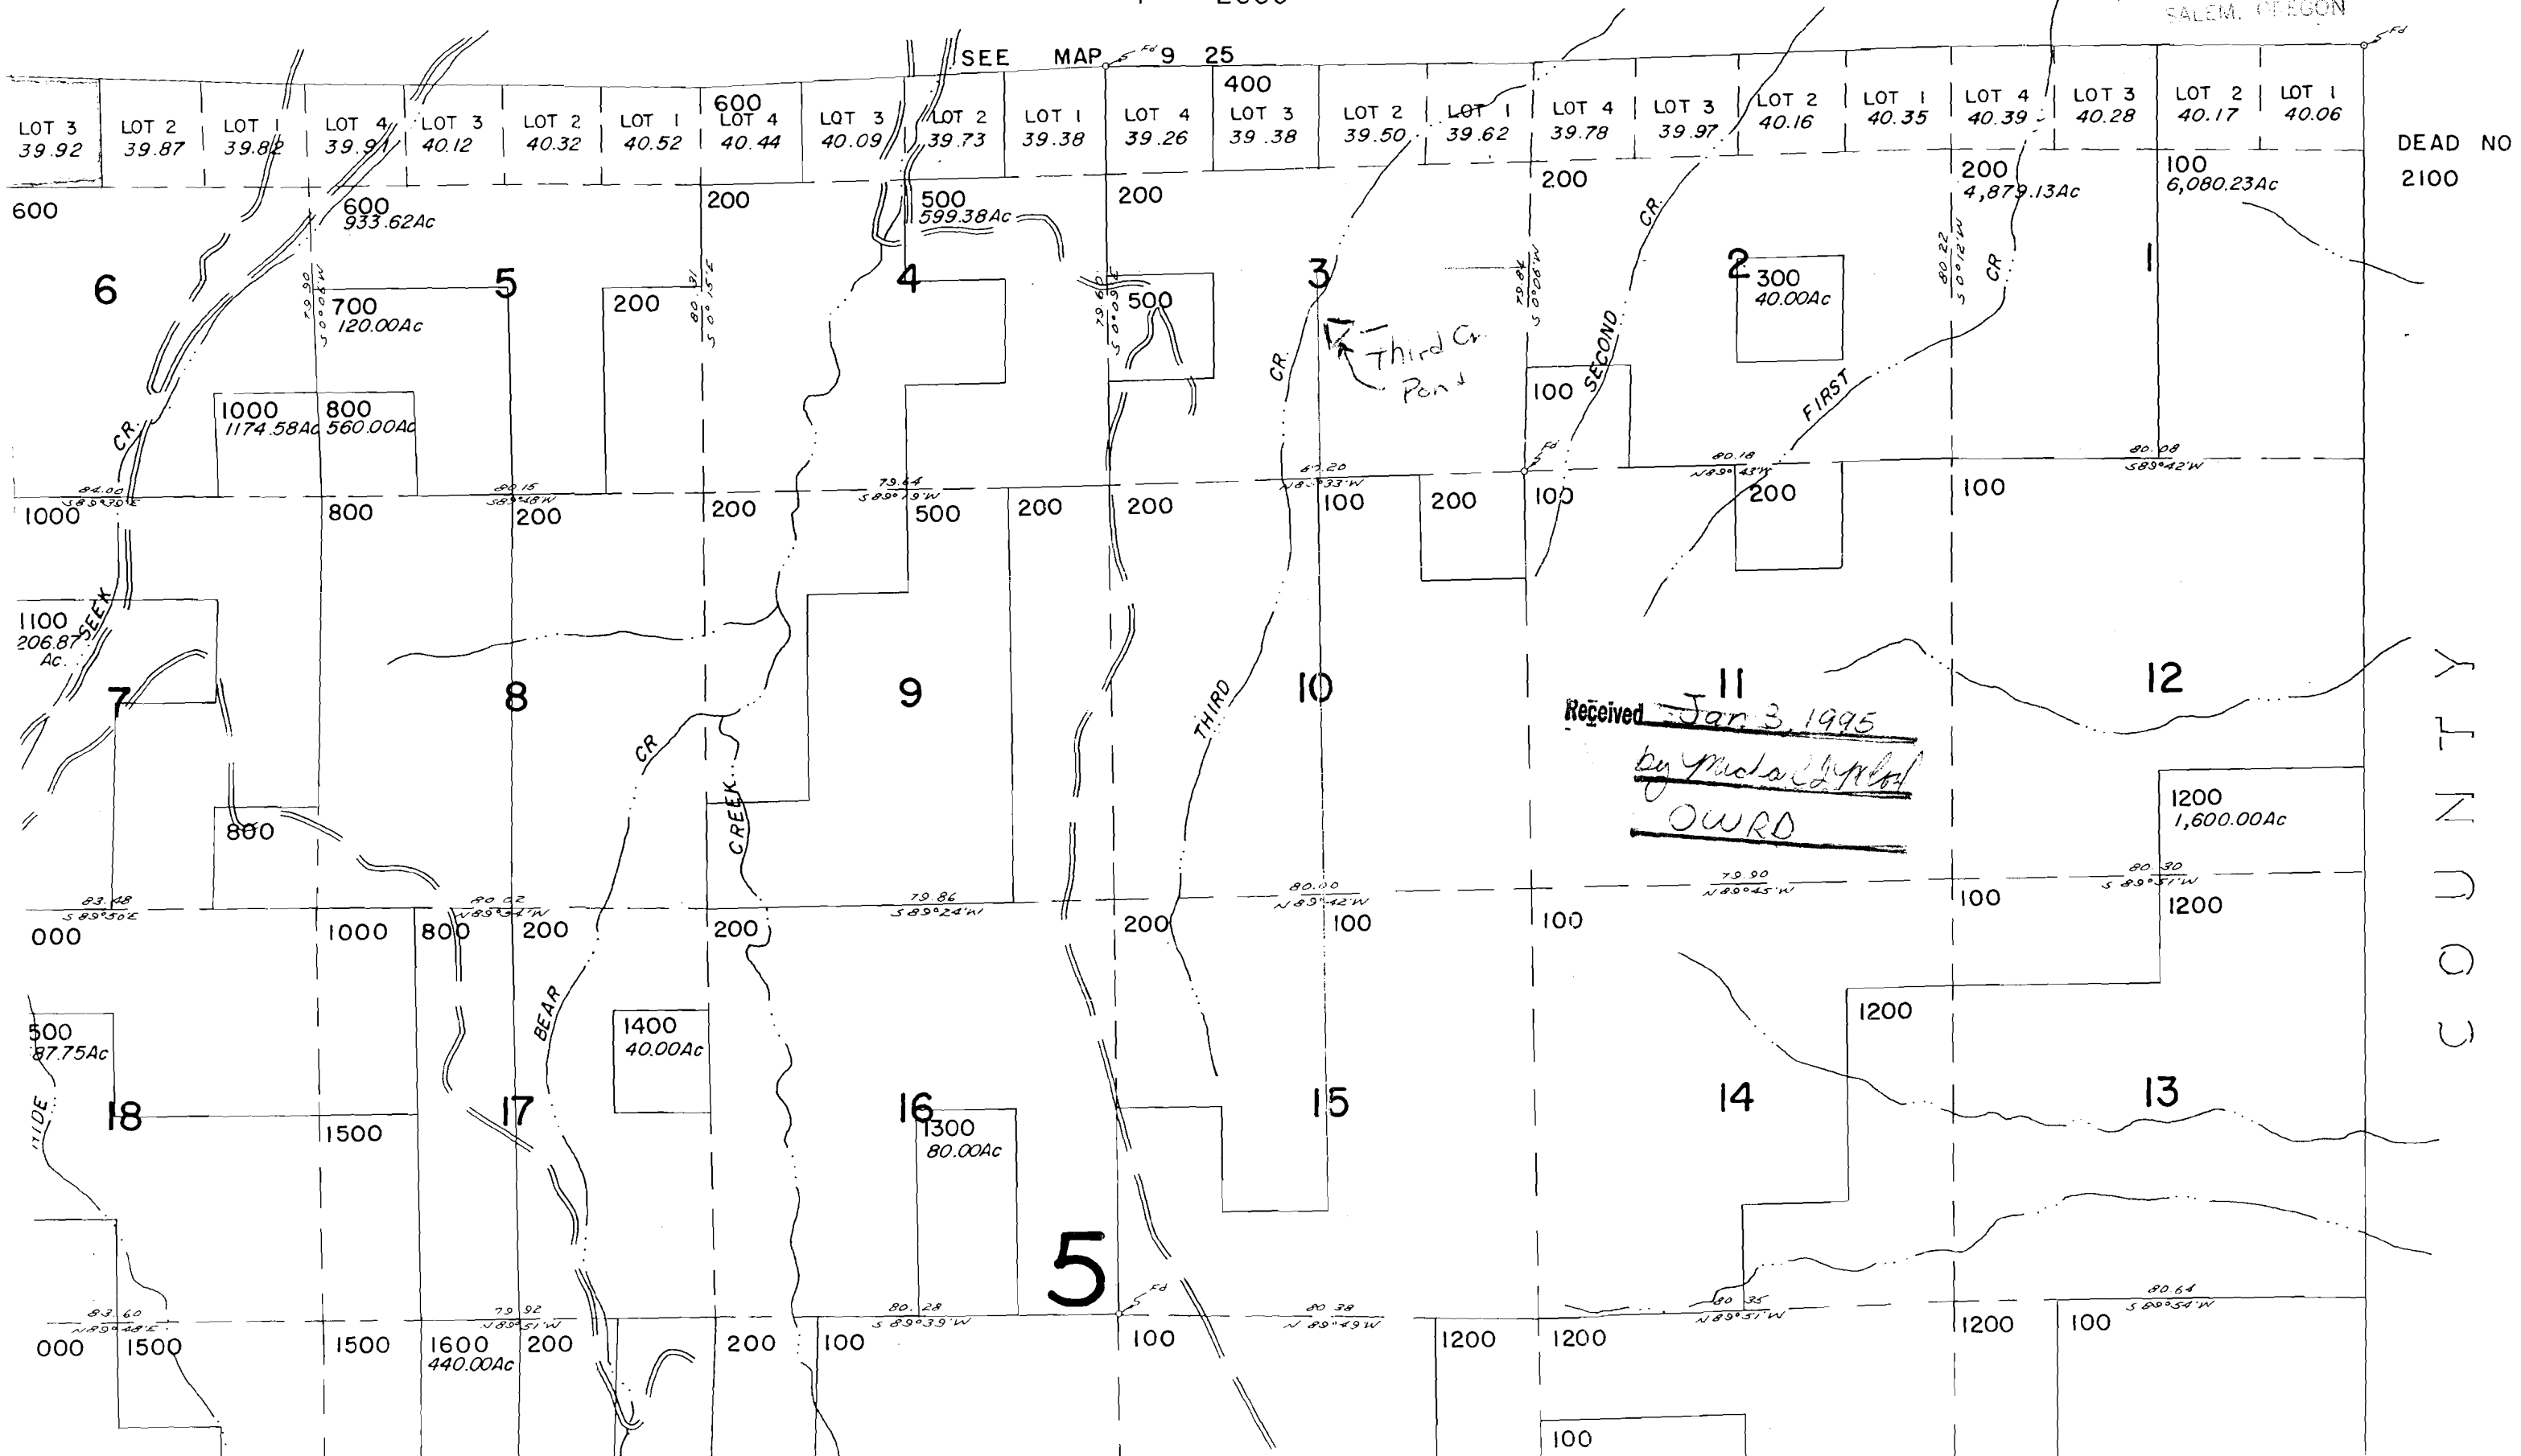

No Final Proof Map available

No Permit Map available