


Miller Flat Quad

T10S, R26E, Sec 10

Application No. R-24554

Permit No. 85

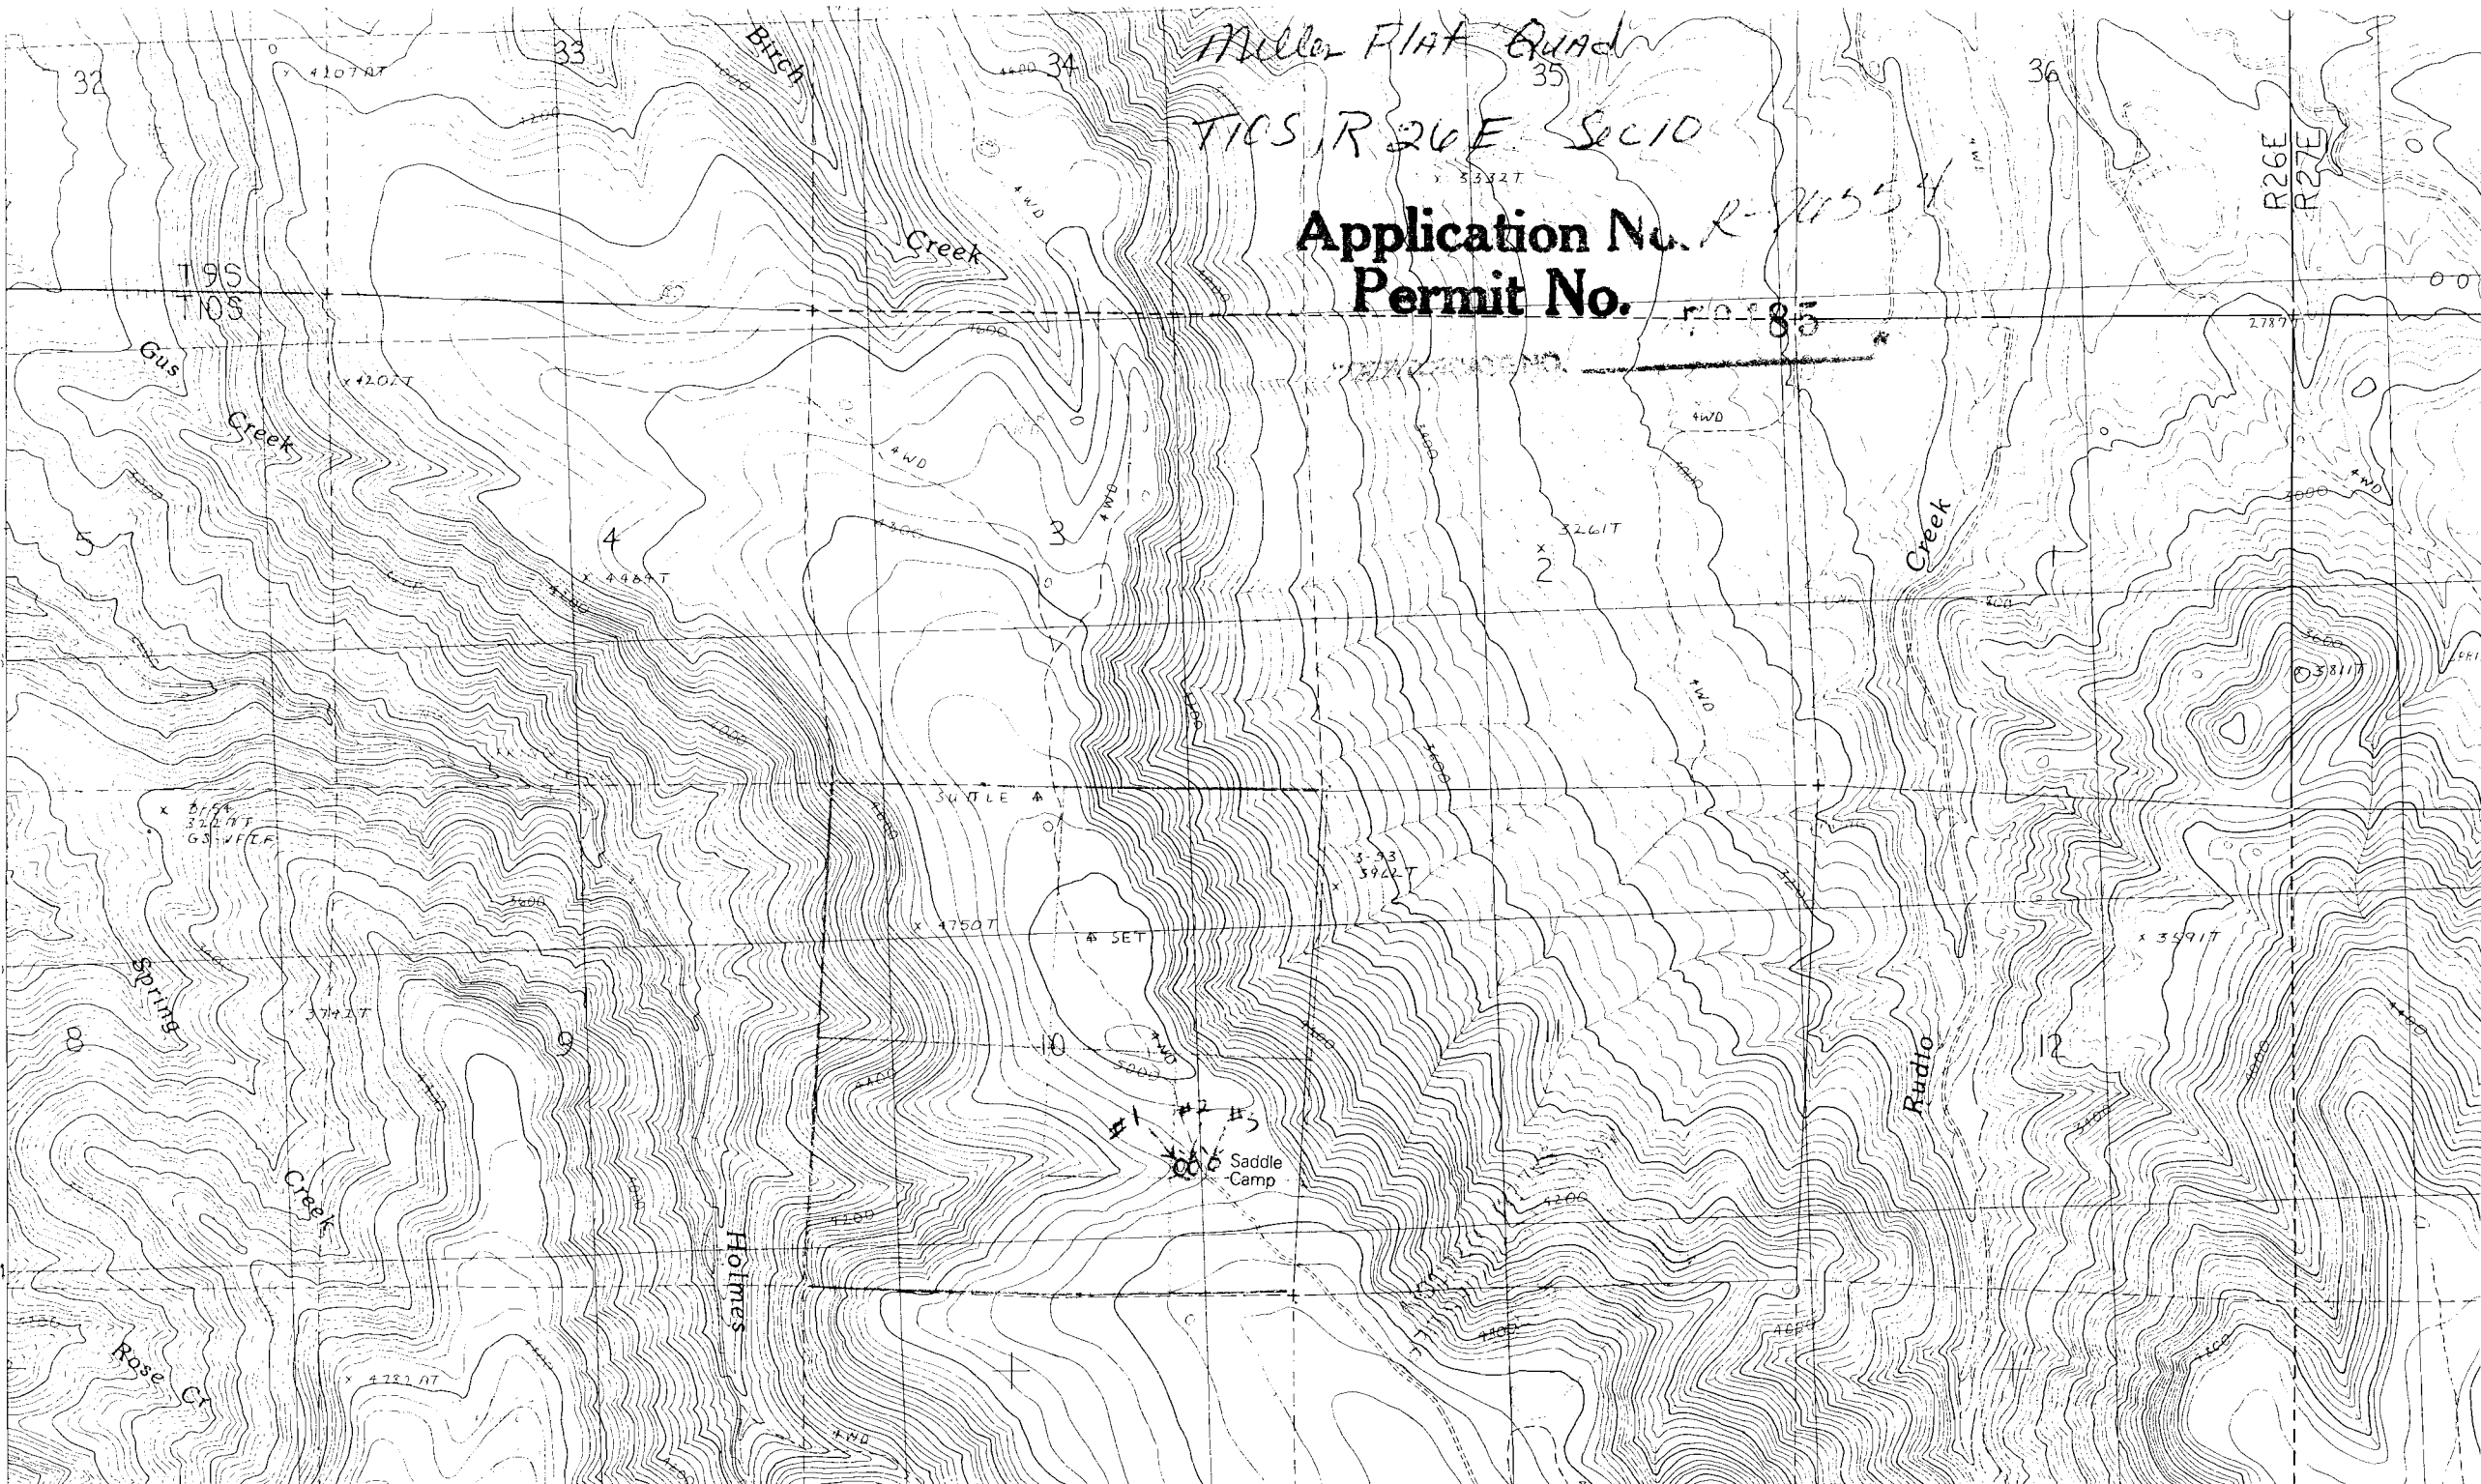

No Final Proof Map available

No Permit Map available