


Application No.
Permit No.


Received Jan 3 1945

by Michael H. [unclear]

WATER RESOURCES DIV.
SALEM, OREGON

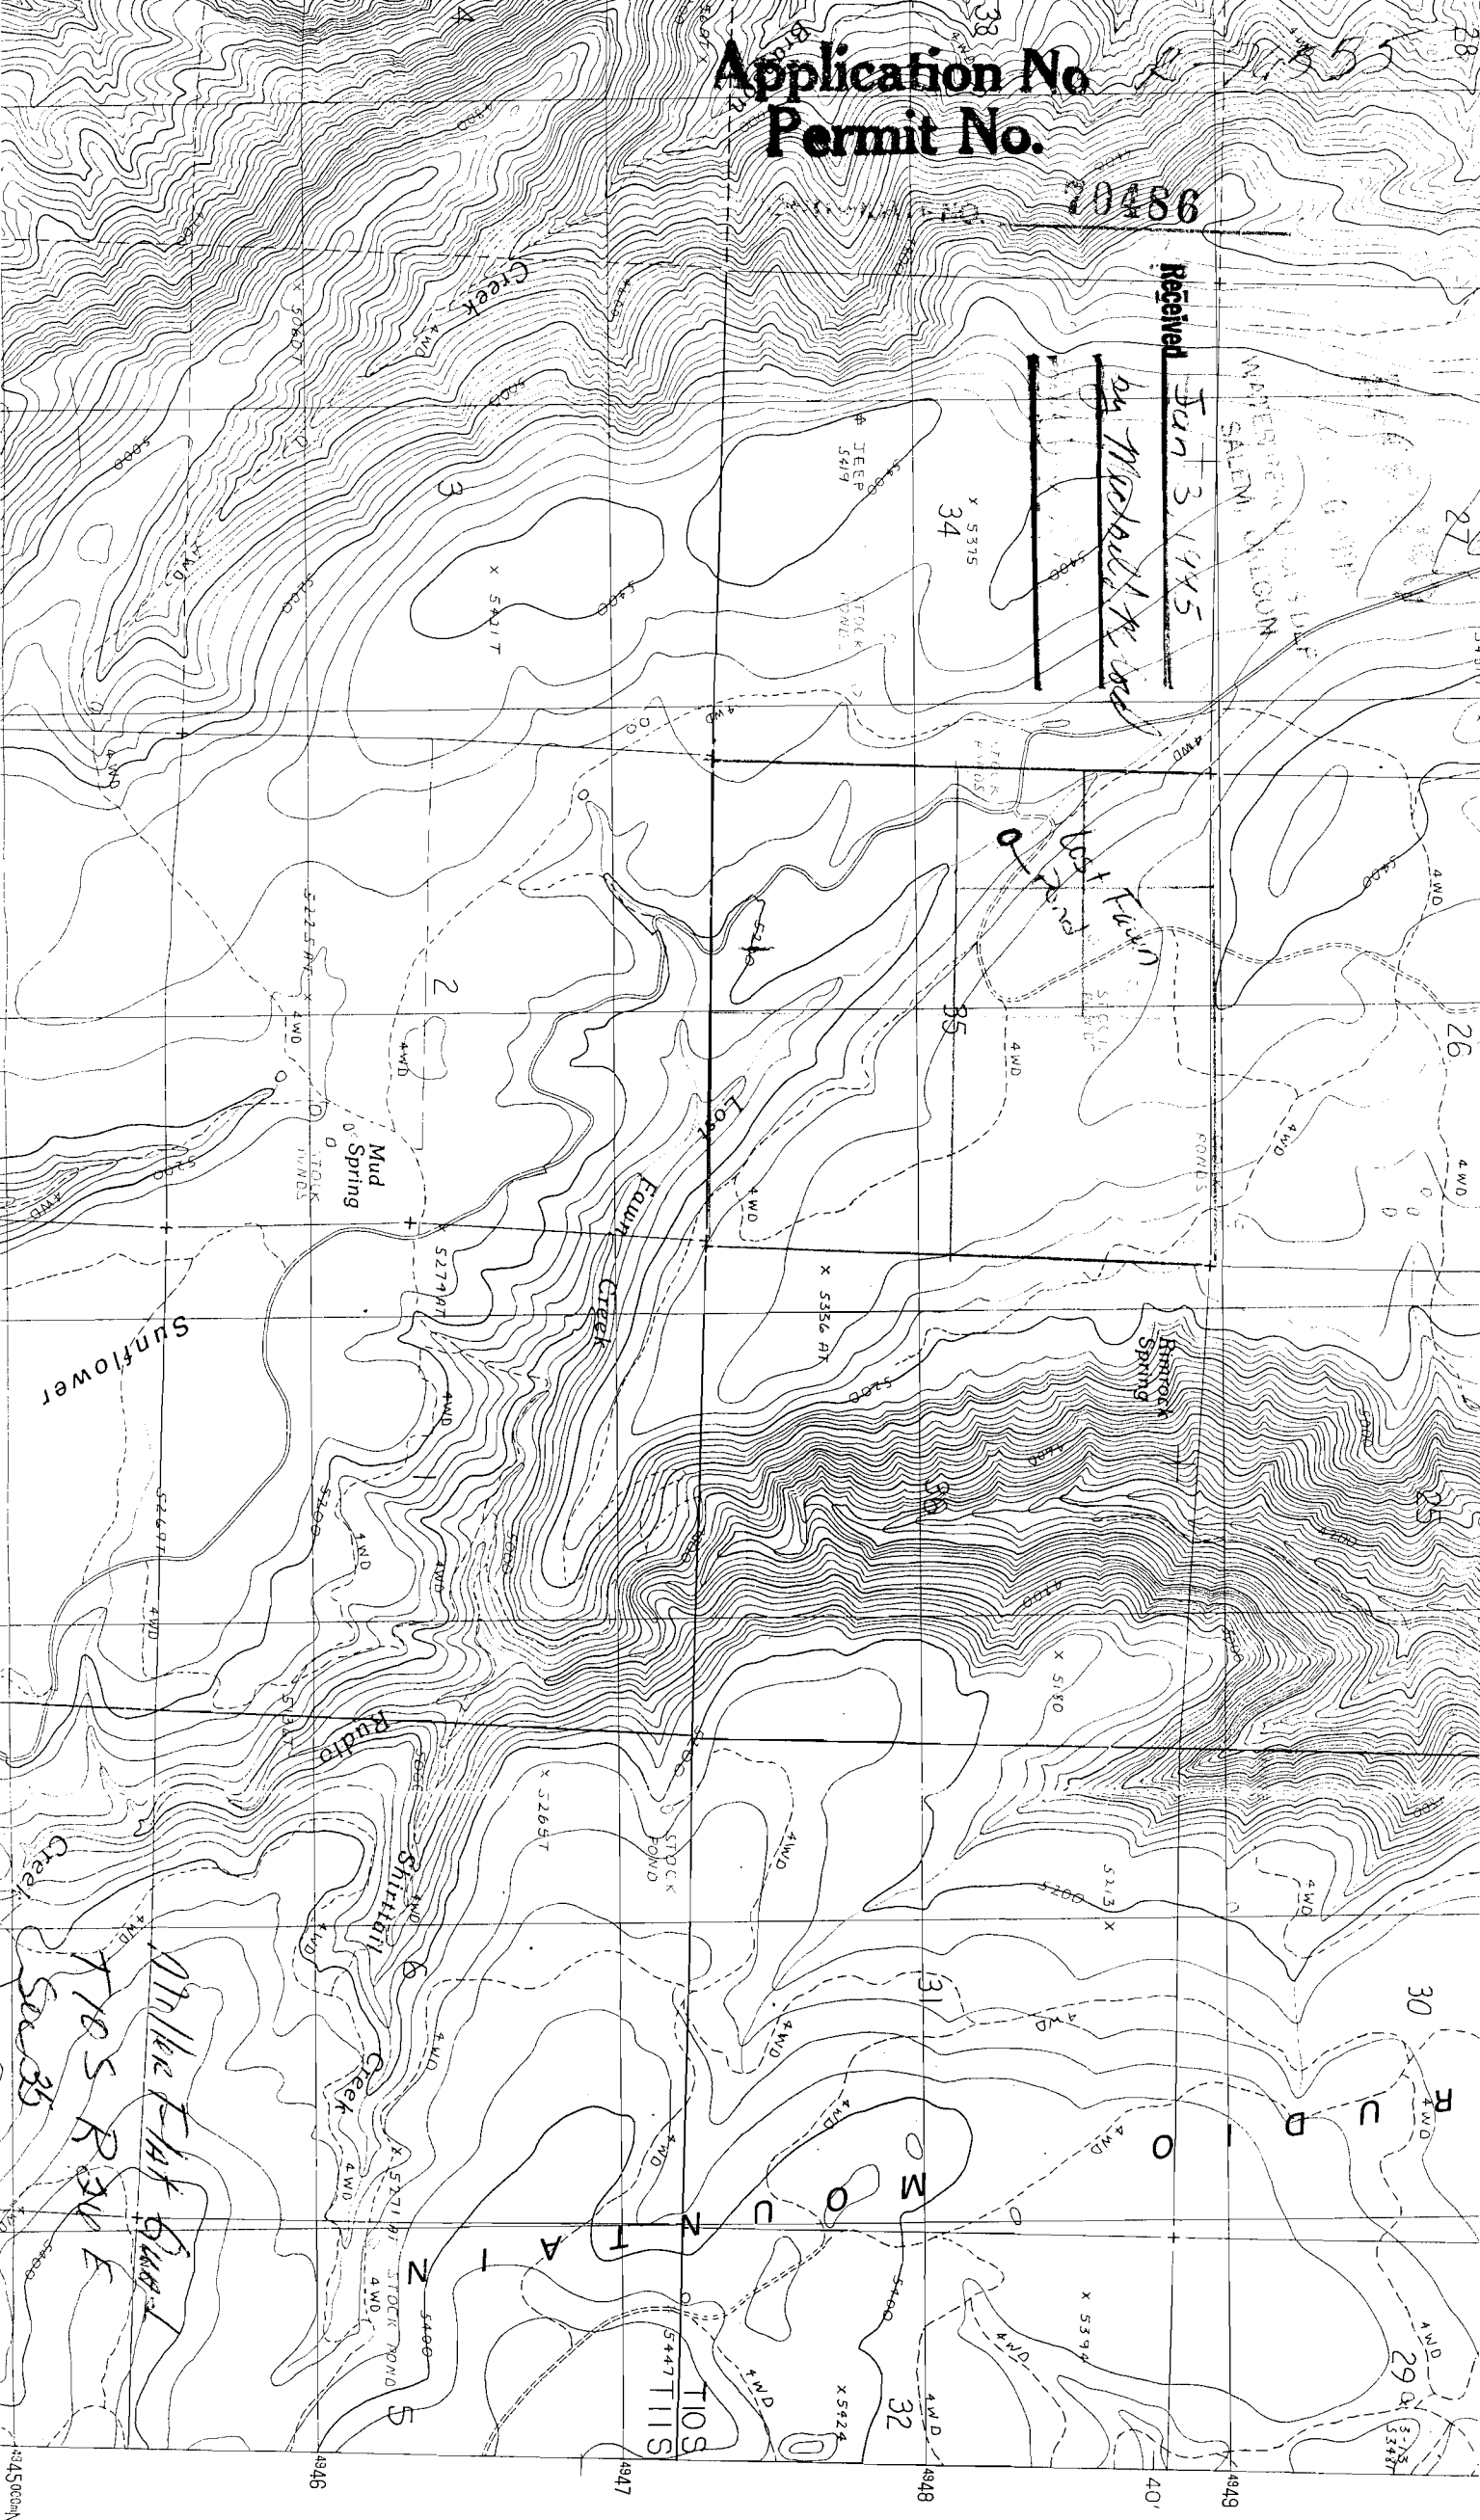

See 35

No Final Proof available

No Permit Map available