

R34E
R35E

R35E
R36E


T23S
T24S

T24S
T25S

T25S

70490

Application No.
Permit No.

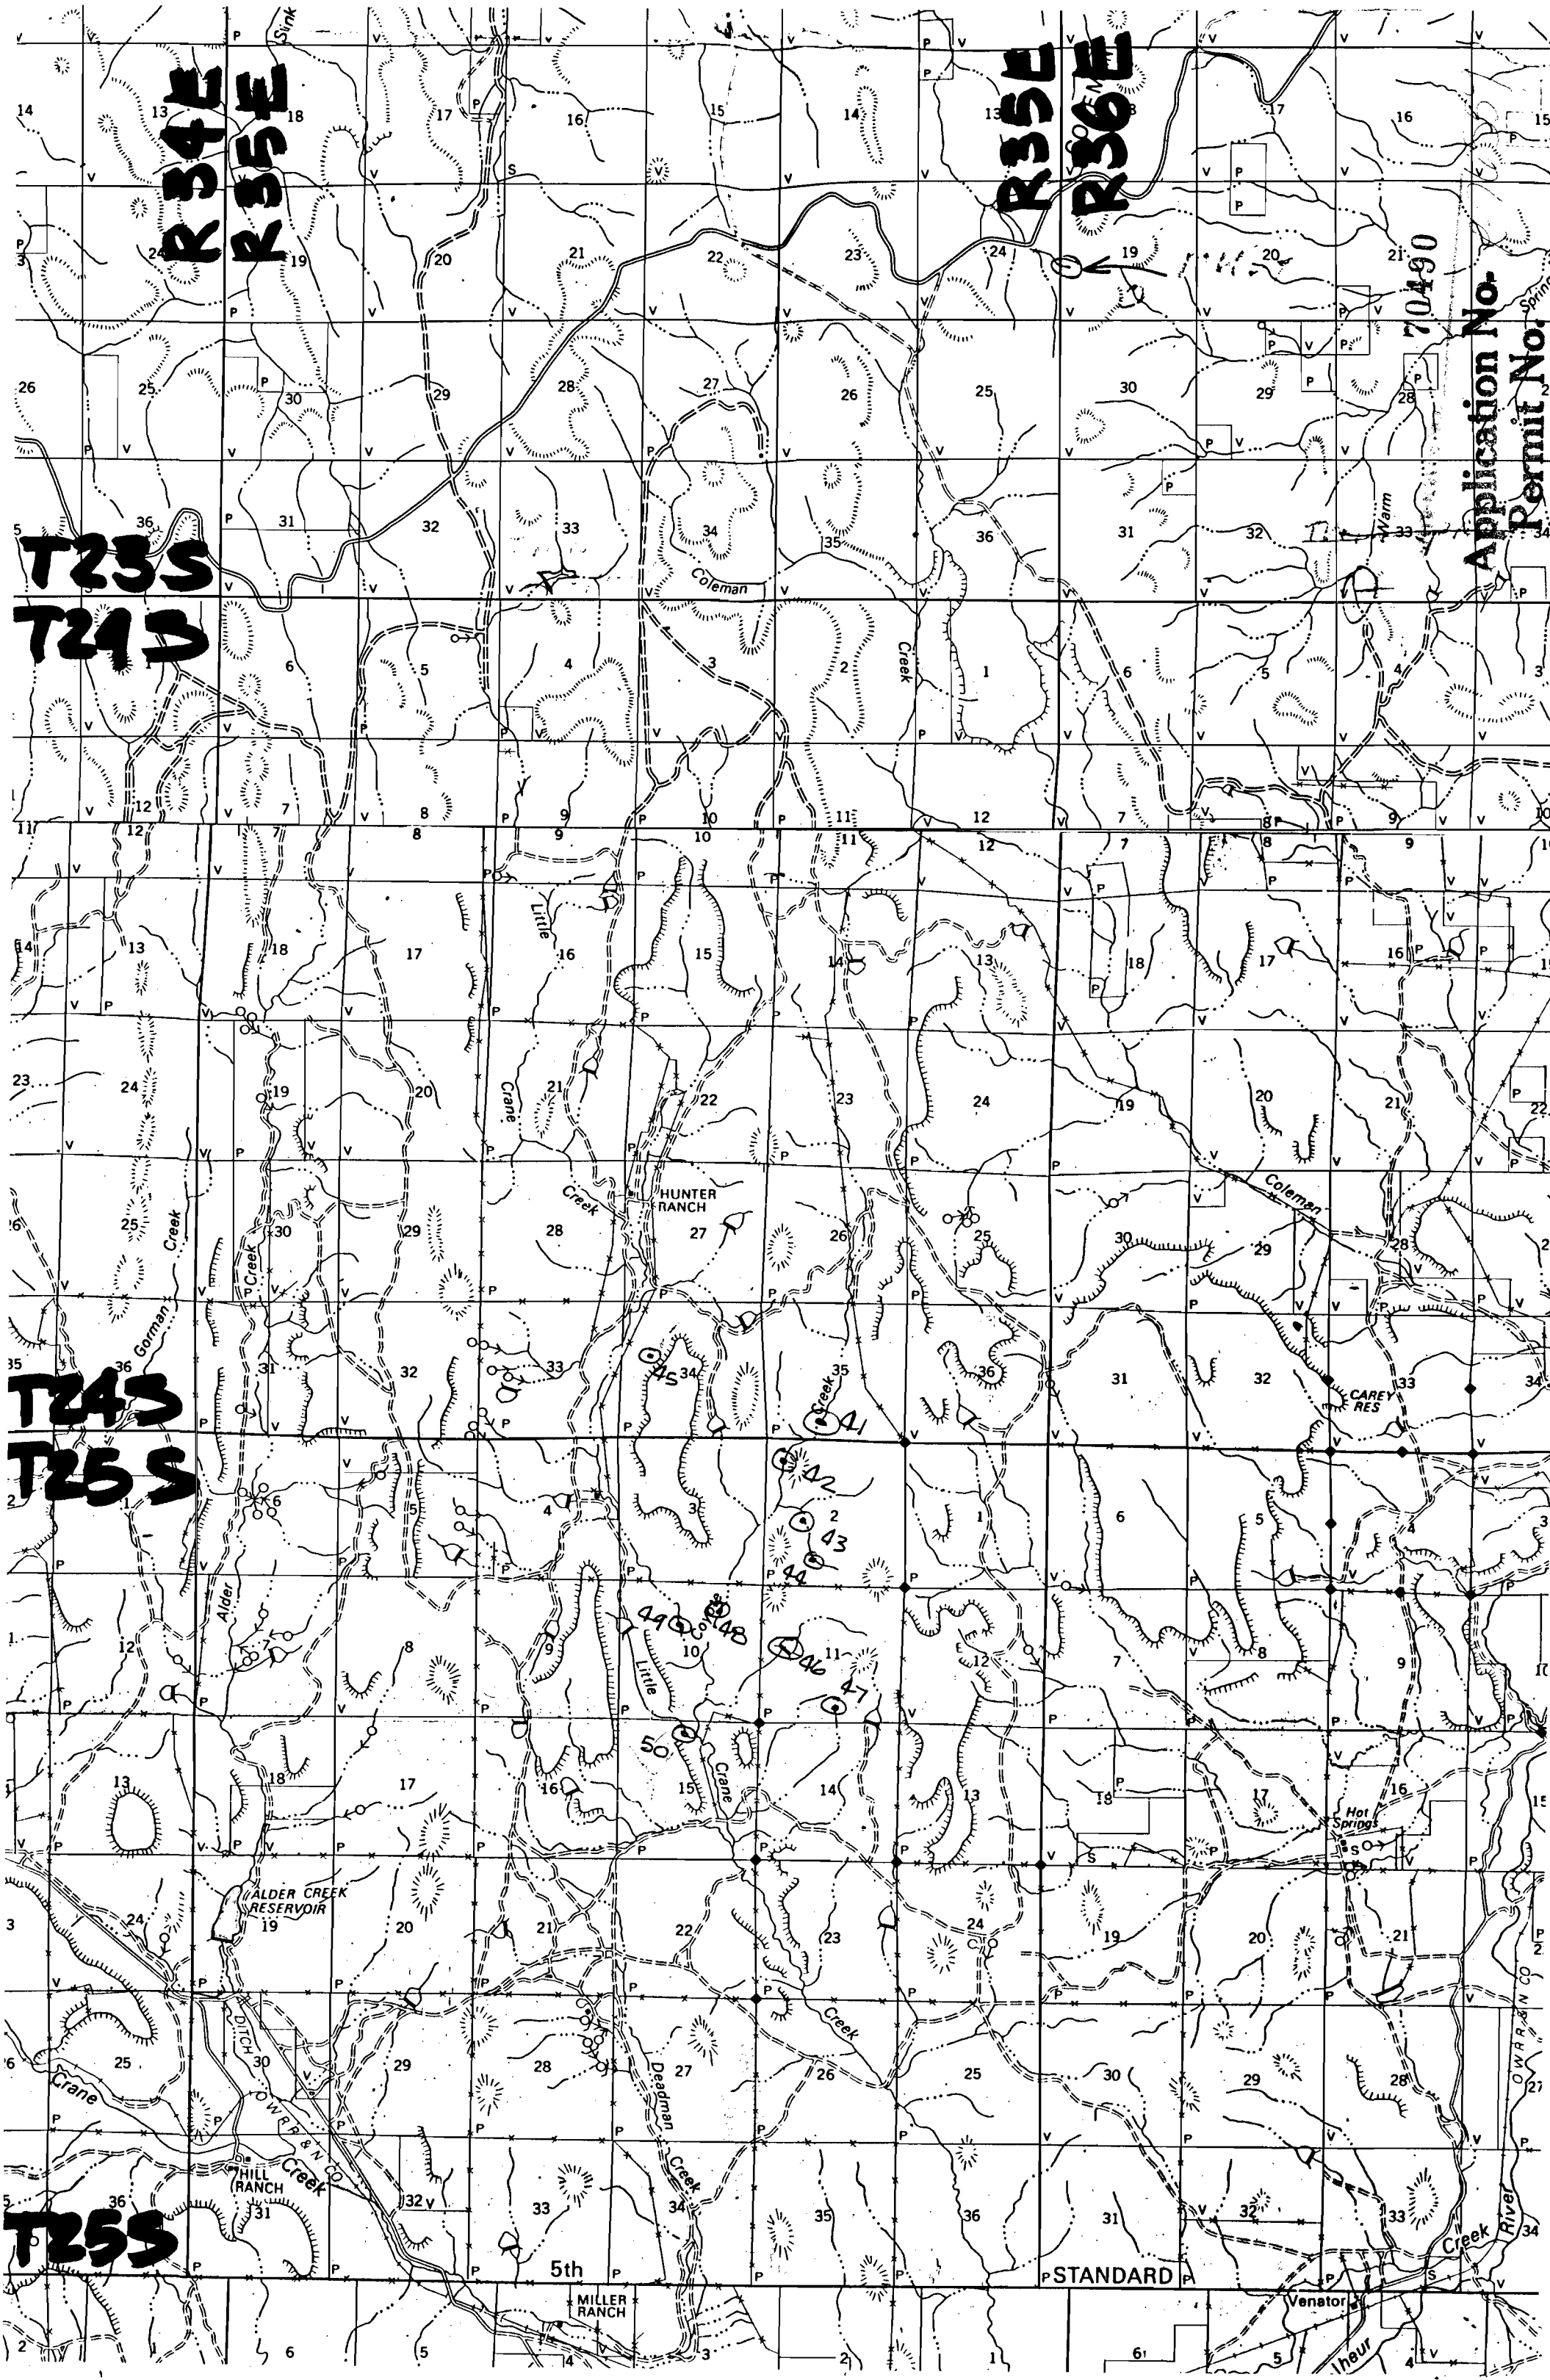

No Final Proof Map available

No Permit Map available