


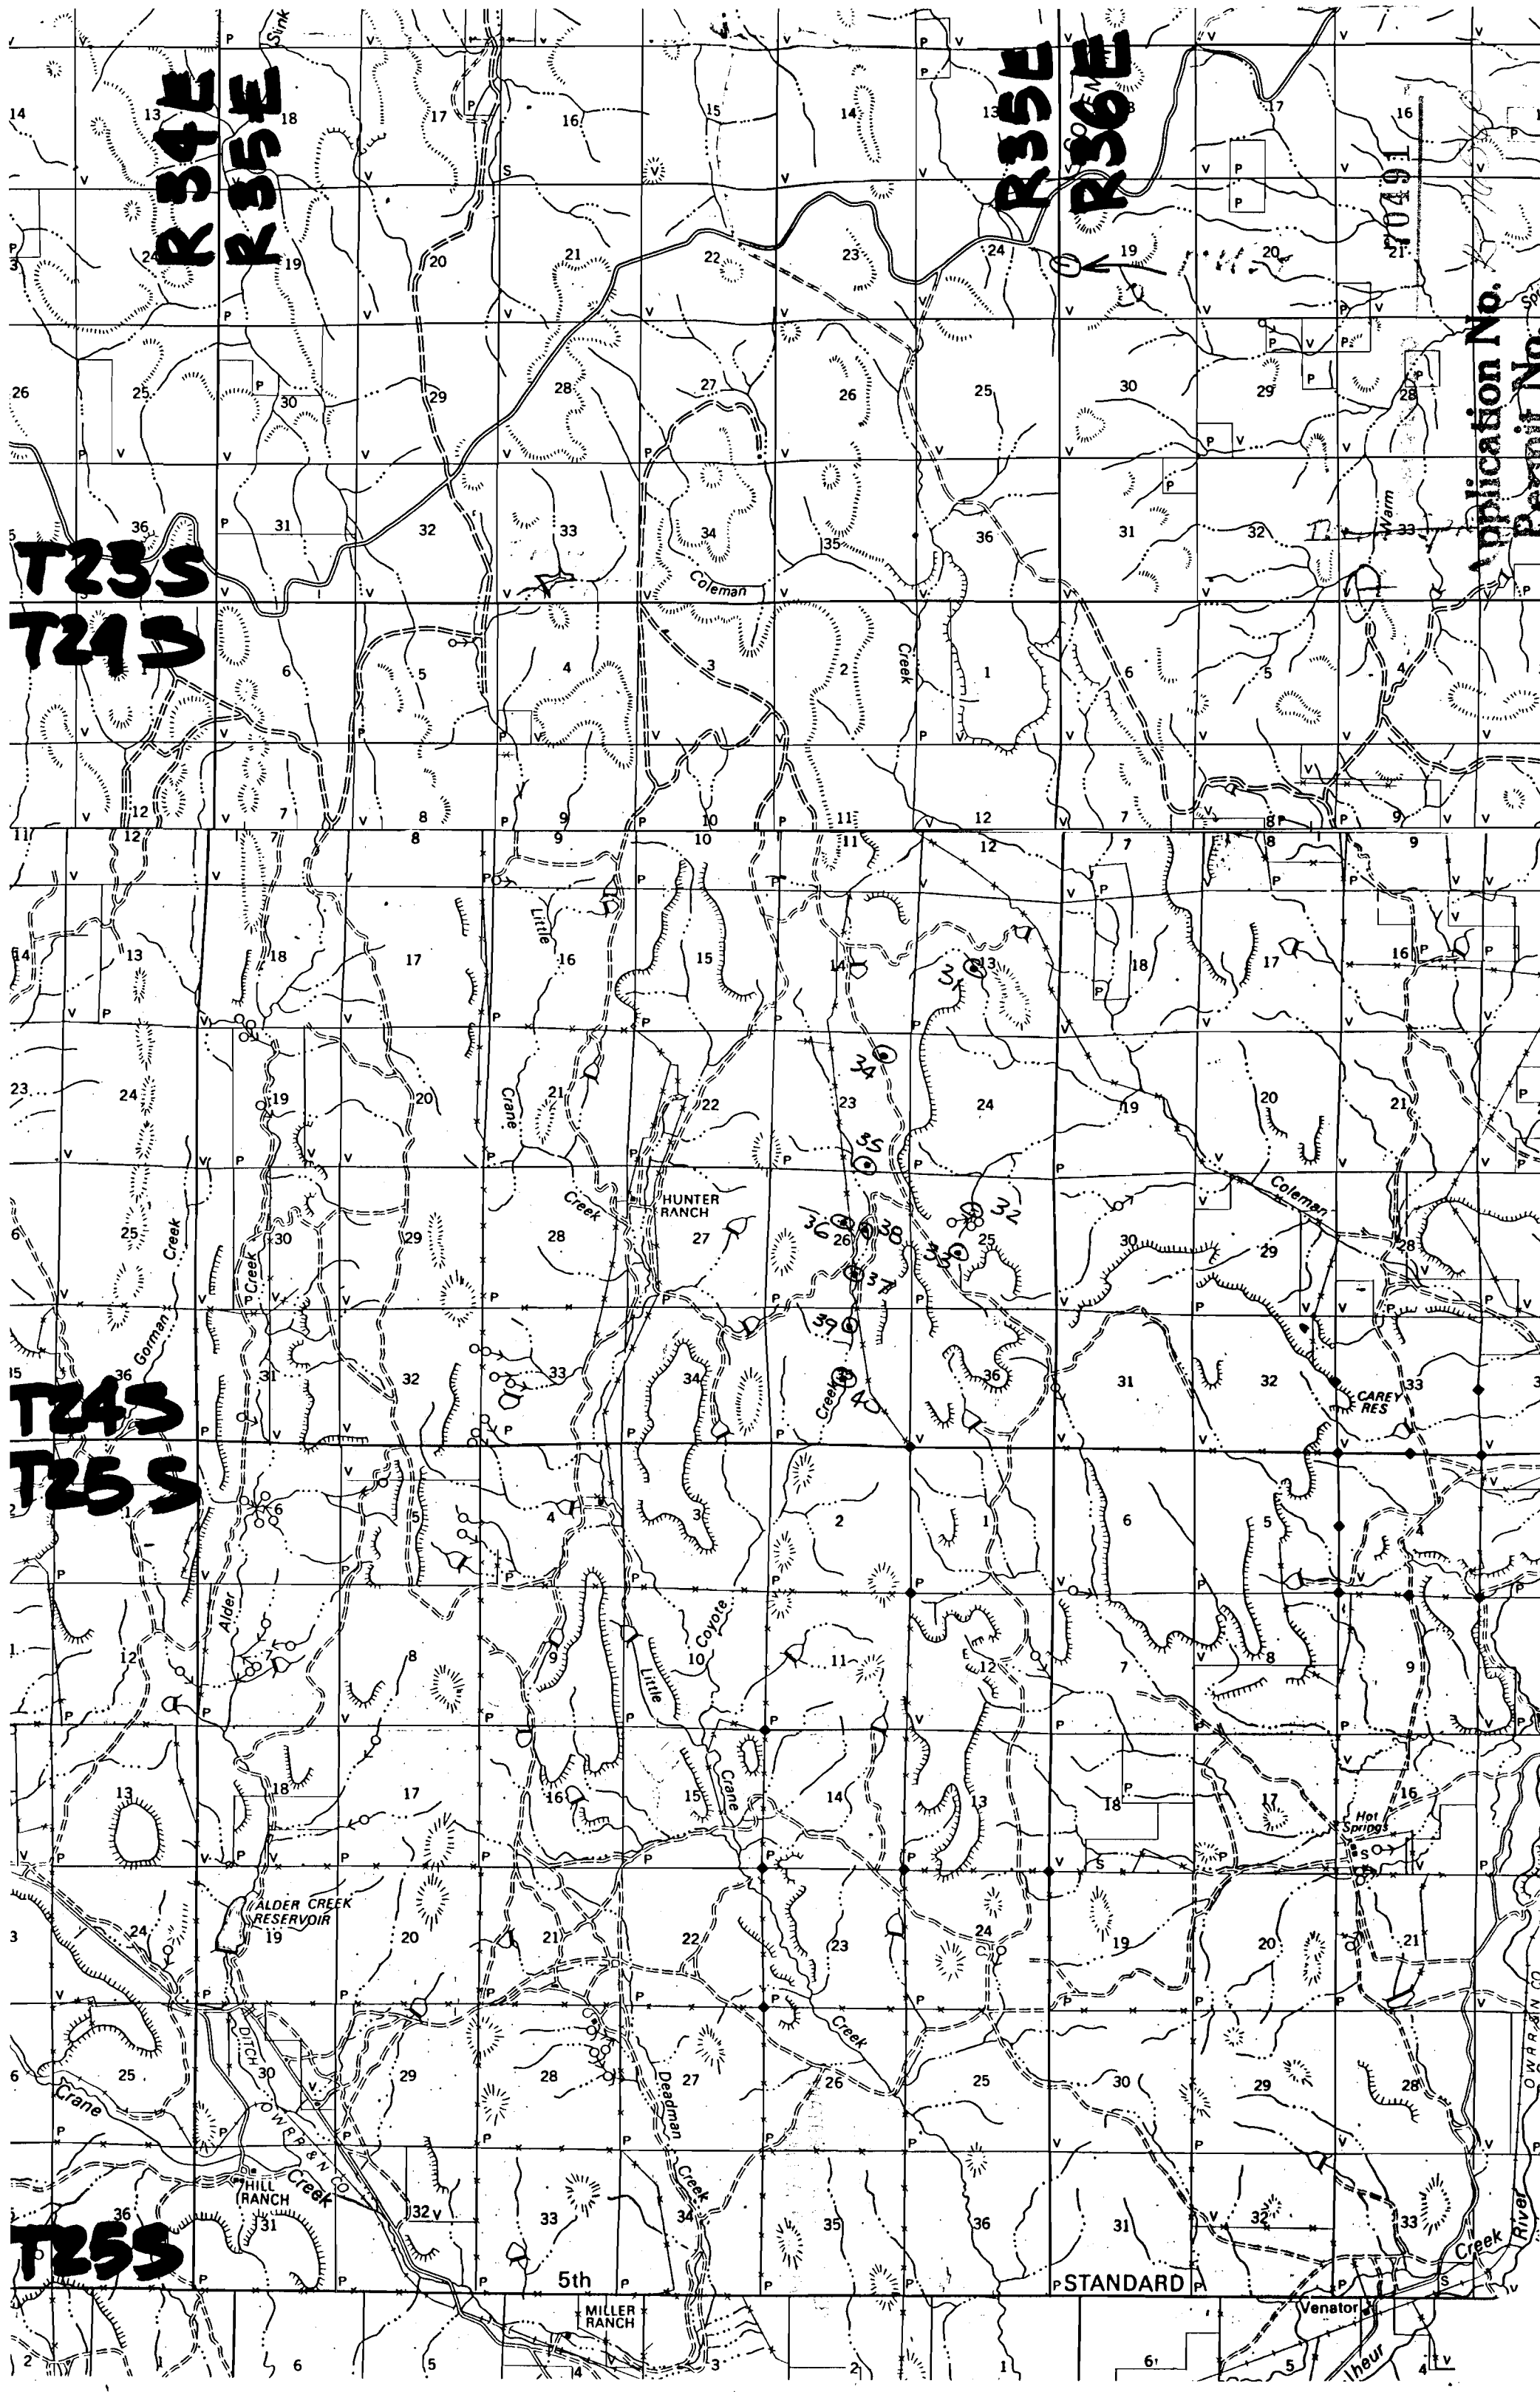

R34E
R35E

R35E
R36E

T0491

Application No.
Permit No.

T23S
T24S

T24S
T25S

T25S

5th

STANDARD

OWRR & N CO

No Final Proof Map available

No Permit Map available