


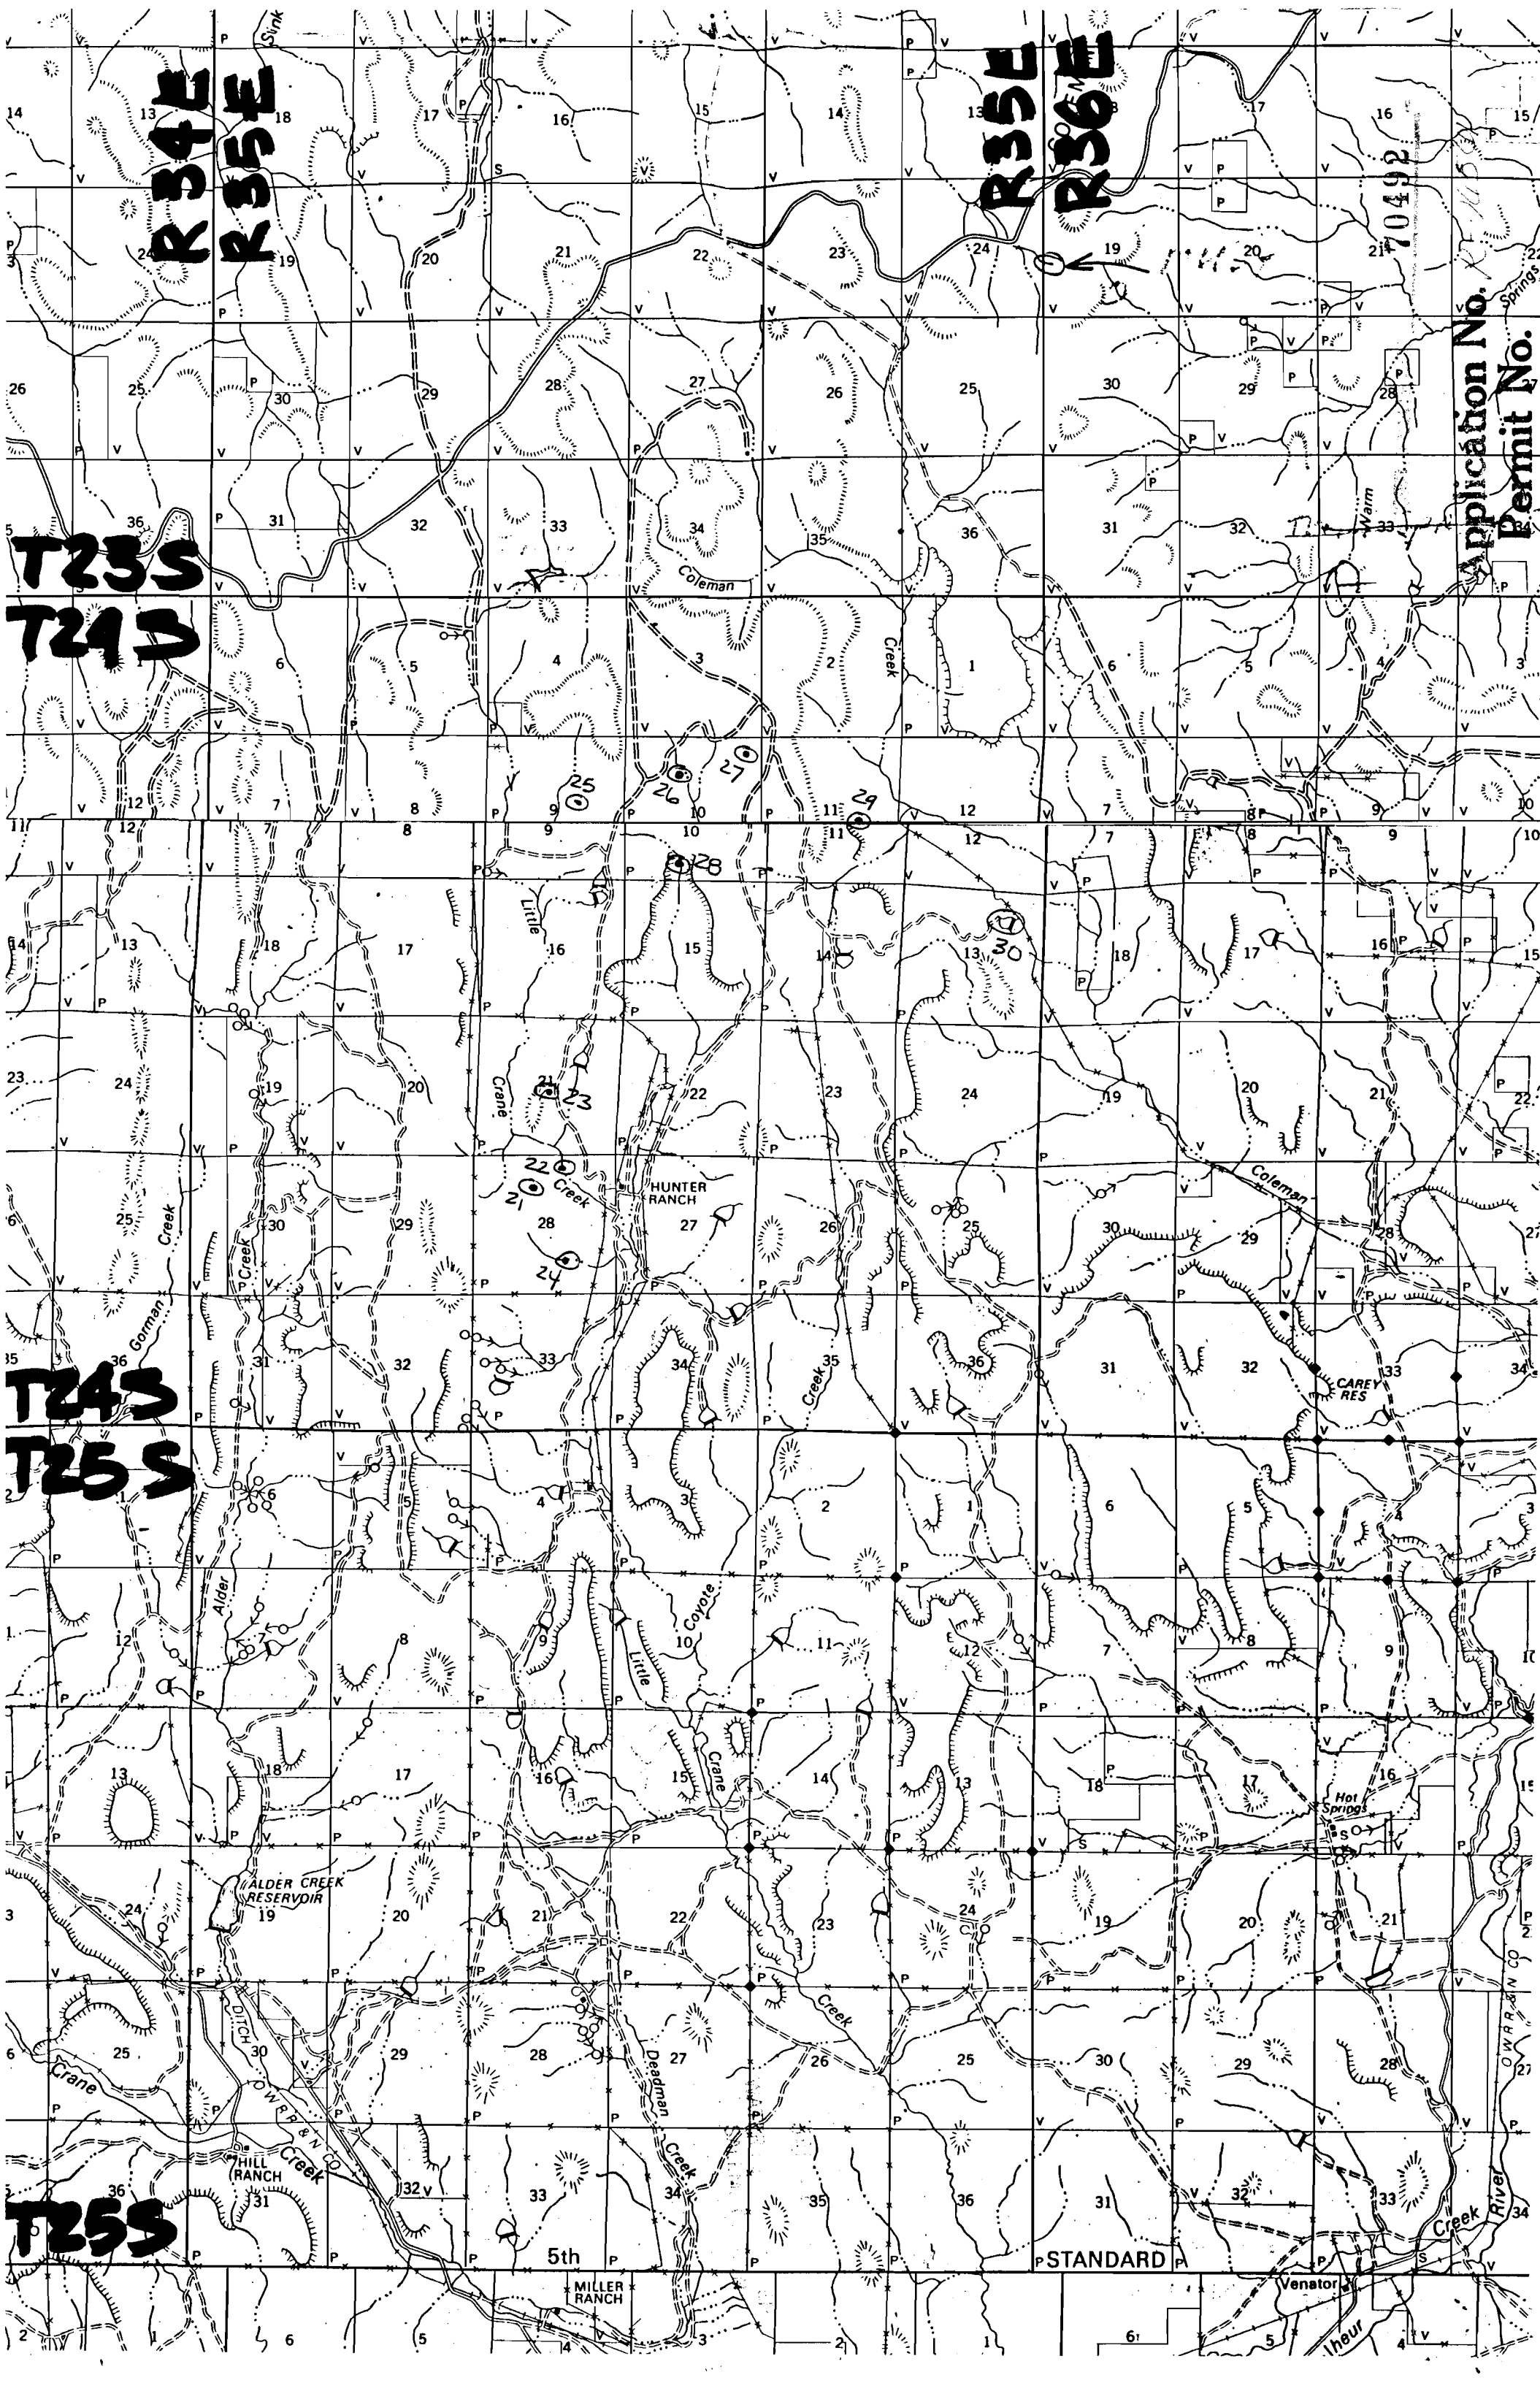

Permit No.

OWRR & N CO
27

Creek River

70492

R35E
R36E

R34E
R35E

T23S
T24S

T24S
T25S

T25S

ALDER CREEK
RESERVOIR

HILL RANCH

MILLER RANCH

Hot Springs

CAREY RES

HUNTER RANCH

Venator

STANDARD

5th

OWRR & N CO

Alder Creek

Crane Creek


Crane Creek






No Final Proof Map available

No Permit Map available