

R34E
R35E

R35E
R36E


70494

Application No.

T23S
T24S

T24S
T25S

R25S

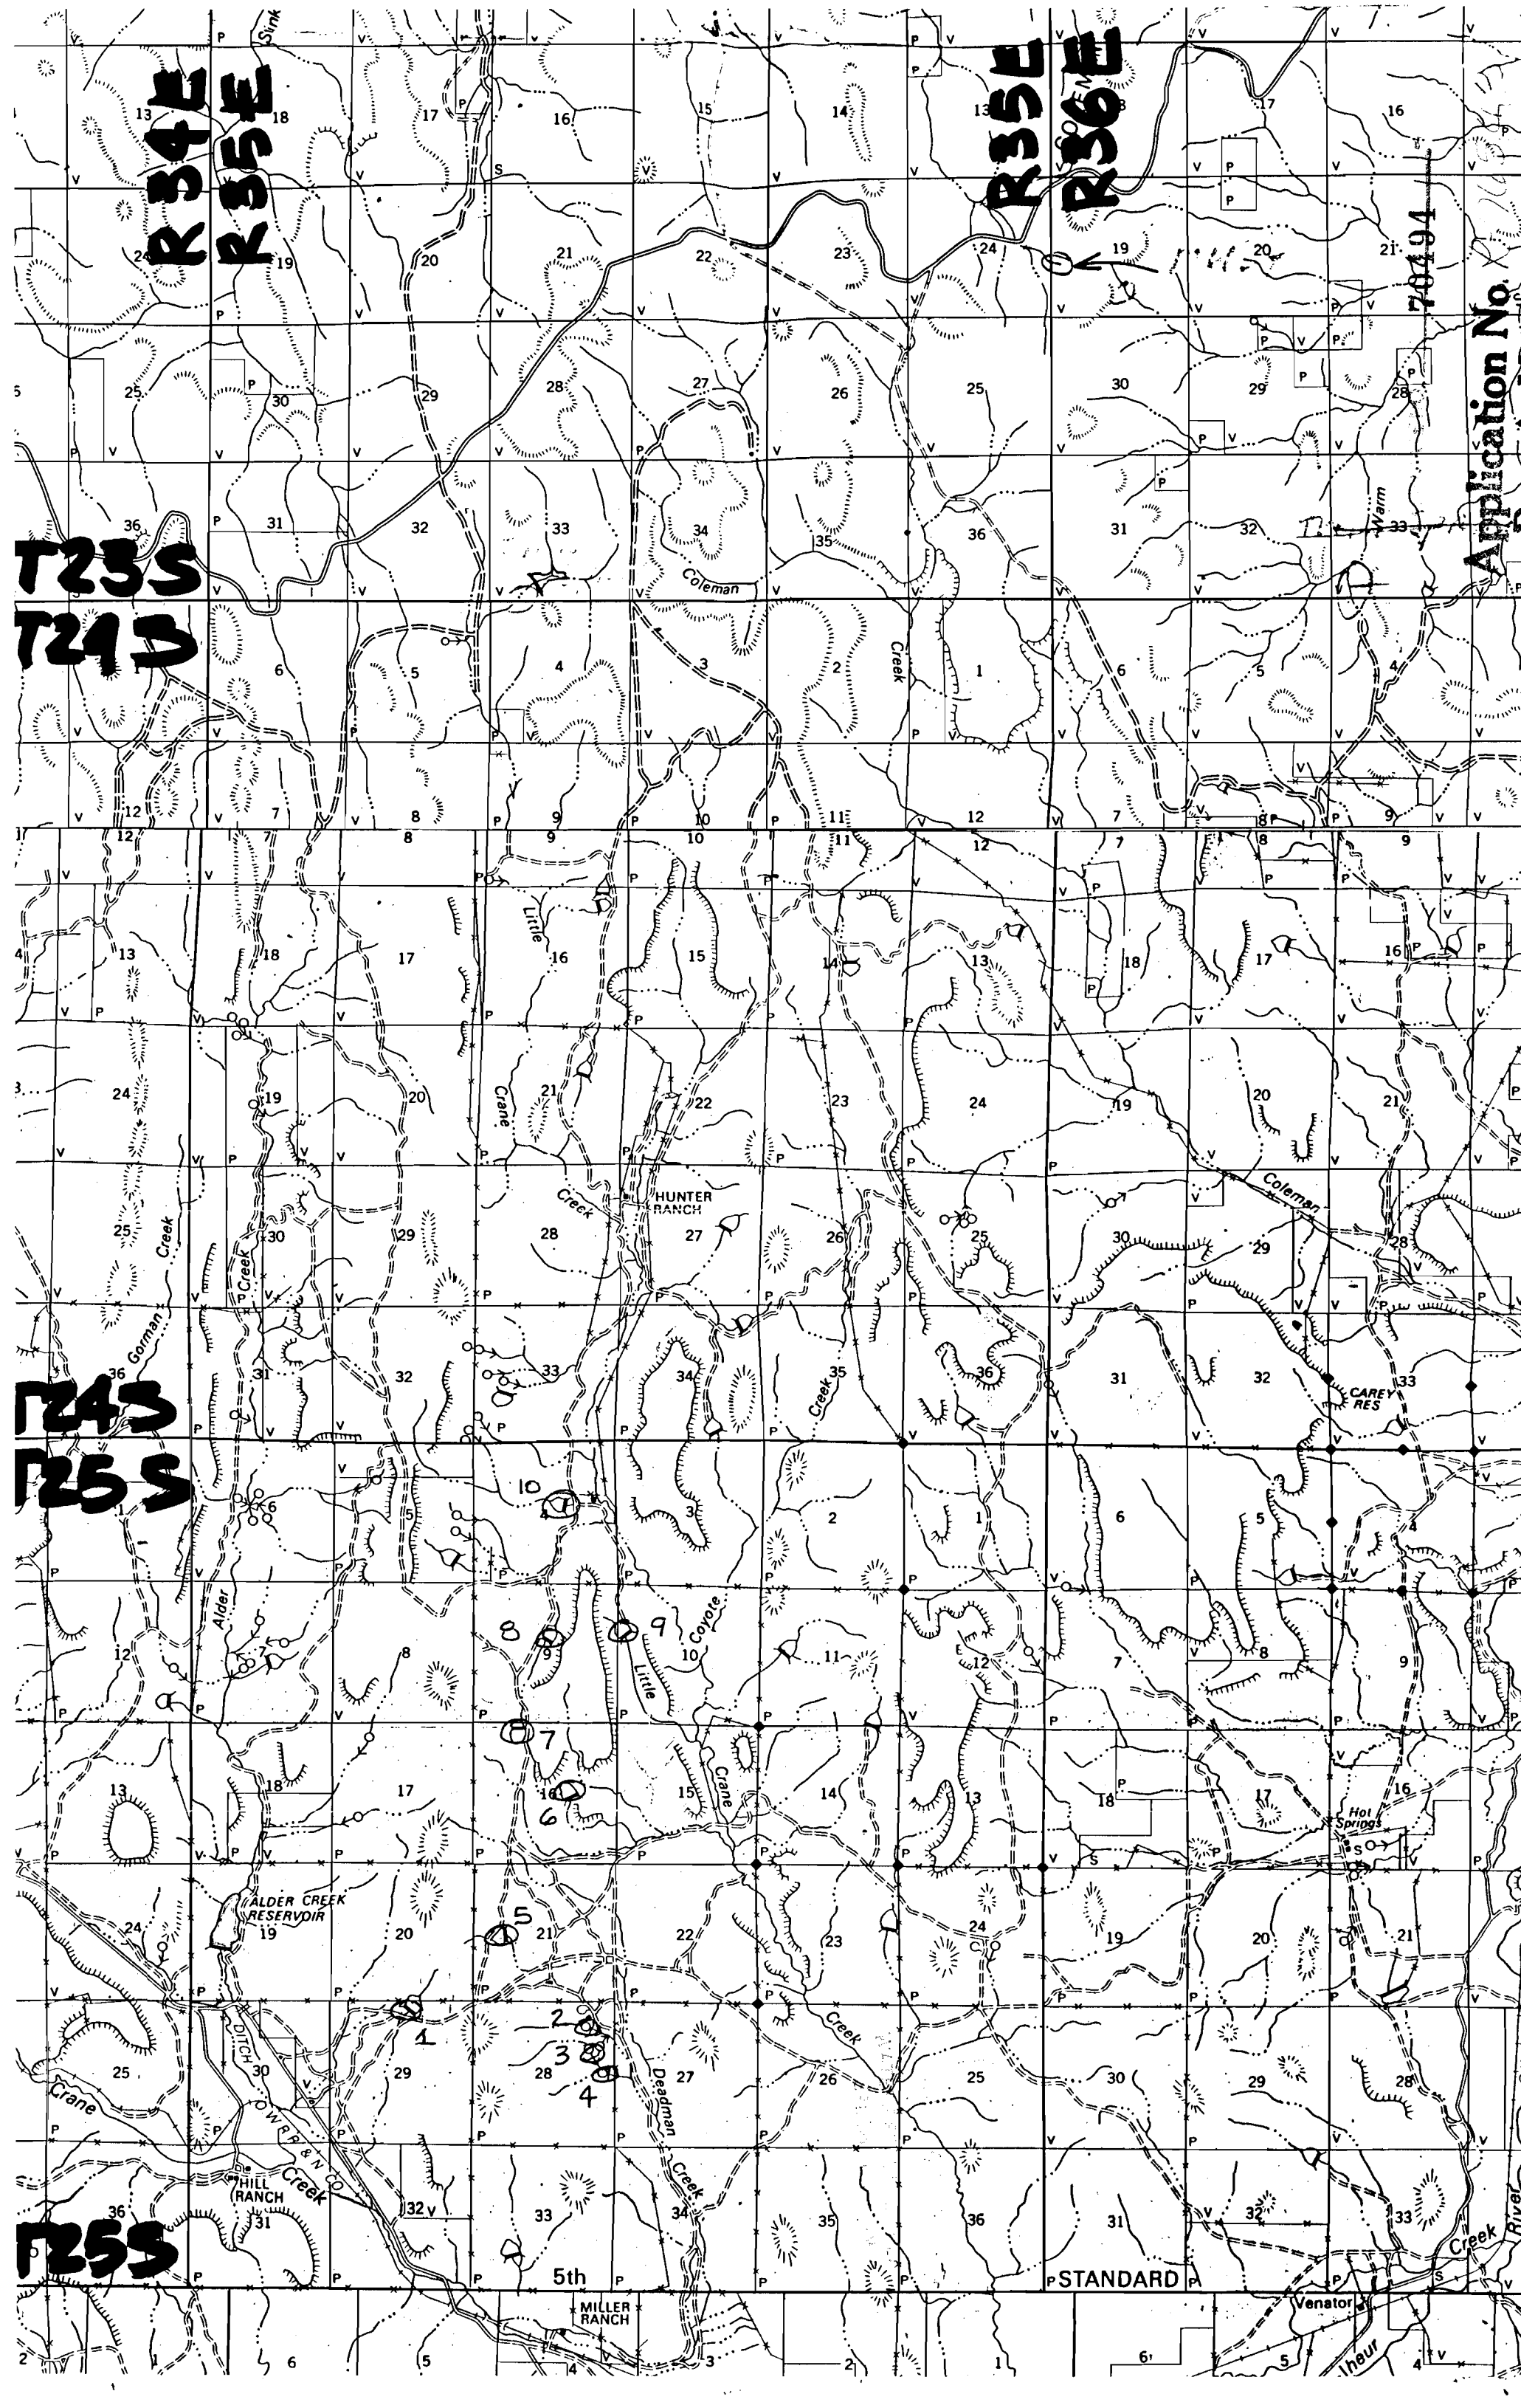

No Final Proof Map available

No Permit Map available