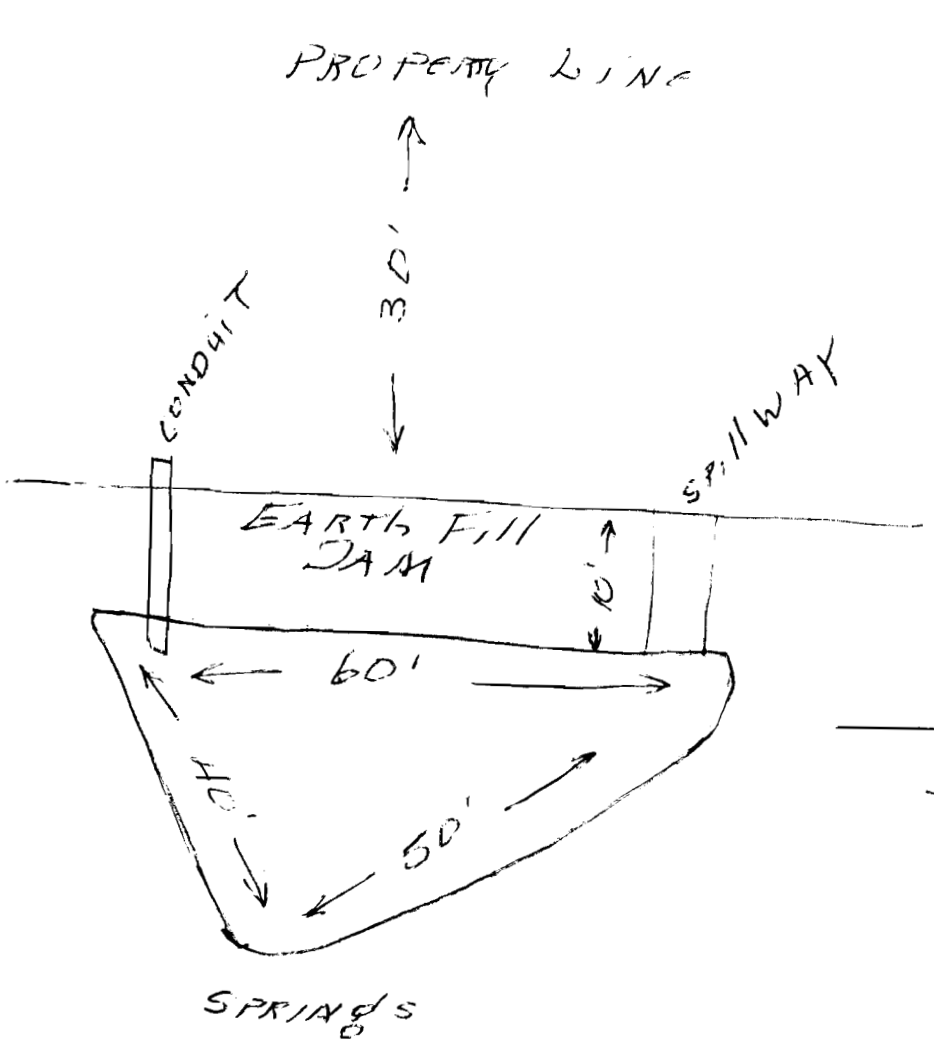

RECEIVED
DEC 21 1994
WATER RESOURCES DEPT.
SALEM, OREGON

Application No. R-76564
Permit No.

RECEIVED
JAN 11 1995

Application No. R-76564
Permit No.

RECEIVED
JAN 11 1995
WATER RESOURCES
SALEM, OREGON

RECEIVED
DEC 21 1994
WATER RESOURCES DEPT.
SALEM, OREGON

ARED FOR

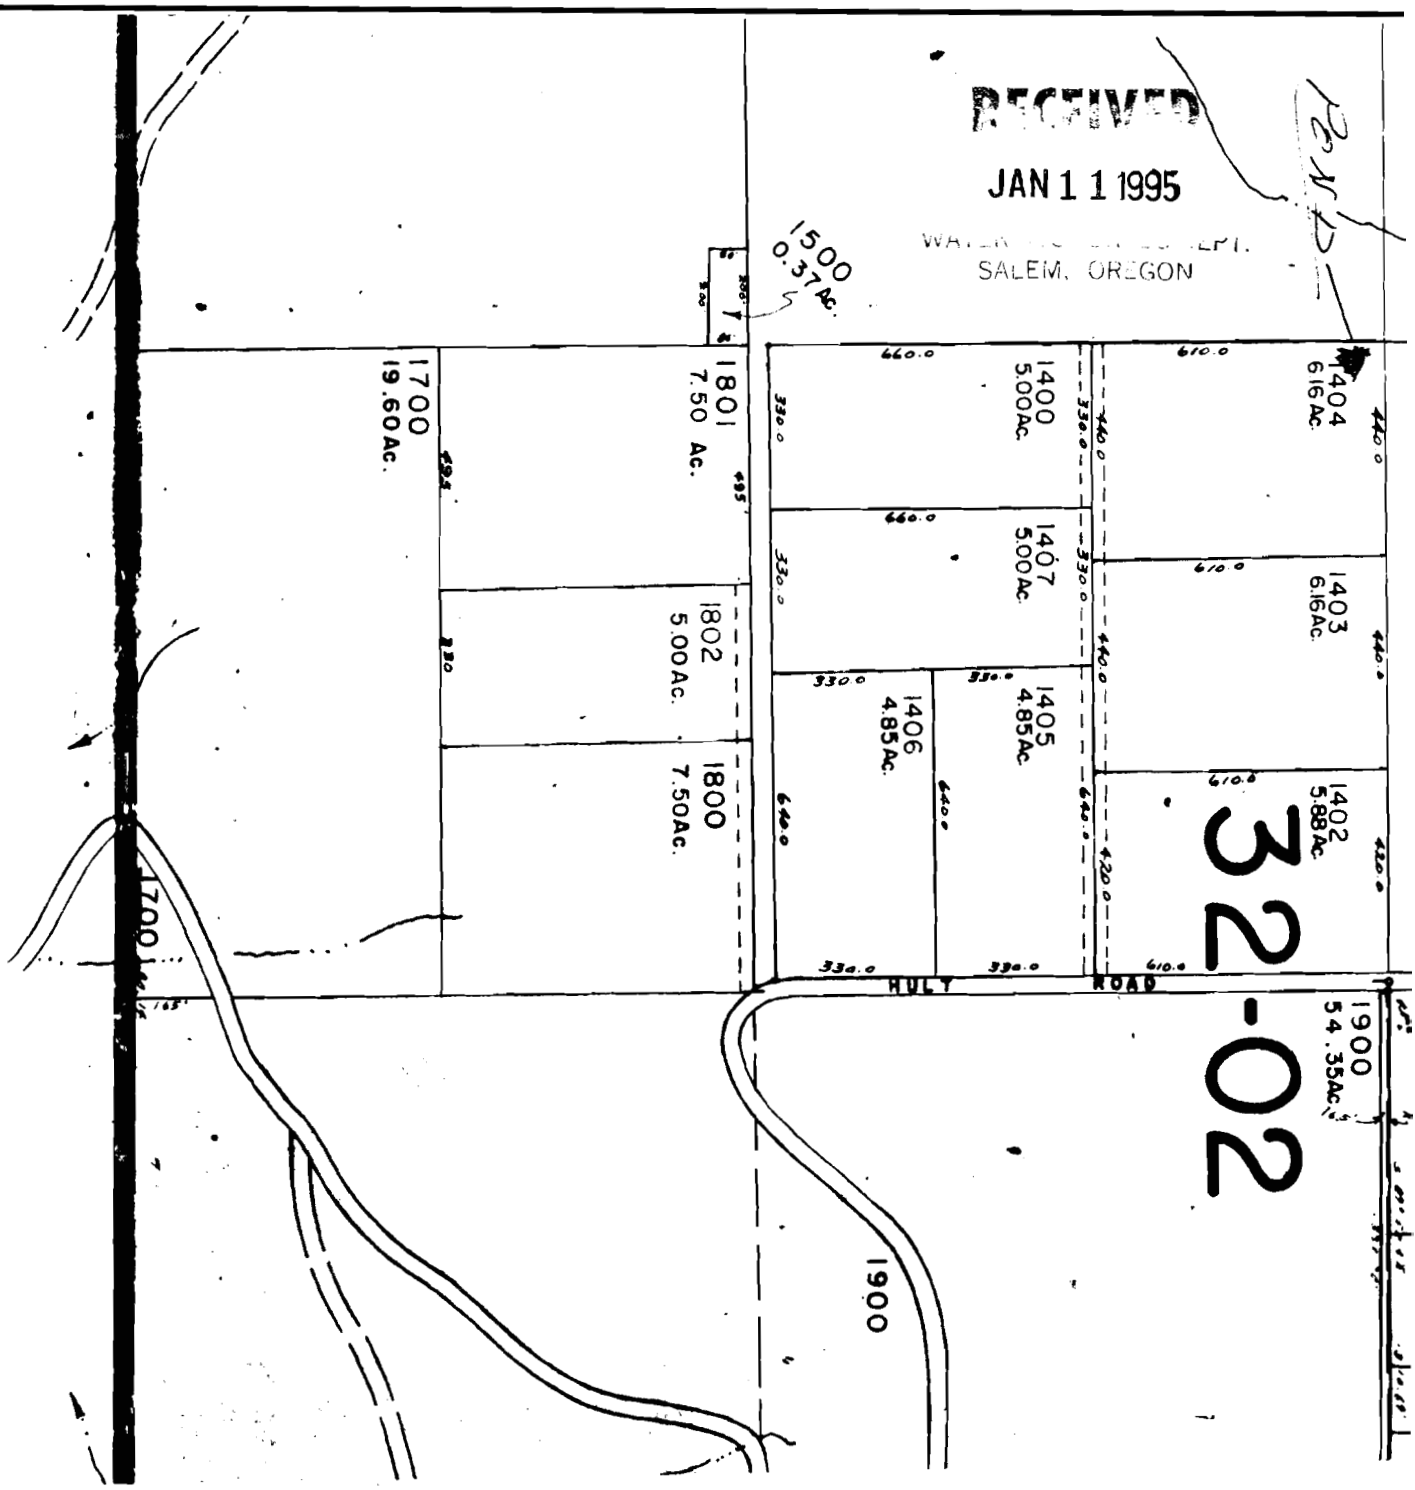

Application No. R-76504

Permit No. 70495

"CERTIFICATE NO. _____"

RECEIVED

DEC 2 1 1994

WATER RESOURCES DEPT.
SALEM, OREGON