
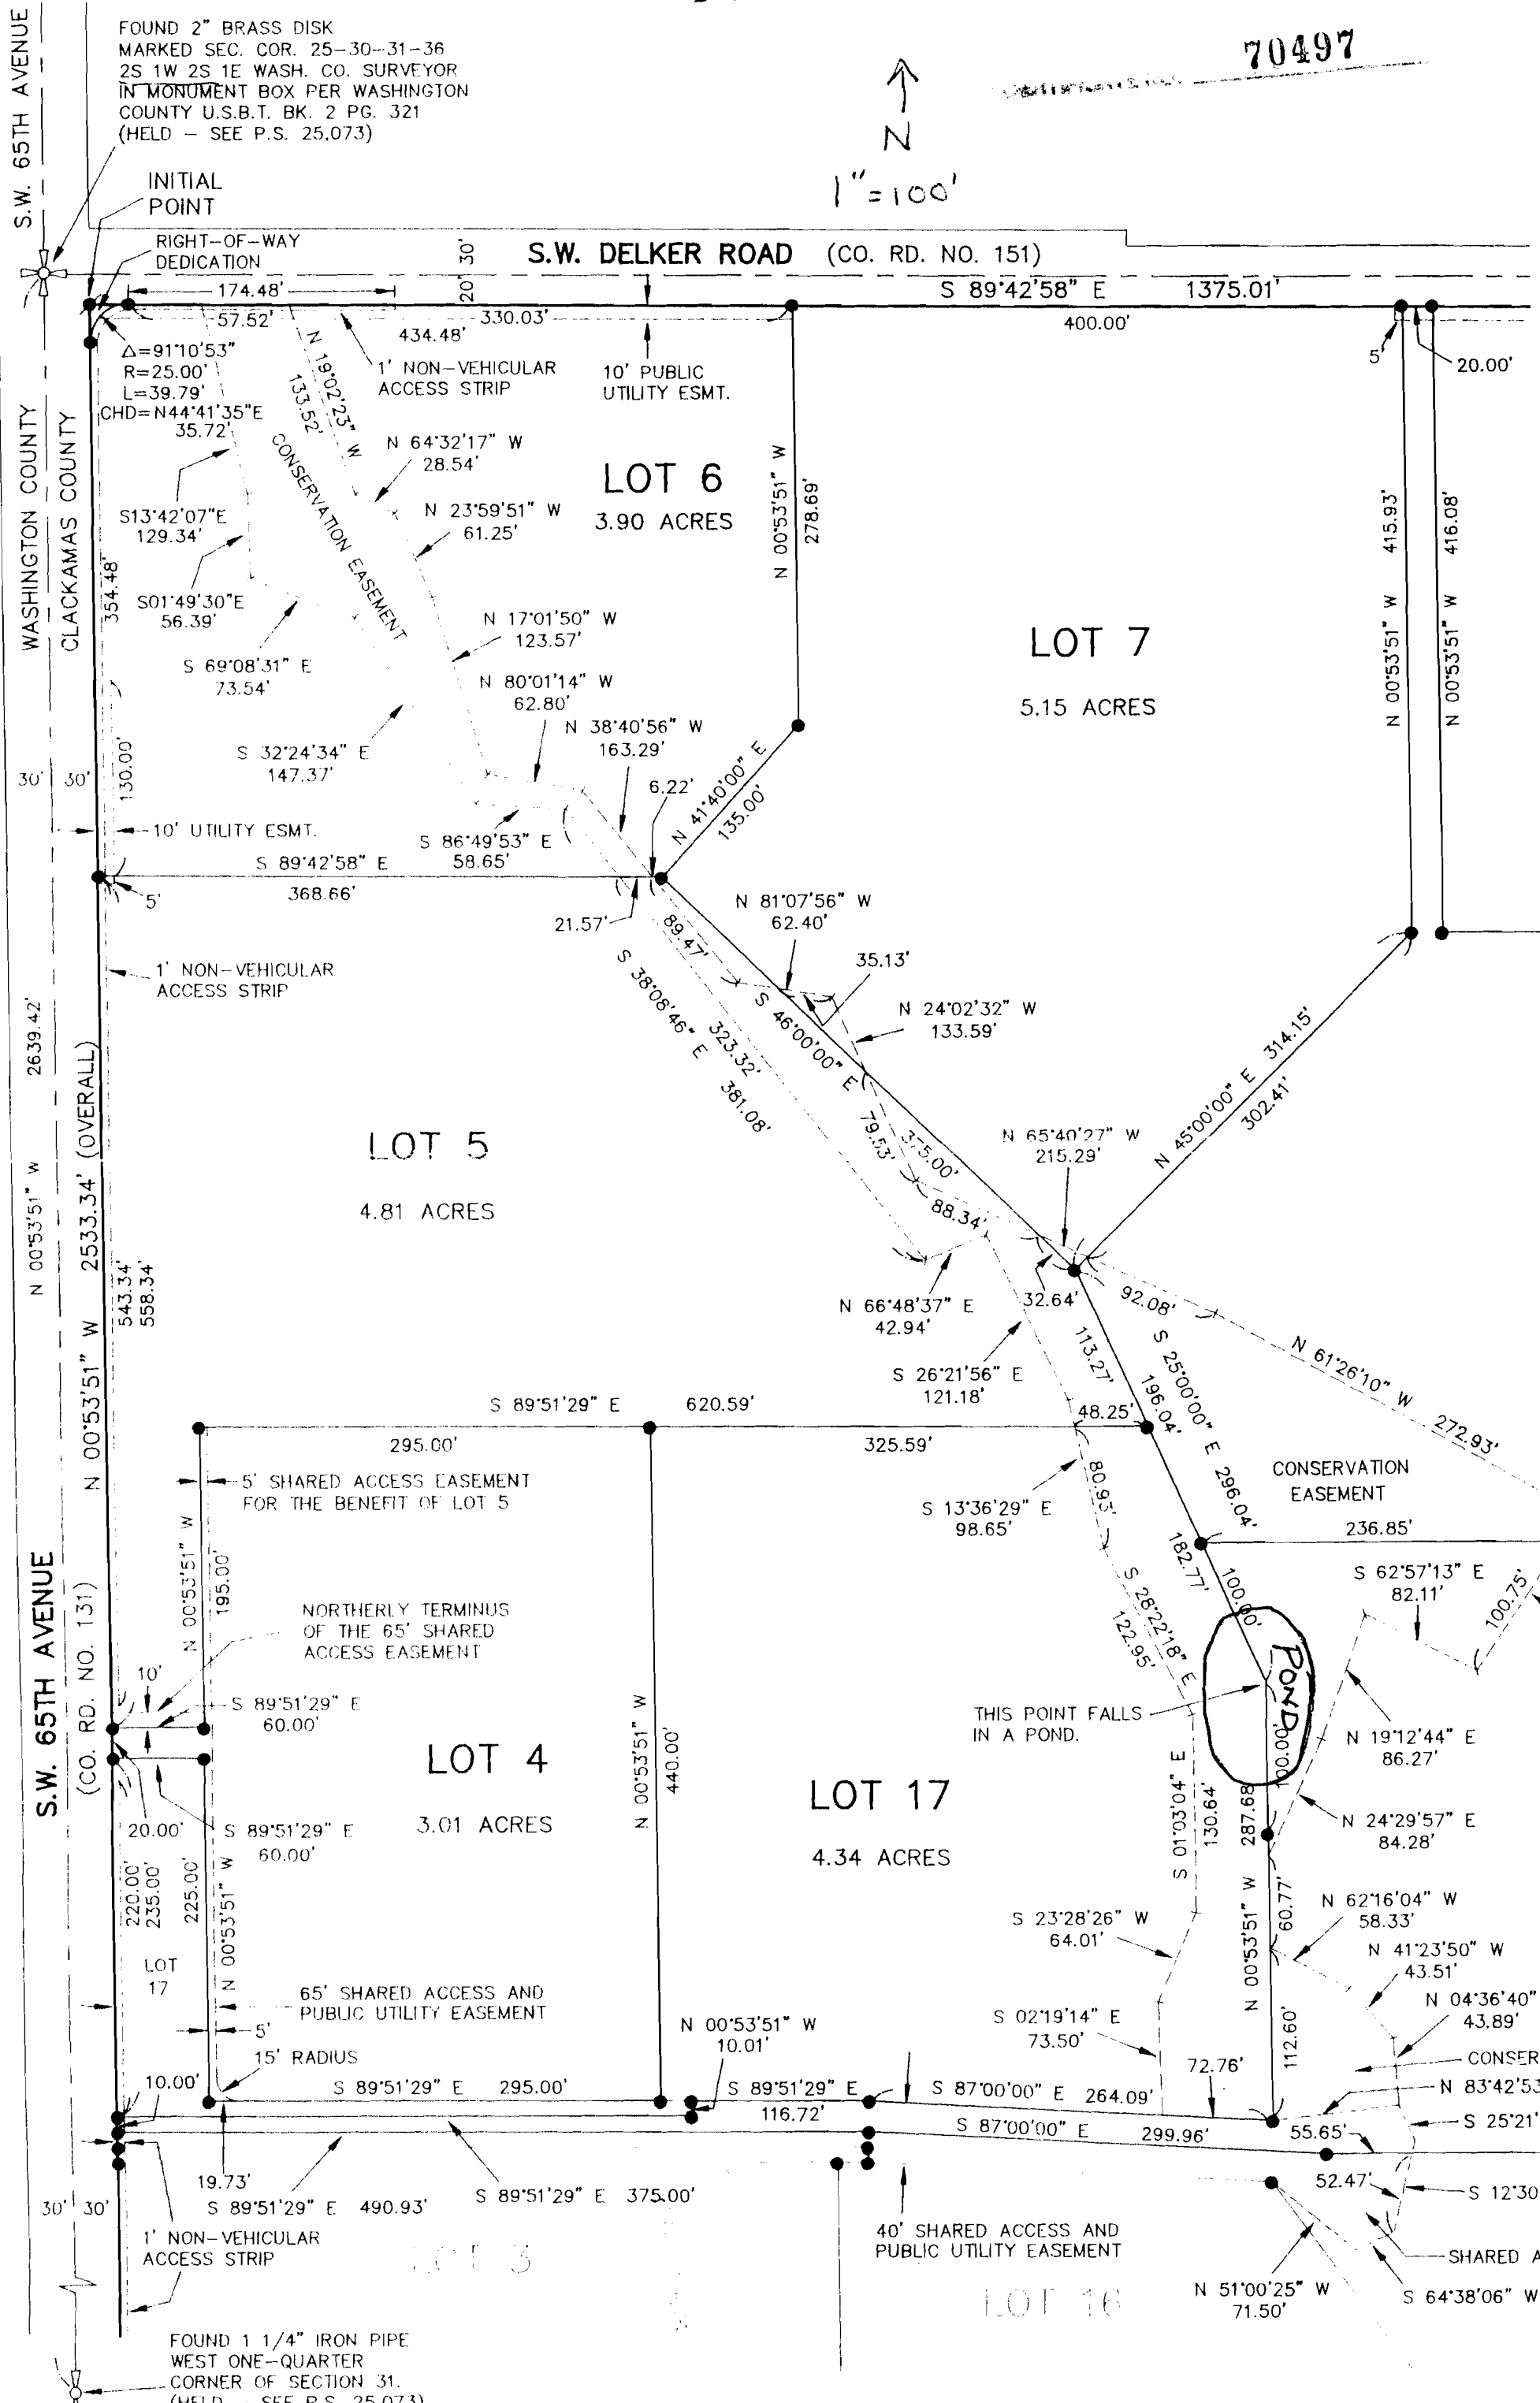


70497

FOUND 2" BRASS DISK
MARKED SEC. COR. 25-30-31-36
2S 1W 2S 1E WASH. CO. SURVEYOR
IN MONUMENT BOX PER WASHINGTON
COUNTY U.S.B.T. BK. 2 PG. 321
(HELD - SEE P.S. 25,073)

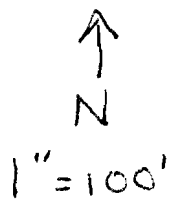

FOUND 1 1/4" IRON PIPE
WEST ONE-QUARTER
CORNER OF SECTION 31.
(HELD - SEE P.S. 25,073)