

CERTIFICATE OF SURVEYOR

I, Michael Spears of Canyon City Oregon do hereby certify
 that this map was made from notes taken during an actual survey made by me
 on Feb 11th 1910 and that it correctly
 represents the works described in the accompanying application, together with the location of streams and
 other ditches in the immediate vicinity and has written thereon the area in each smallest legal subdivision which
 it is proposed to irrigate

Michael Spears

Surveyor

Application #420

Enl. Permit # 33.


Lands colored Red are irrigated by Old Ringsbyes Ditch

Lands colored green. to be irrigated by diversion

Head of Diversion. is South 4.25ch and East 37.80ch of
 North West Corner Sec 34 Twp 12 S R 26 E

Feb 11th 1910

Plat of H B Hayes Extension, Dayville Oregon

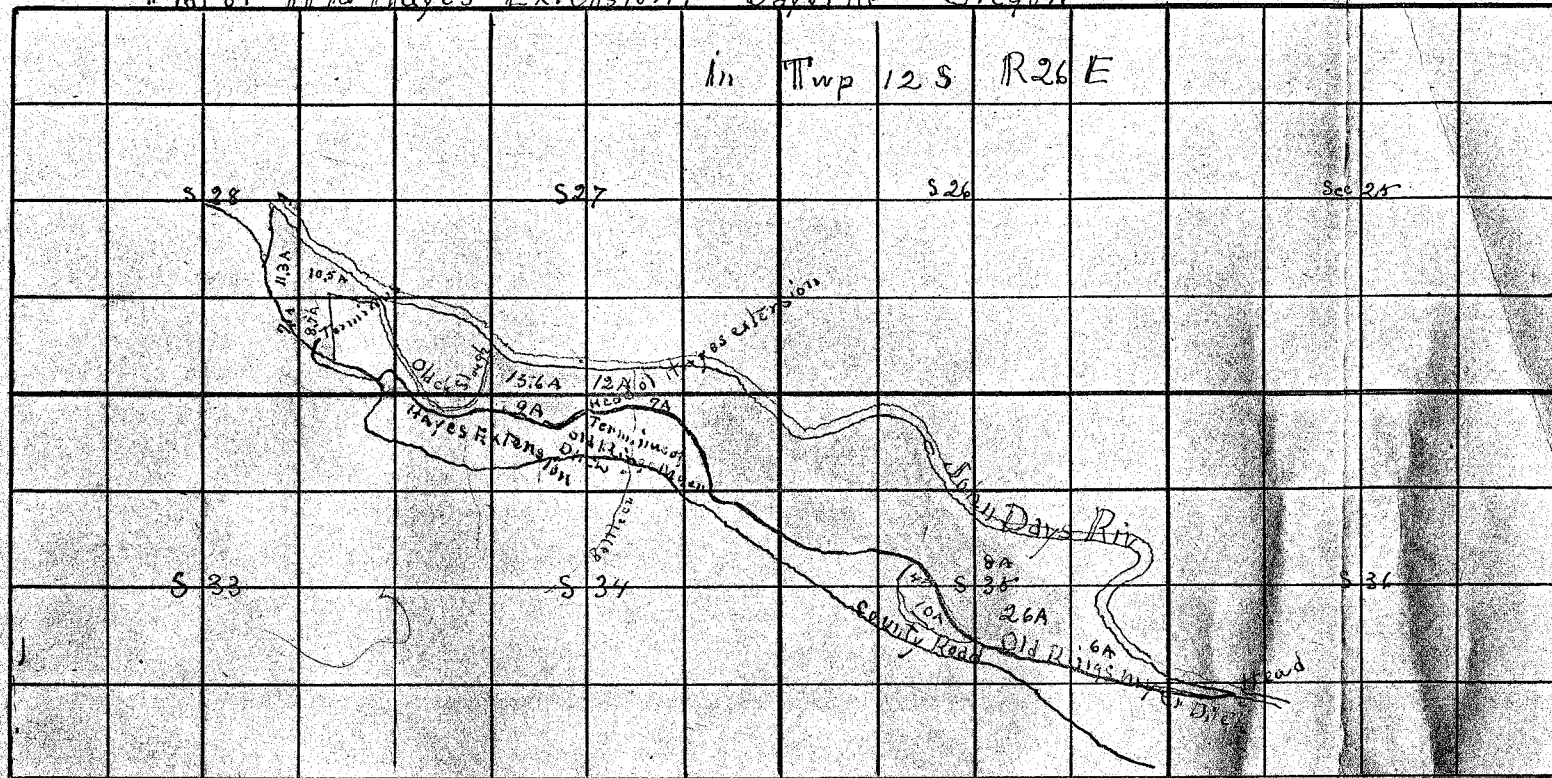

CERTIFICATE OF SURVEYOR

I, Michael Spears of Canyon City Oregon do hereby certify that this map was made from notes taken during an actual survey made by me on Feb 12th 1910 and that it correctly represents the works described in the accompanying application, together with the location of streams and other ditches in the immediate vicinity and has written thereon the area in each smallest legal subdivision which it is proposed to irrigate

Michael Spears
Surveyor

Application # 420
Enl. Permit # 33. Lands colored Red are irrigated by Old Rhymsmyer Ditch
Lands colored green, to be irrigated by diversion
Head of Diversion, is South 4.25 ch and East 37.80 ch of