

T. 41 S., R. 12 W. W.M.


RECEIVED

JAN - 3 1995

WATER RESOURCES DEP.
SALEM, OREGON

Application No. *R-76578*
Permit No.

"CERTIFICATE NO. 72508"

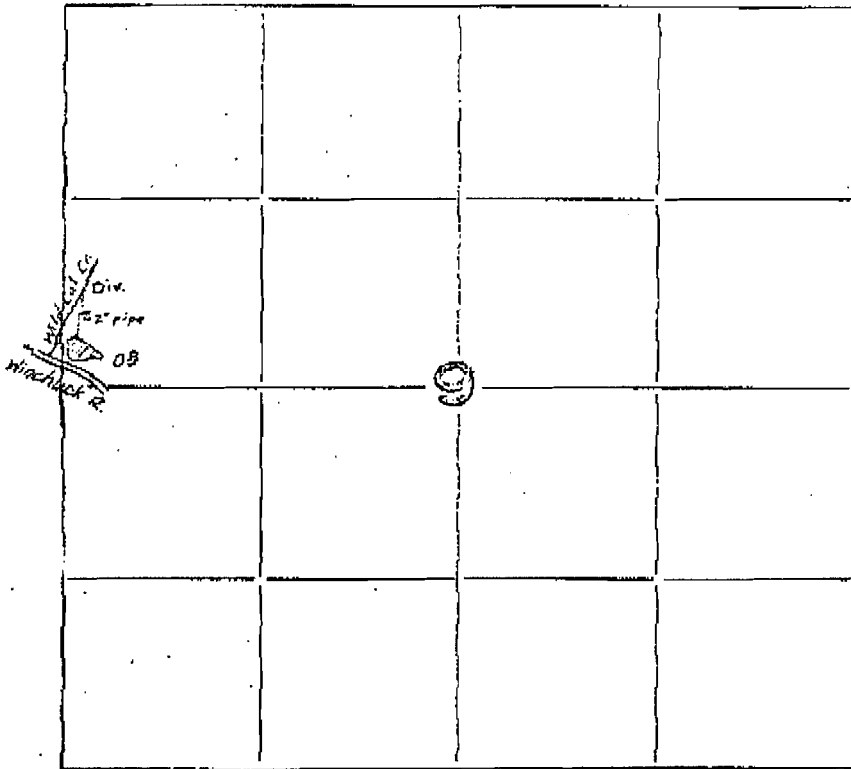

FINAL PROOF SURVEY
UNDER

Application No. 16395 Permit No. 12196

IN NAME OF

J. W. Gilmore

Surveyed June 11, 1941, by C. A. Cummings

Map prepared by Leslie Anderson
1942

No Final Proof Map available

No Permit Map available