


26 4 36

*CERTIFICATE NO. 70512

1"-400'

Application No. *R-76582*
Permit No.

SEE MAP 26 4 25

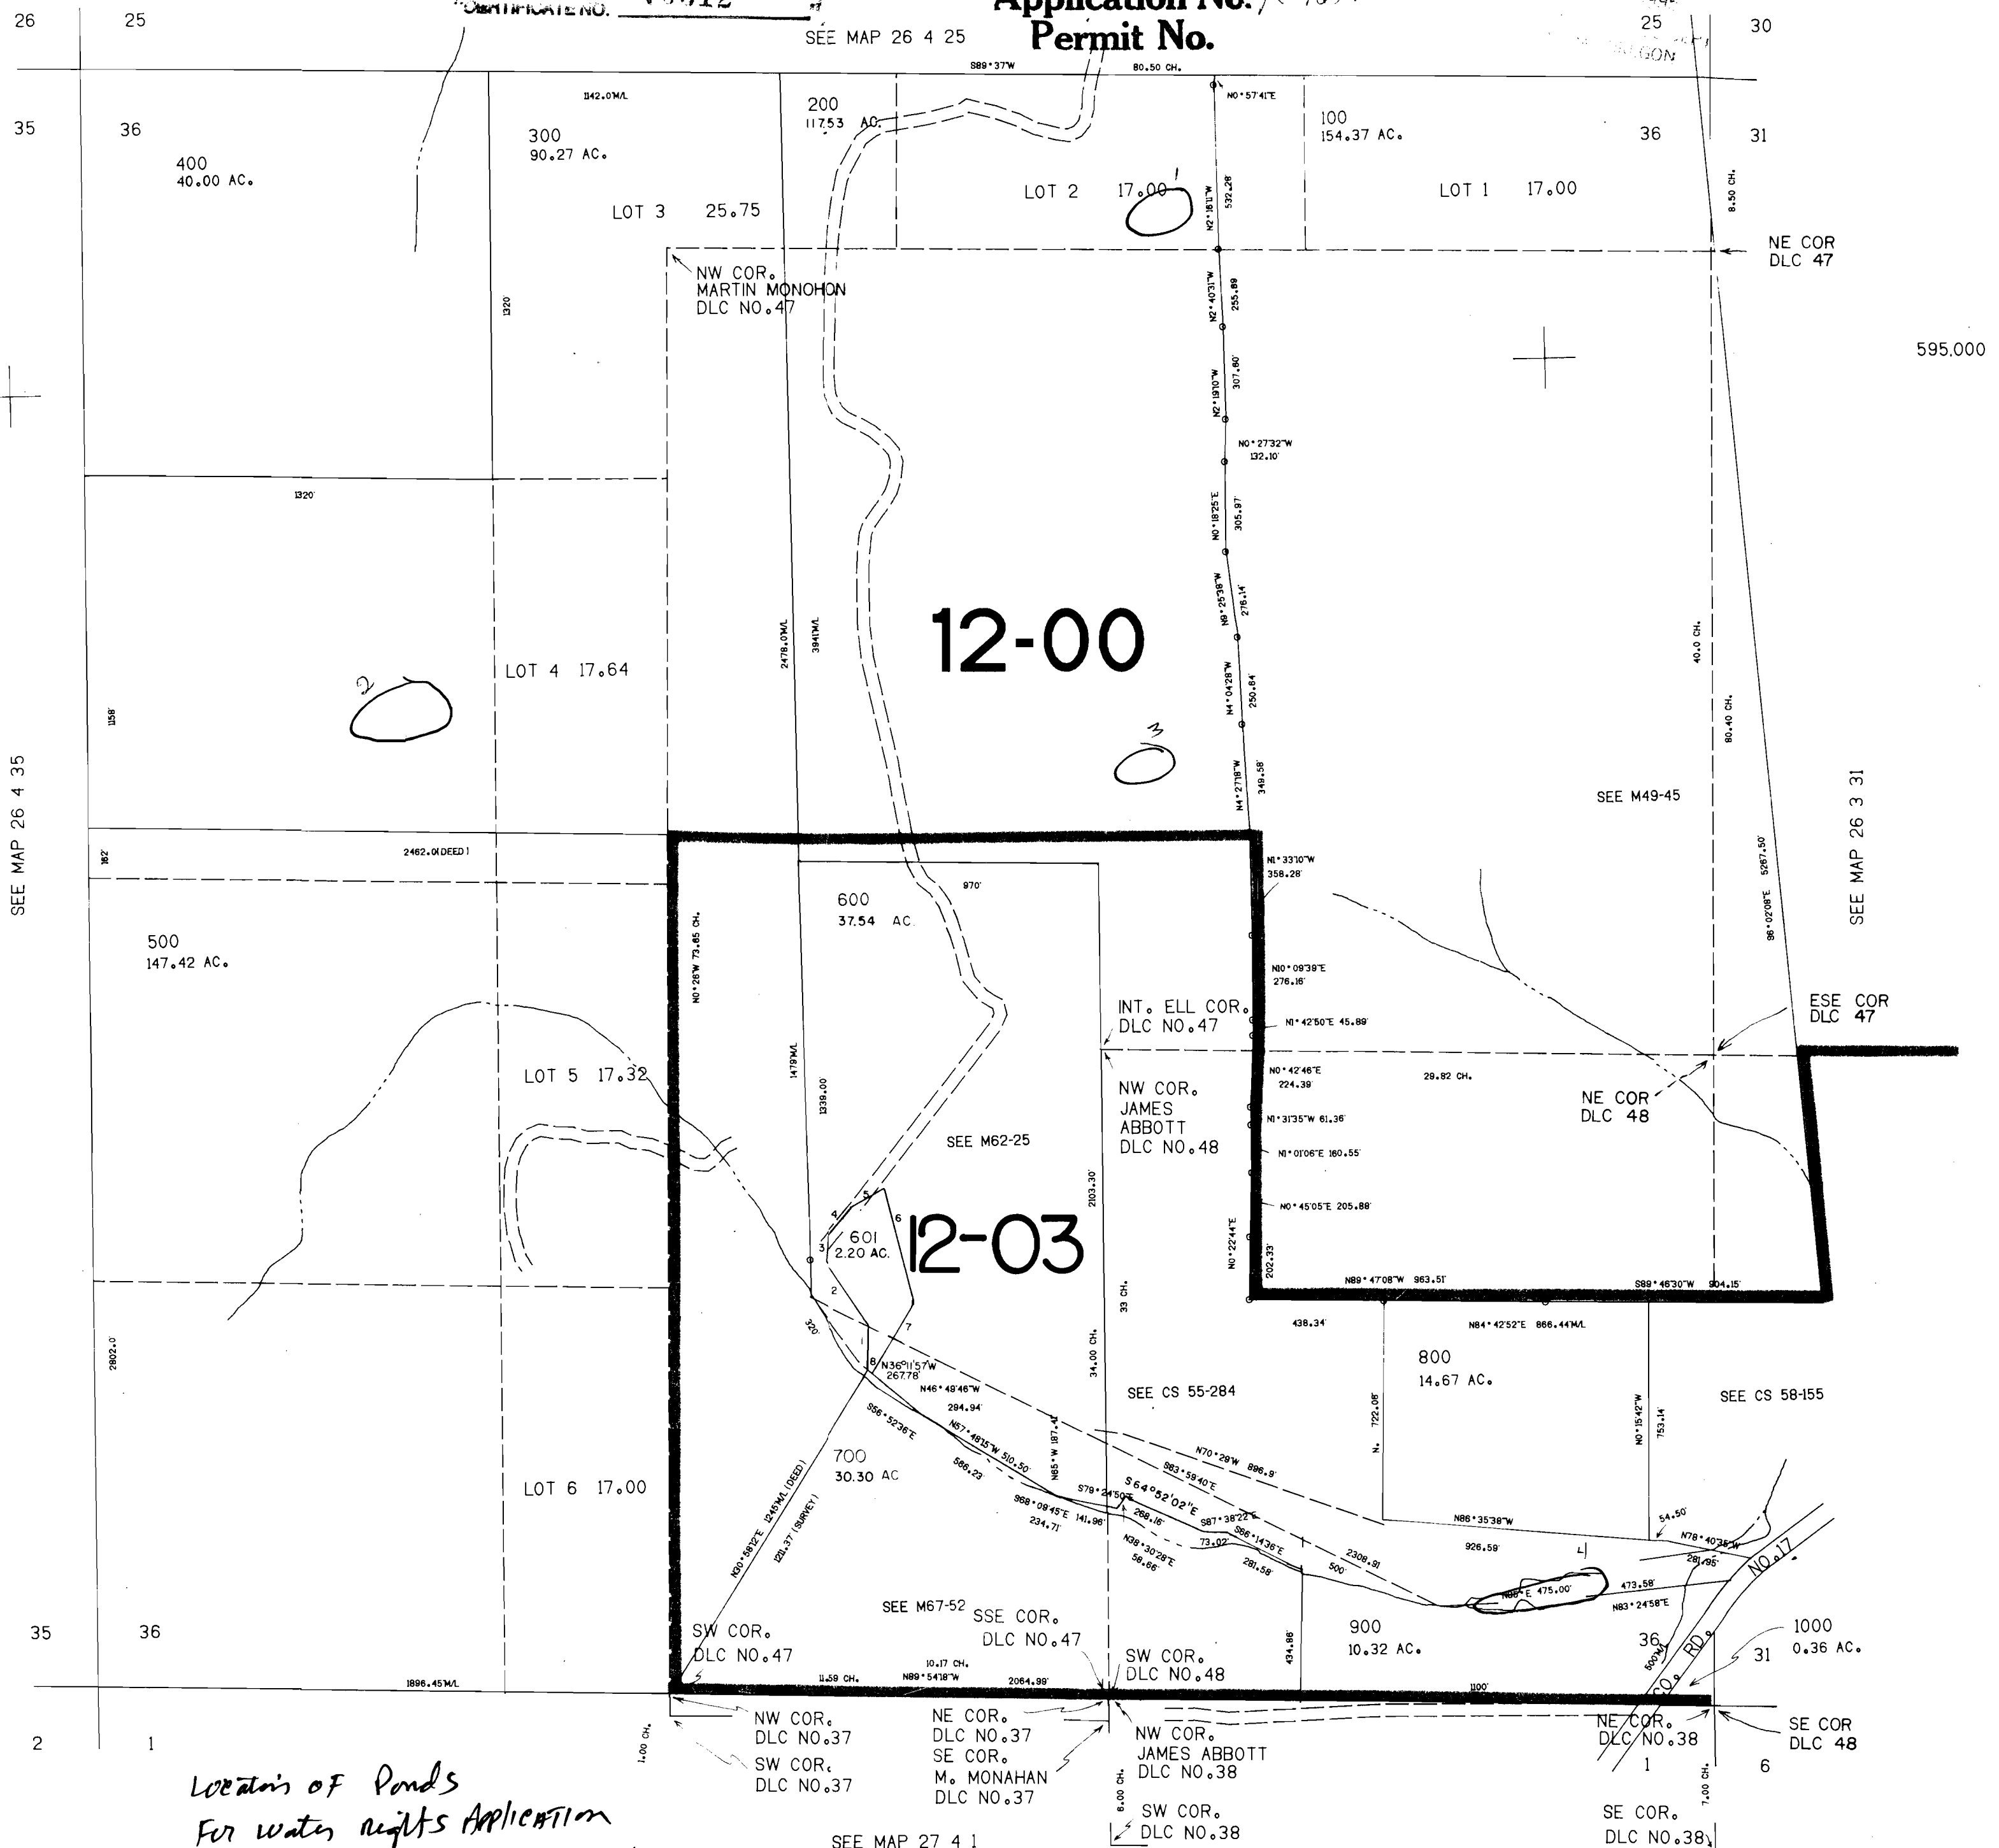

Location of Ponds
For water rights Application
For Daniel R VanSlyke
11492 Buckhorn Rd
Blide AZ 87443

26 4 36

No Final Proof Map available

No Permit Map available